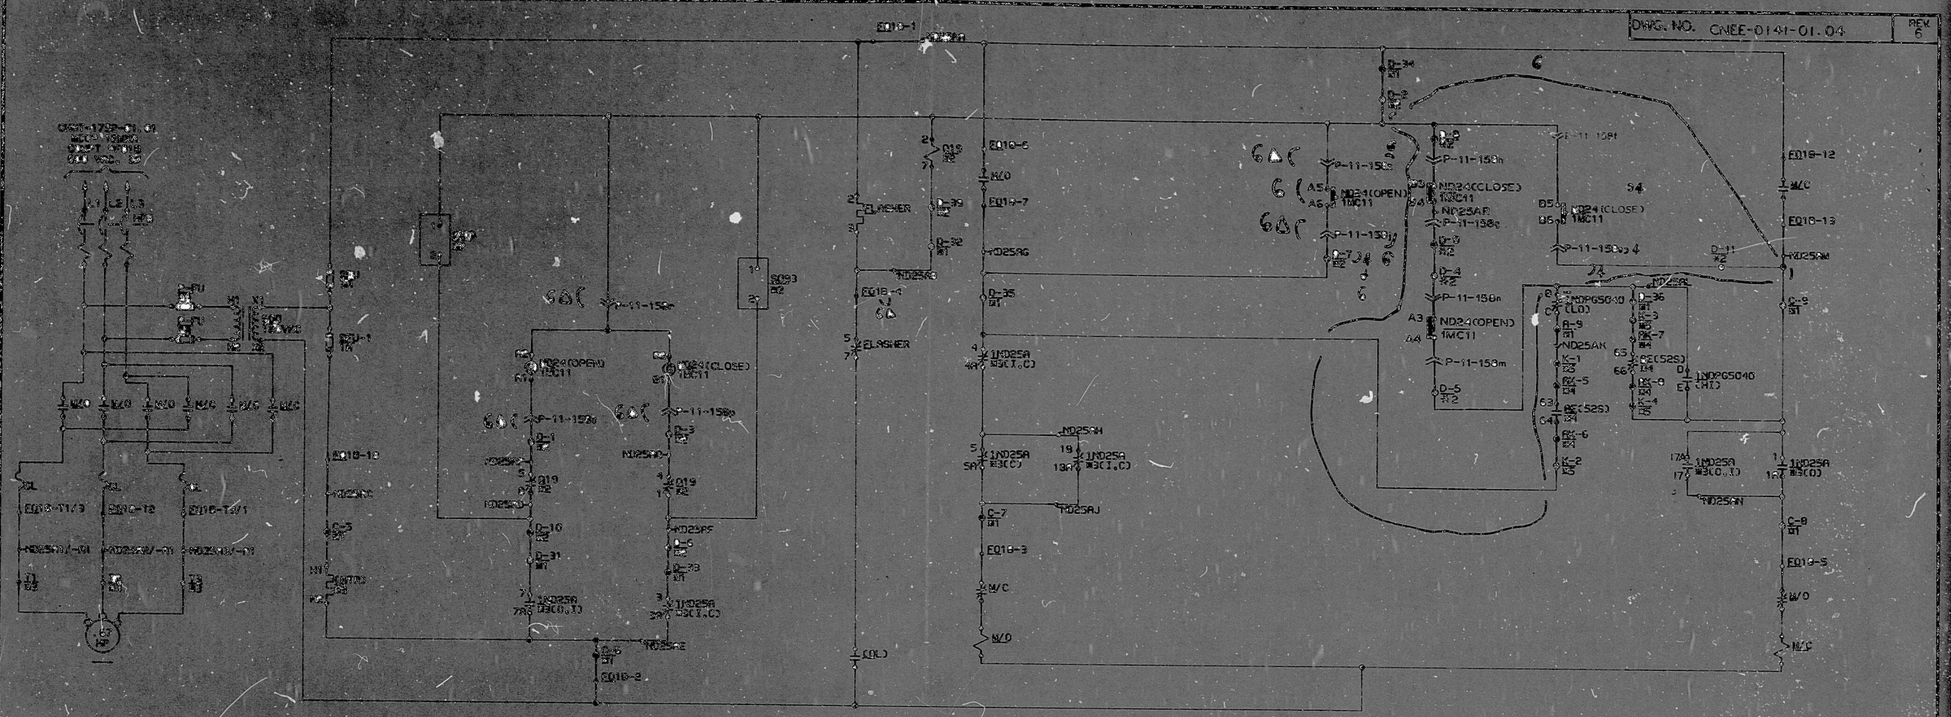
DWG. NO. CNEE-0141-01.04
REV 6
"REFERENCE ONLY"
REF DWG
CNM-1395.09-1 SH 205 — VL MFR W/D
CNM-1205.01-26 SH 102 — VL O/L & B/M
CNM-1205.01-56 — VL W/D
CNM-1205.01-57 — VL O/L
CNM-1711-11.01 — 1MC11 O/L
CNM-1711-11 SH 51 — 1MC11 WIRE TAG
CNM-1713-04.01.02 — 1TC C/D
CNM-1717-01.07 — 1EATC7 W/T
CNM-1205.01-54 — VL B/M
CNM-1799-02.04 — 1ND25A WIRE TAG
CNM-1914.01-0010 — MCC W/C
CNMT-1751-05.09 — 1ETA9 W/T
CNMT-1717-01.14 — 1EATC14W/T
ND24/1MC11 E30JY5-20.R3 MOMENTARY
TOP
BOTTOM
CONTACT
OPEN
CLOSE
FUNCTION
M/O,M/C
M/O
M/C
X-DENOTES CLOSED CONTACT
ERPHAG
FUNCTION
M/C
PRO APERTURE CARD

RIDS

8306240133

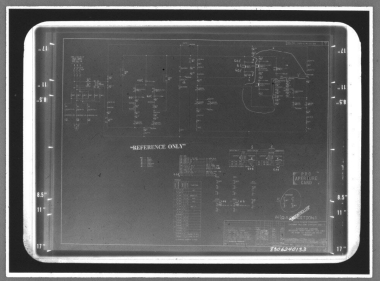

MMM 5824 — FILMSORT® Brand Aperture & Camera Cards and DUPLICARD® Brand Copy Cards — Product of 3M Company, St. Paul, Minn.