


99090-W

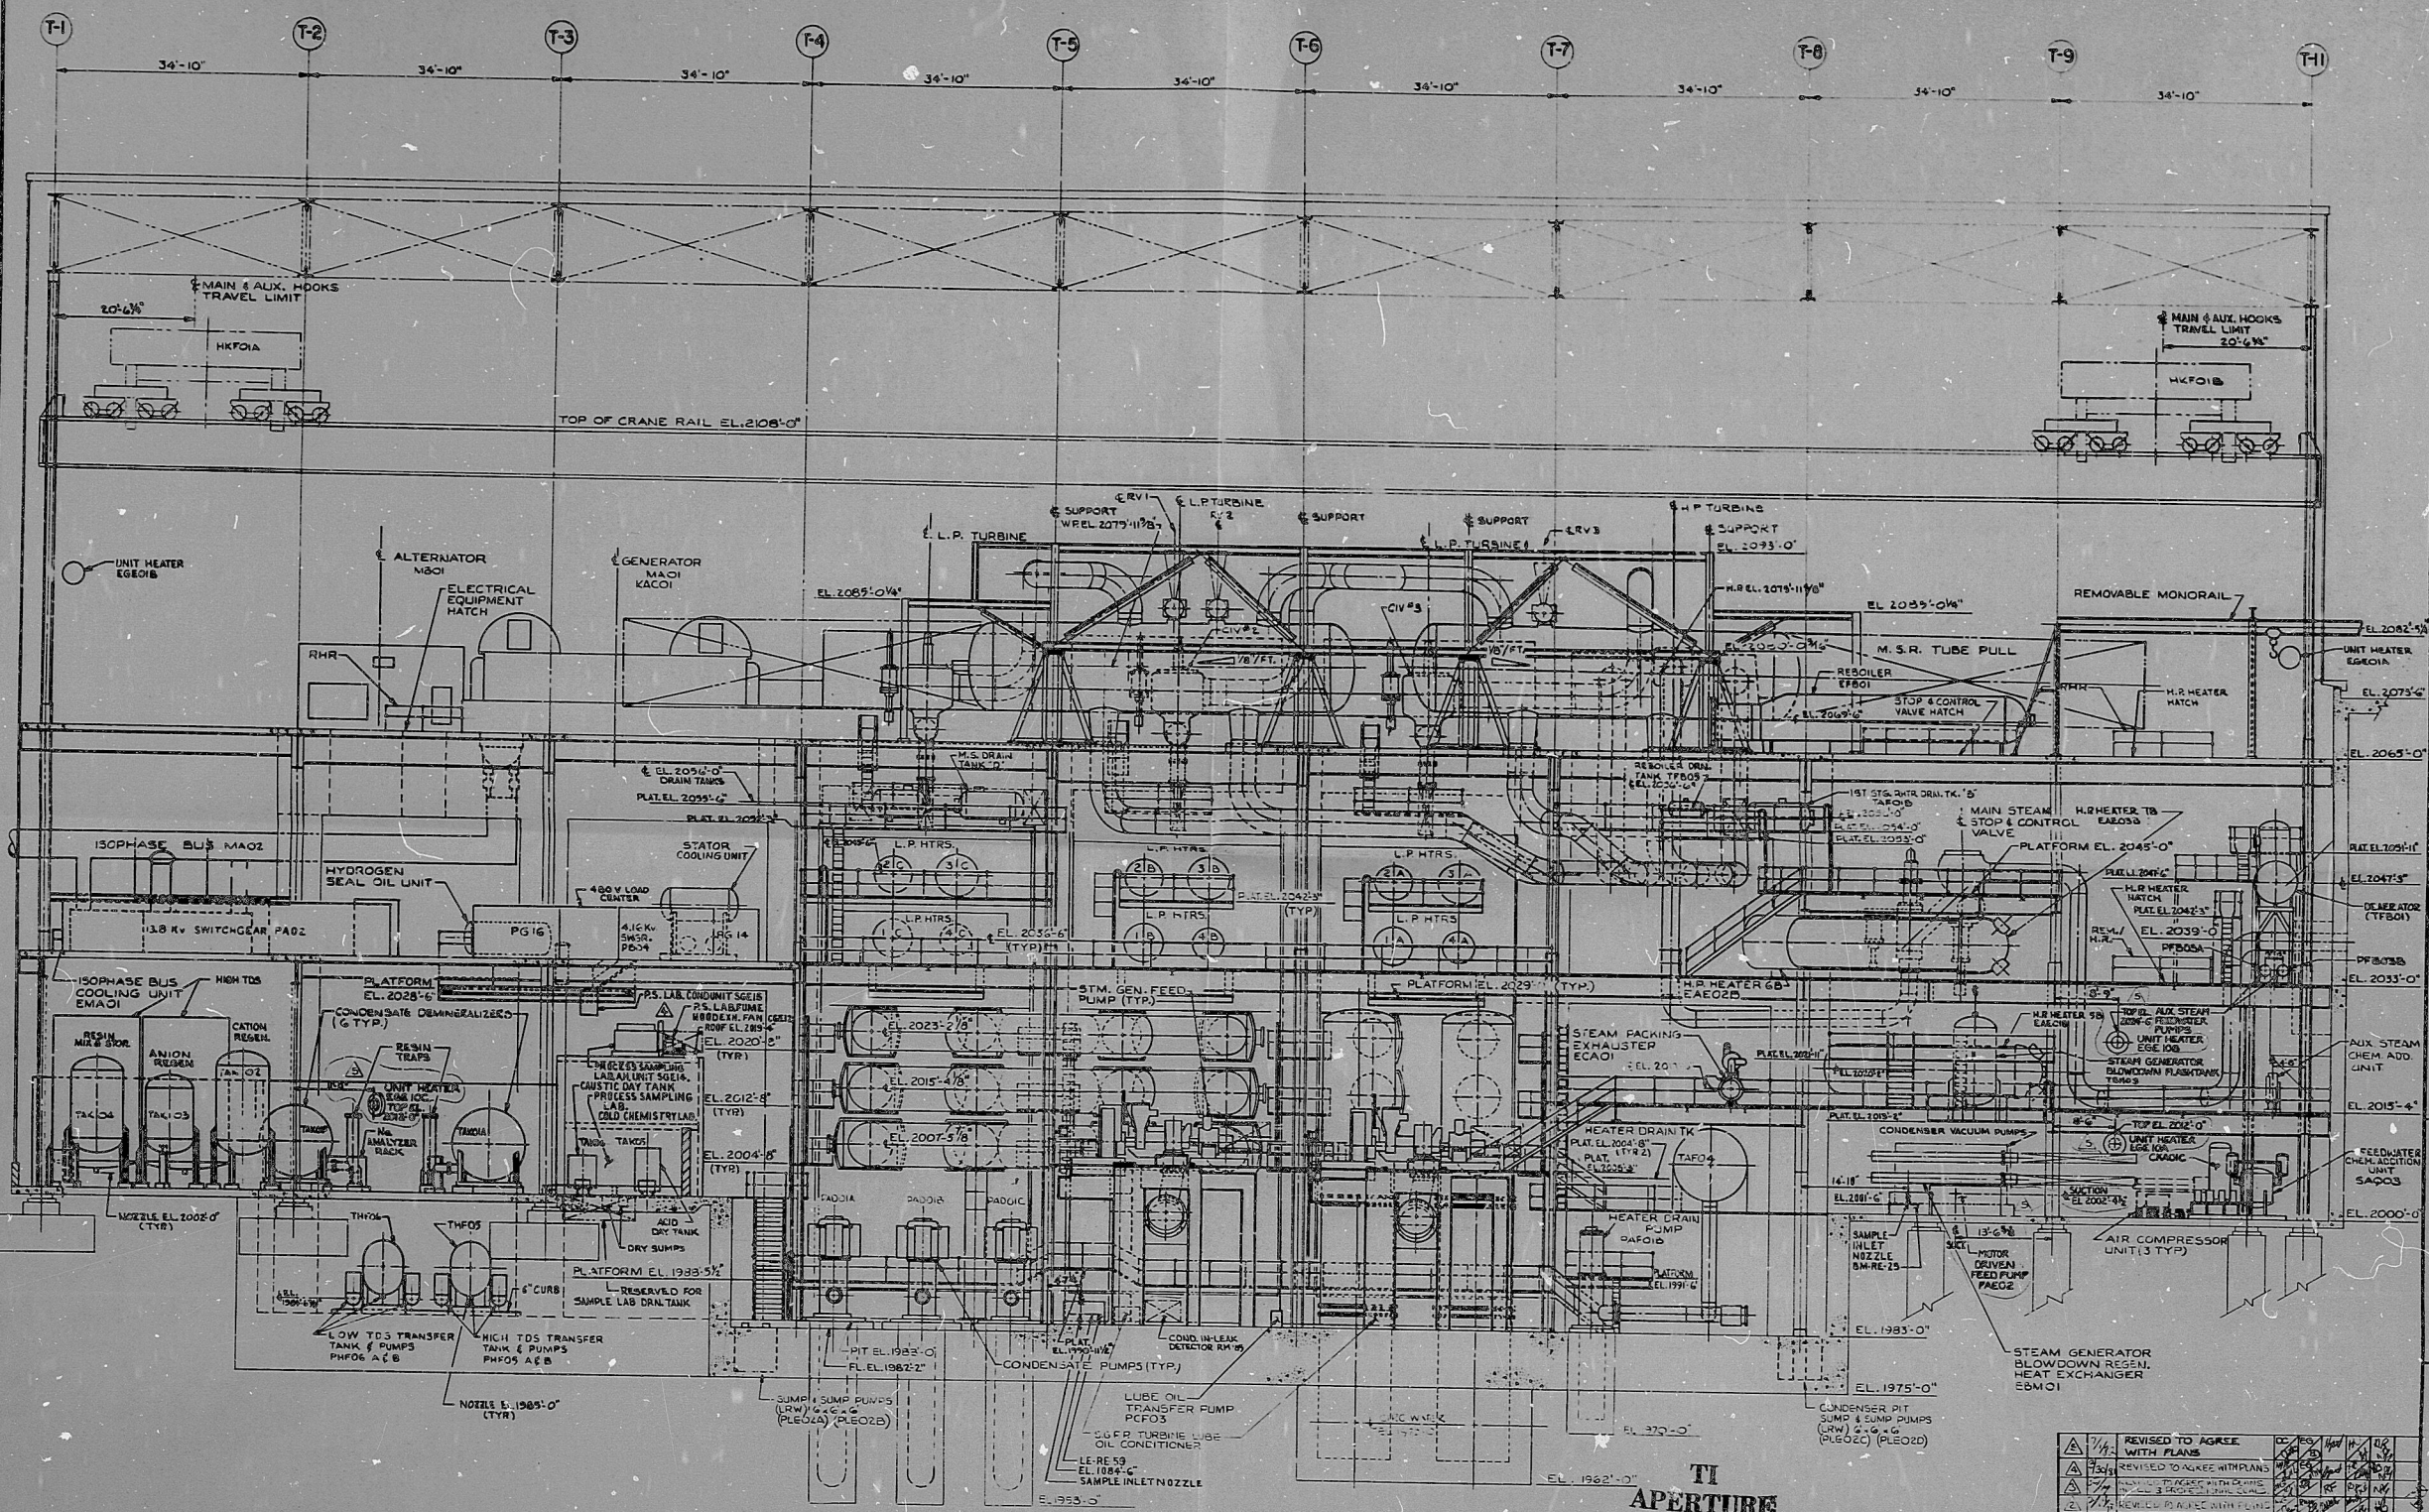

This drawing and the design it covers is the property of the United States Government and is loaned to the licensee of the licensee's contract. It is to be used only for the purposes for which it was prepared, and is not to be reproduced, established, or used except in the limited way and under the conditions specified in the contract.

SECTION B  
 LOOKING EAST M-0606  
 (SEE DWG'S. M-0606  
 THRU M-0606A)

NO.	DATE	REVISIONS	BY	CHK	APP
1					
2					
3					
4					
5					

COORDINATION SIGN-OFF  
 M-0606  
 THE UNDERSIGNED HEREBY DISCLAIMS ANY RESPONSIBILITY FOR ANY PLANS, SPECIFICATIONS, ESTIMATES, REPORTS, DRAWINGS OR OTHER DOCUMENTS, OR INSTRUMENTS RELATING TO OR INTENDED TO BE USED FOR ANY PART OR PARTS OF THE ENGINEERING PROJECT FOR WHICH THIS DOCUMENT IS ISSUED. THE UNDERSIGNED IS NOT TO BE USED FOR ANY OTHER PROJECT OR INSTRUMENTS UNLESS THE SIGNATURE AND SEAL OF THE UNDERSIGNED IS APPLIED.

REVIEW LEVEL 1

NO.	DATE	REVISIONS	BY	CHK	APP
1					
2					
3					
4					
5					

SCALE 1/8"=1'-0" (DATE 4/23/75) (DESIGNED) (DRAWN) (J.P.)  
**BECHTEL**  
 GAITHERSBURG, MARYLAND  
**SNUPPS**  
 EQUIPMENT LOCATION  
 TURBINE BUILDING  
 SECTION "B"  
 UTILITY DRAWING NO. 10465  
 BECHTEL DRAWING NO. M-06066  
 SHEET NO. 5

I certify that the design contained on this drawing was made in the normal and regular course of business, on the date stated below and that it is an accurate representation of the work done by me or under my supervision.  
 DATE 4/23/75 OPERATOR [Signature] SUPERVISOR [Signature]

30 X

8410090055

PDR RIDS

