


SCALING RULES


SIZE E

E-01NBO1 (Q)

- NOTES**
- FOR GENERAL NOTES, SYMBOLS AND EQUIPMENT LOCATION INDEX SEE DWG. 10466-E-01006.
  - FOR PROTECTIVE RELAY FUNCTIONS SEE LOGIC DIAGRAM 10466-E-01001 THROUGH 004.
  - EQUIPMENT RELAY CAN BE SUBSTITUTED IF NECESSARY.
  - THE FAULT PRESSURE RELAY WILL ALARM BY 1 OUT OF 2 LOGIC AND TRIP ON 2 OUT OF 2 LOGIC.
  - DELETED
  - DELETED
  - CABLES DENOTED BY -S- ARE SEPARATION GROUP 5. ALL OTHER CABLES ON THIS DIAGRAM ARE SEPARATION GROUP 1, EXCEPT AS OTHERWISE NOTED.
  - TWO LOCKOUT RELAYS IN PARALLEL ARE PROVIDED FOR EACH ESP STAGE, ONE TO TRIP SEPARATION GROUP 1 SWITCHGEAR AND ONE TO TRIP SEPARATION GROUP 4 SWITCHGEAR.
  - FOR MANUFACTURE, TYPE AND STYLE NUMBER OF ALL METERS AND LIGHTS ON MAIN CONTROL BOARD (RLO/S) SEE DWG. 10466-J-01016.
  - UNION & SITS - 1-750 MCM (TRIPLES)  
K&E SITE - 2-500 MCM (TRIPLES)
  - FOR STYLE NOS. OF DEVICE 86 AND 87, SEE DWG. BECTEL UP NO. E-008-006.
  - USE HAS HATT/VAR COMBINATION IOCR.
  - STYLE # R18-HV0P0R0C0-P0M0Z0A0I0.
  - DENOTED FOR K.3.#.2 ONLY.
  - DENOTED FOR U.E. ONLY.

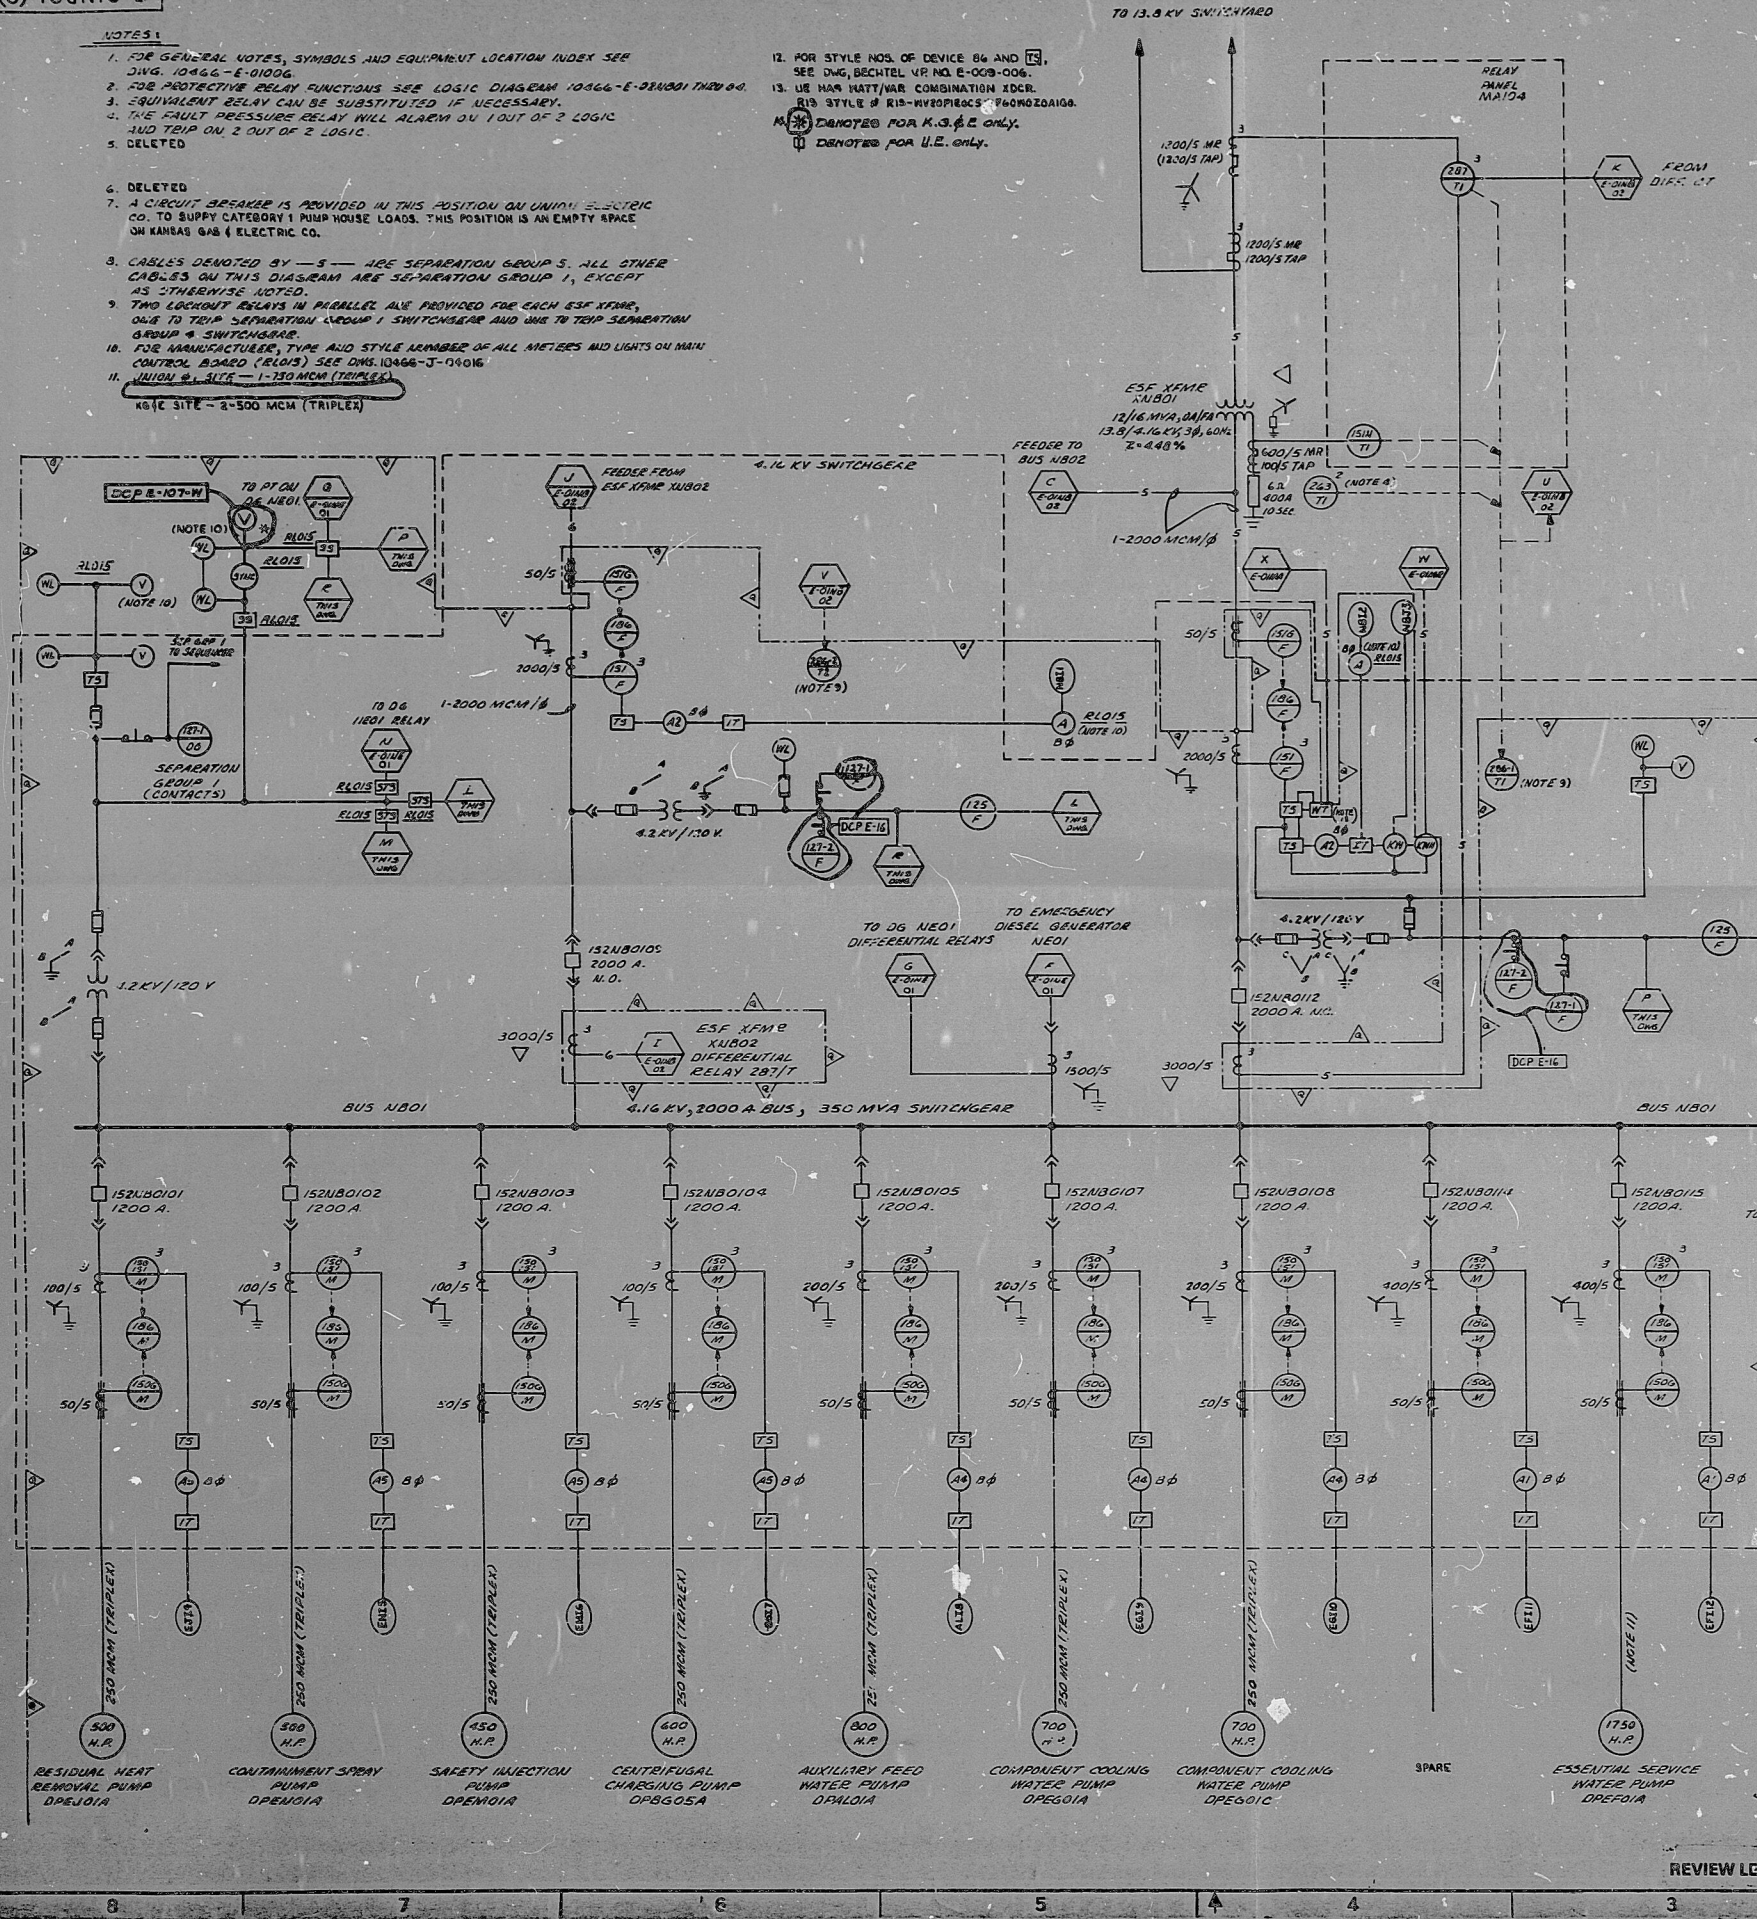

DEVICE	DESCRIPTION	MFR	TYPE	STYLE
50-151	MOTOR OVERCURRENT RELAY	GE	12AC33	12AC33A000A

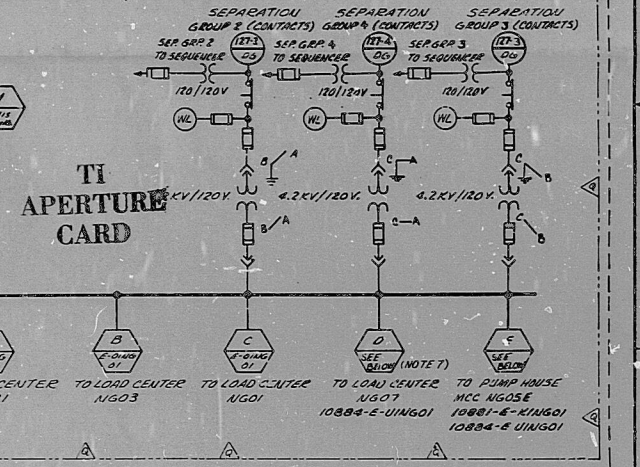

4	ABOVE 25 KV
3	25 KV
2	13.8 KV
1	4160 V
NO NUMBER	480 V & BELOW

THE FIRST DIGIT OF THE DEVICE NUMBER IS USED TO DESIGNATE VOLTAGE LEVEL

NOTICE: ALL INFORMATION ON THIS DOCUMENT IS UNCLASSIFIED EXCEPT WHERE SHOWN OTHERWISE. 

**BECTEL**  
GAITHERSBURG, MARYLAND

**SNUPPS**  
LOWER MEDIUM VOLTAGE SYSTEM  
CLASS I E 4.16 KV SINGLE LINE  
METER AND RELAY DIAGRAM

REVISIONS

NO.	DATE	REVISIONS
1	08/27/74	DESIGNED BY: [Signature]
2		CHECKED BY: [Signature]
3		APPROVED BY: [Signature]

JOB NO. 10466 E-01NBO1 (Q) 12

BECTEL DRAWING NO. 10466 E-01NBO1 (Q) 12

DATE 08/27/74


8410090091

**PDR RIDS**

