



SCALING RULES
E-OINB02(Q)

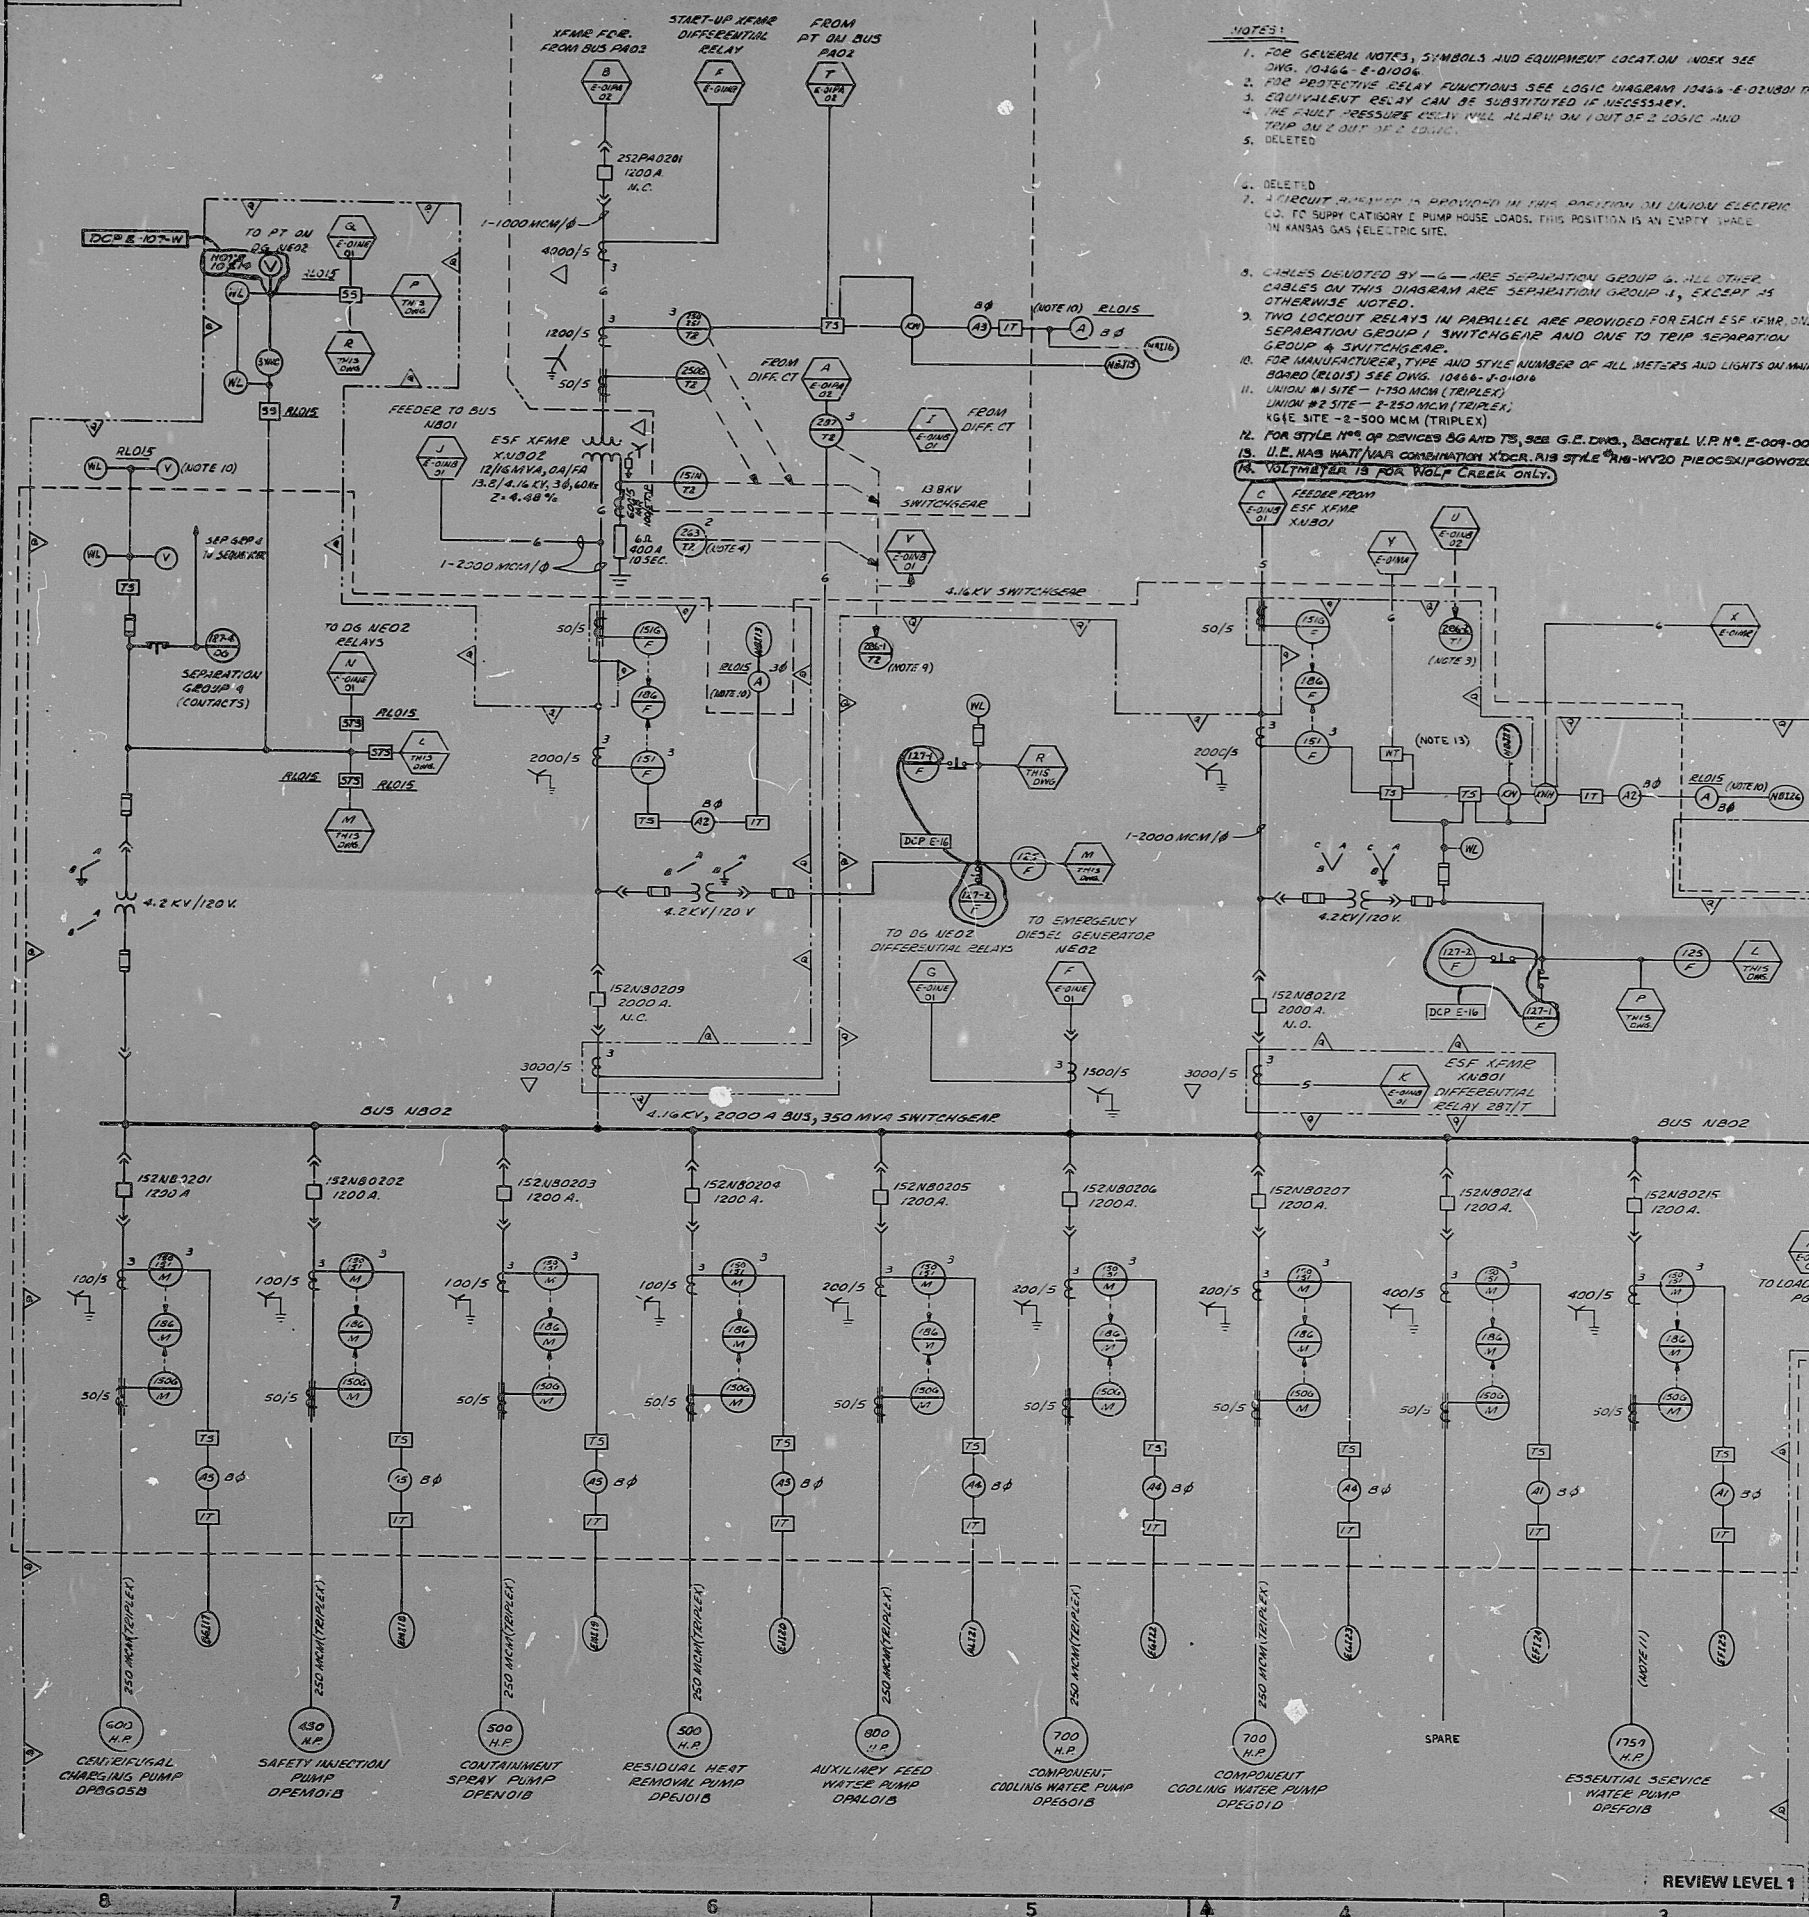

- NOTES:
- FOR GENERAL NOTES, SYMBOLS AND EQUIPMENT LOCATION INDEX SEE DWG. 10466-E-01004.
 - PROTECTIVE RELAY FUNCTIONS SEE LOGIC DIAGRAM 10466-E-01001 THRU 04.
 - EQUIVALENT RELAY CAN BE SUBSTITUTED IF NECESSARY.
 - DELETED.
 - CIRCUIT BREAKER IS PROVIDED IN THIS POSITION IN UNION ELECTRIC CO. TO SUPPLY CATEGORY E PUMP HOUSE LOADS. THIS POSITION IS AN EMPTY SPACE IN KANSAS GAS ELECTRIC SITE.
 - FOR MANUFACTURER, TYPE AND STYLE NUMBER OF ALL METERS AND LIGHTS ON MAIN CONTROL BOARD (RELAYS) SEE DWG. 10466-E-01001.
 - UNION #1 SITE - 1750 MCM (TRIPLEX)
 - U.C. HAS WATT/VAH COMBINATION XDCR. HIS STYLE # IS W-220 PIECE SKIP W02020100.


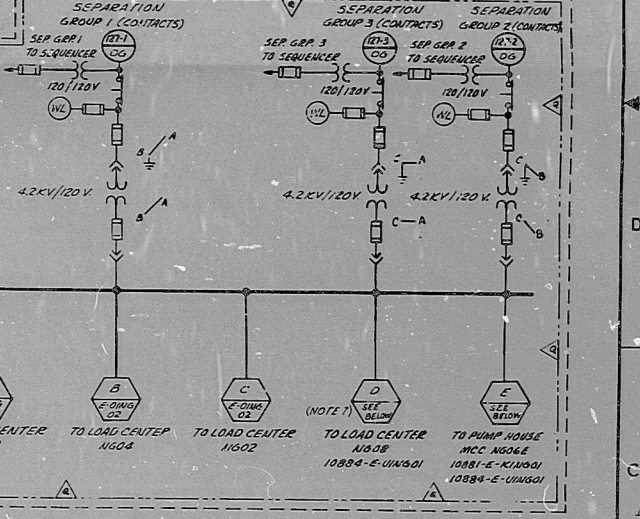

THE FIRST DIGIT OF DEVICE NUMBER IS USED TO DESIGNATE VOLTAGE

4	ABOVE 25KV
3	25 KV
2	13.8 KV
1	4160 V
NO NUMBER	480V & BELOW

REVIEW LEVEL 1

BECHTEL
GAITHERSBURG, MARYLAND

SNUPPS
LOWER MEDIUM VOLTAGE SYSTEM
CLASS I E 4.16 KV SINGLE LINE
METER AND RELAY DIAGRAM

10466 E-OINB02(Q) 12

DATE 8/1/74 DESIGNED BY JPM

17

8410090094

PDR RIDS

