

22"

17"

11"

8.5"

8.5"

11"

17"

22"

22"

17"

11"


8.5"

8.5"

11"

17"

22"

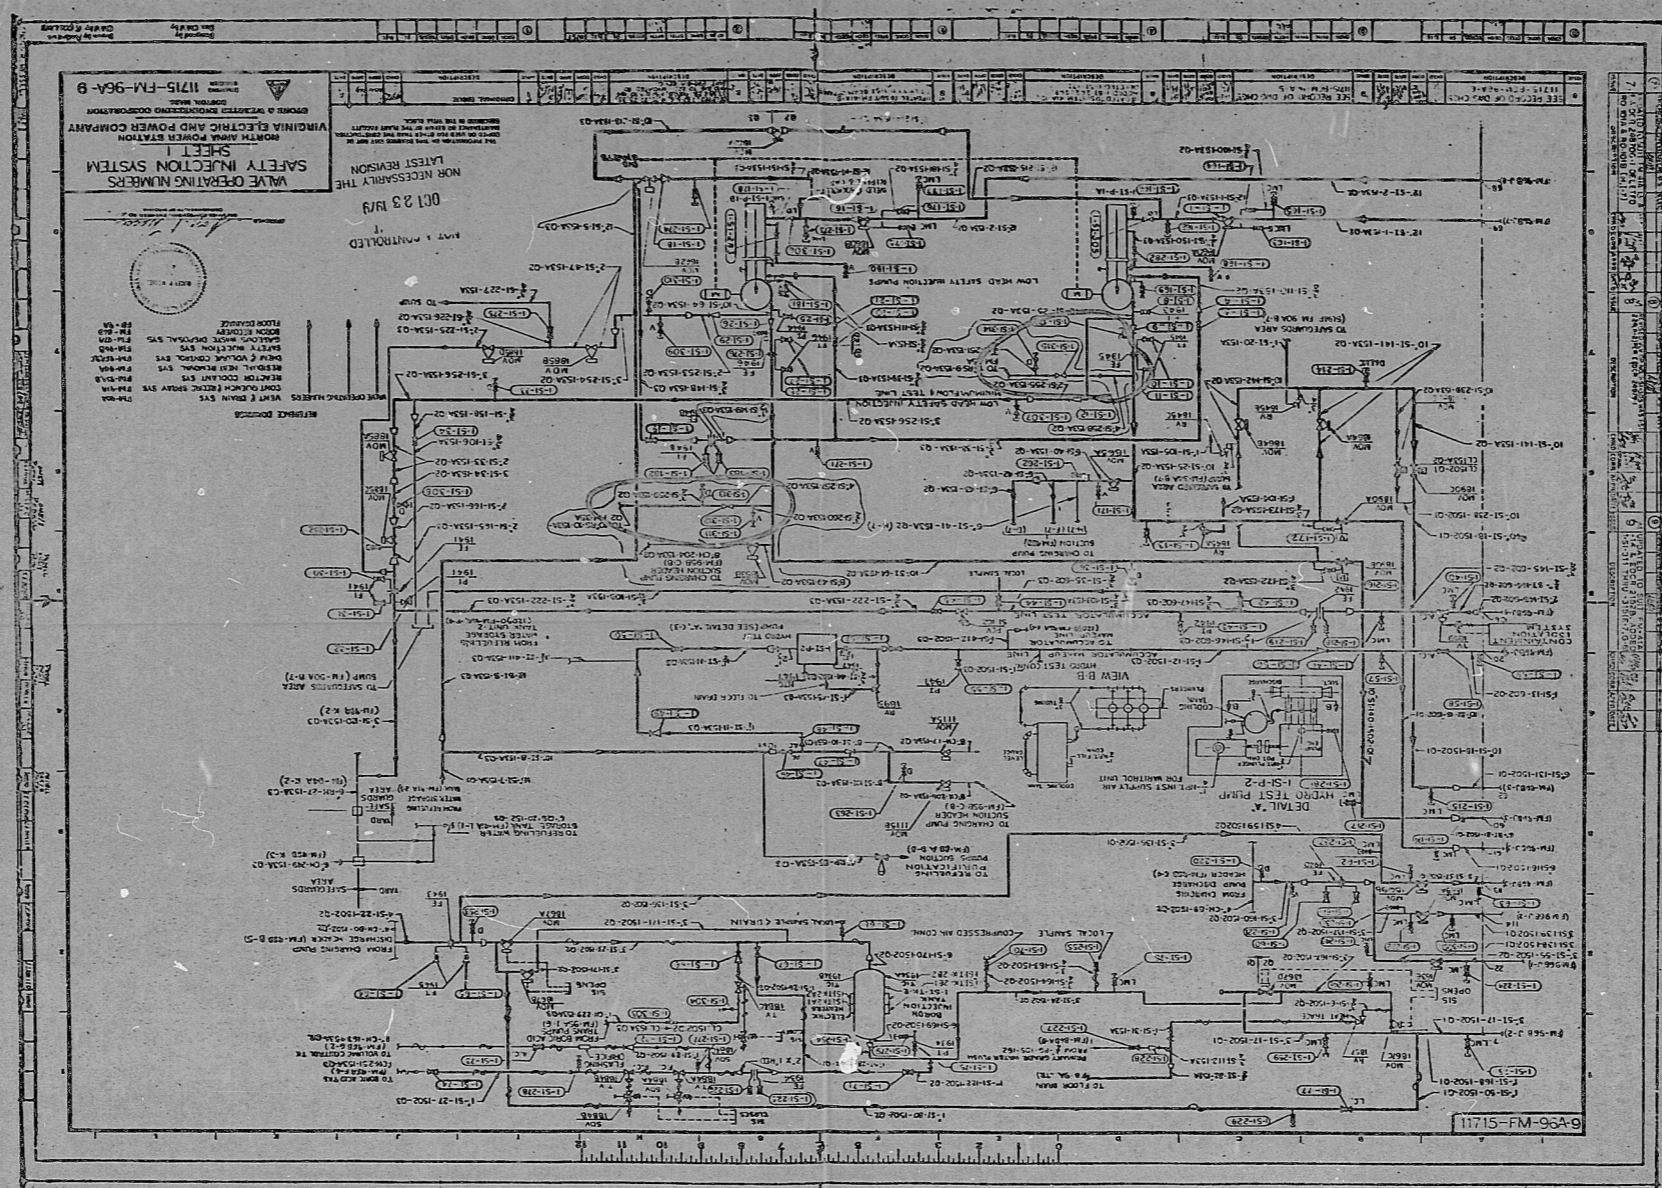

386
2101010

7910310386

