


SCALING RULES

SIZE E

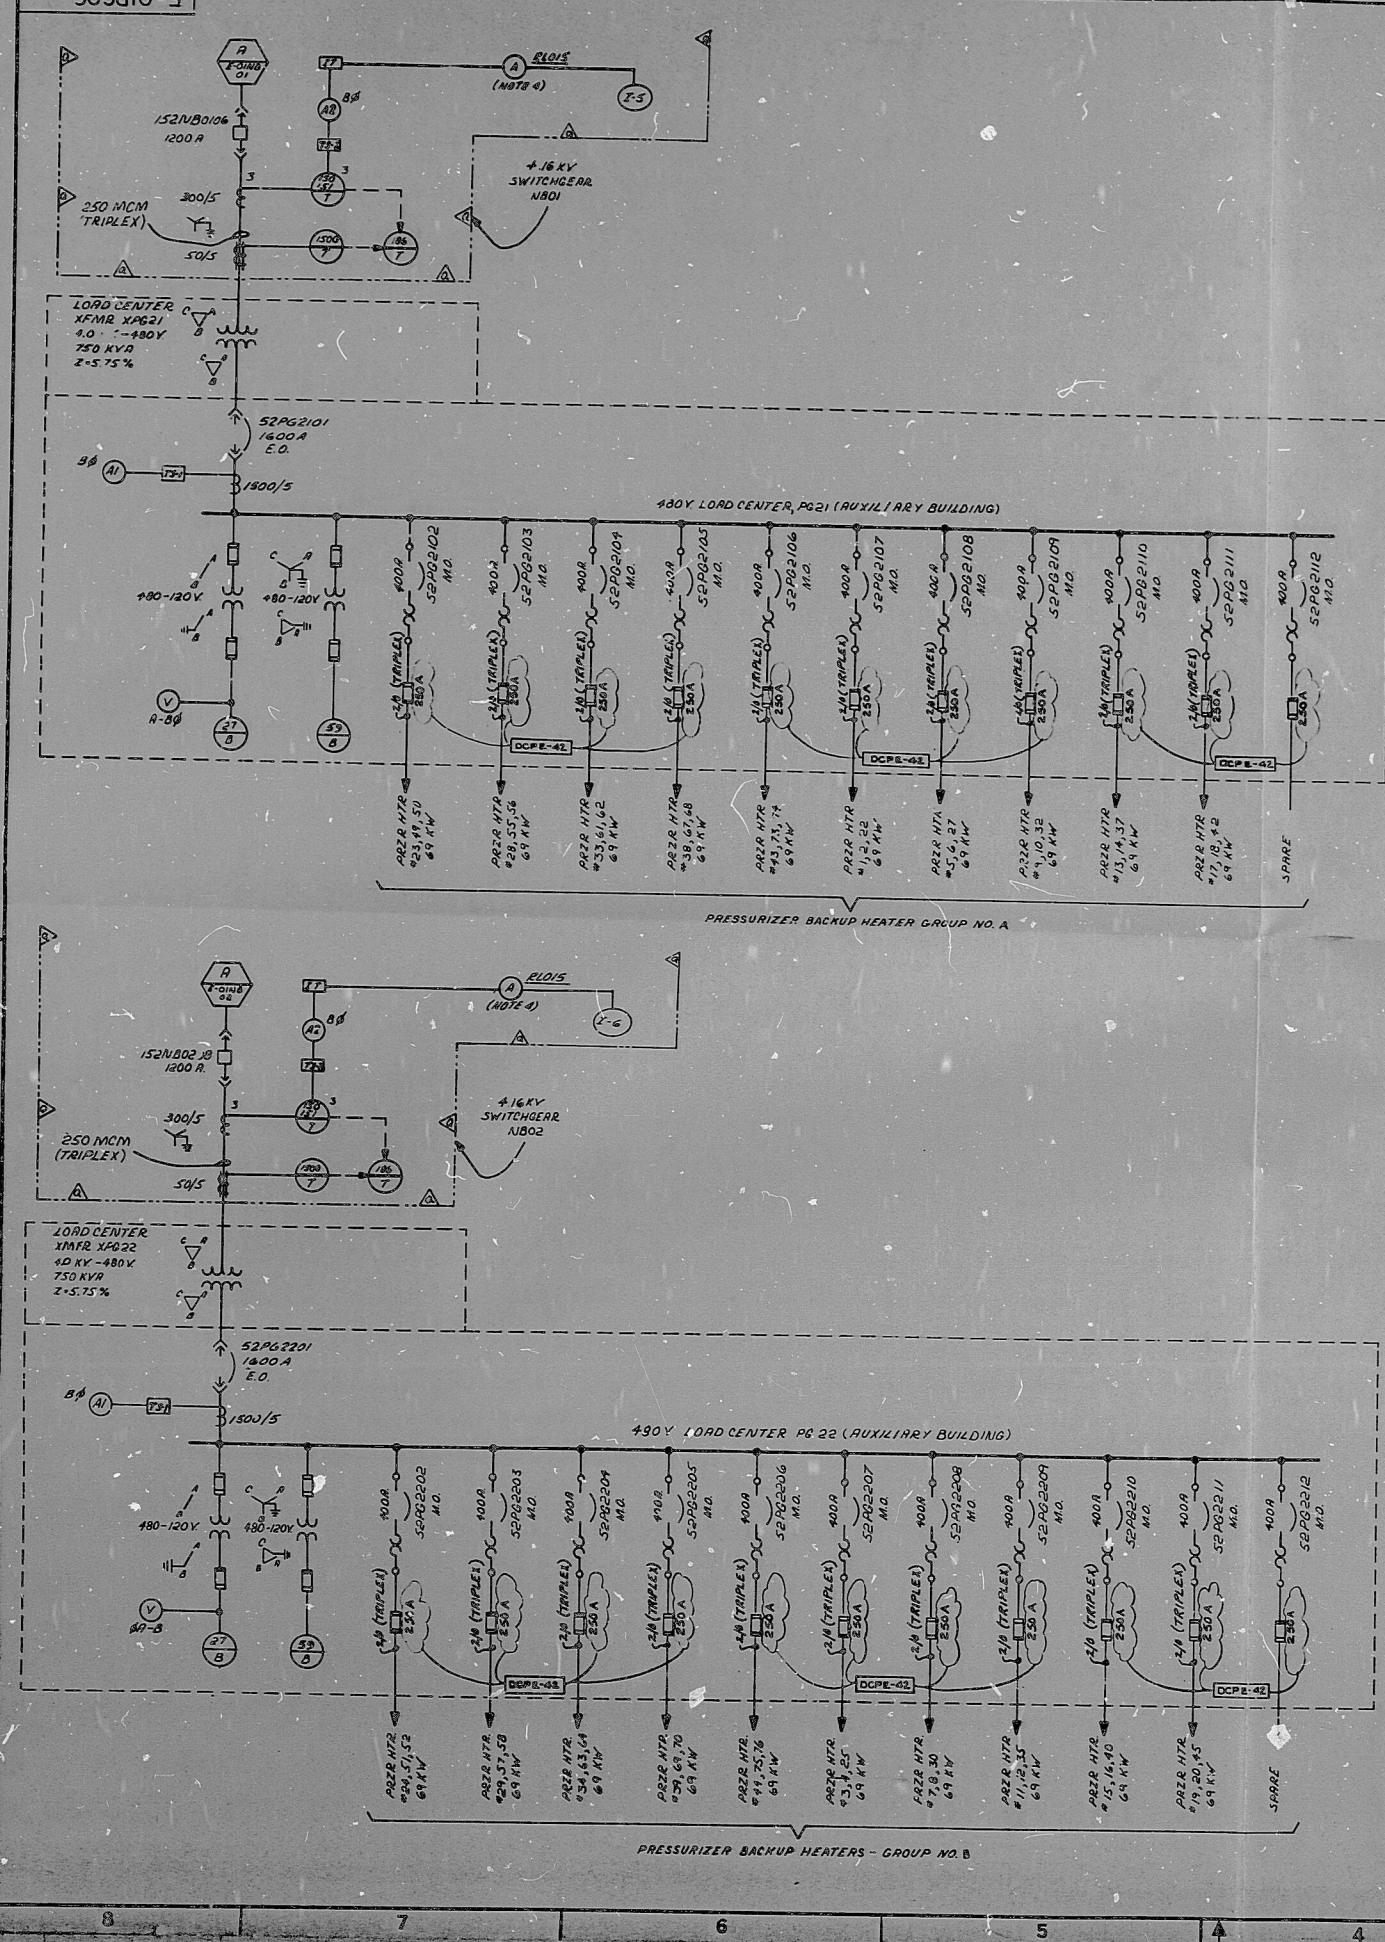

DEVICE	DESCRIPTION	MFR.	TYPE	STYLE
150-151	TRANSFORMER OVERCURRENT RELAY	G.E.	1A-53	121233002A
150-5	TRANSFORMER OVERCURRENT RELAY	G.E.	1A-53	121233002A
7	ABOVE 25 KV
3	25 KV
2	15-25 KV
1	4/60 V
NO NUMBER	480V & BELOW

SERVICE	BKR. NO.	FULL LOAD AMP	DEER TYPE	SEUSO RATING AMP	SEUSO TRIP PICK-UP TIME ("X")	LONG TIME PICK-UP TIME (SEC)	SHORT TIME PICK-UP TIME (SEC)	INST. PICK-UP TIME (SEC)	GROUP
MAIN	2101, 2201	900	WE-50	1600	1.0X	MAX. 22 SEC.	3L 35 SEC.	0.7X	MAX. 30 SEC.
69 KW	2202 THRU 2211	83	TH3K 400A FRAME	100	100	---	---	LO	---

NOTES:
 1. FOR GENERAL NOTES AND EQUIPMENT LOCATION INDEX SEE DWG. 10466-E-01003.
 2. FOR PROTECTIVE RELAY FUNCTIONS, SEE LOGIC DIAGRAM 10466-E-02P01 THRU E-02P05.
 3. EQUIVALENT RELAY CAN BE SUBSTITUTED IF NECESSARY.
 4. FOR MANUFACTURER, TYPE AND STYLE NUMBER OF ALL METERS ON MAIN CONTROL BOARD (RLOIS) SEE DWG. 10466-E-04016.
 5. 250 AMPERES FUSES IN LOAD CENTERS PO-21 & PO-12 ARE ANP-TRAP CLASS 3000L SHANNUT CRT. # WET 280.

TI APERTURE CARD

UNLESS OTHERWISE INDICATED, CIRCUIT BREAKER IS EQUIPPED WITH SOLID STATE OVERCURRENT TRIP WITH CHARACTERISTIC AND SETTING AS INDICATED.


COOPERATION NUMBER: 10466-E-01P606(Q)10

DATE: 7/17/79

DESIGNED BY: [Signature]

DRAWN BY: [Signature]

SCALE: 1" = 12"

REVIEW LEVEL 1

BECHTEL

GUTHRIESBURG, MARYLAND

SNUPPS

LOW VOLTAGE SYSTEM

NON-CLASS I/E 480V SINGLE LINE

METER & RELAY DIAGRAM

JOB NO. 10466

BECHTEL DRAWING NO. E-01P606(Q)10

DATE: 7/17/79

DESIGNED BY: [Signature]

DRAWN BY: [Signature]

SCALE: 1" = 12"


8410090118

PDR RIDS

