


11  
8.5  
8.5  
11  
17

11  
8.5  
8.5  
11  
17

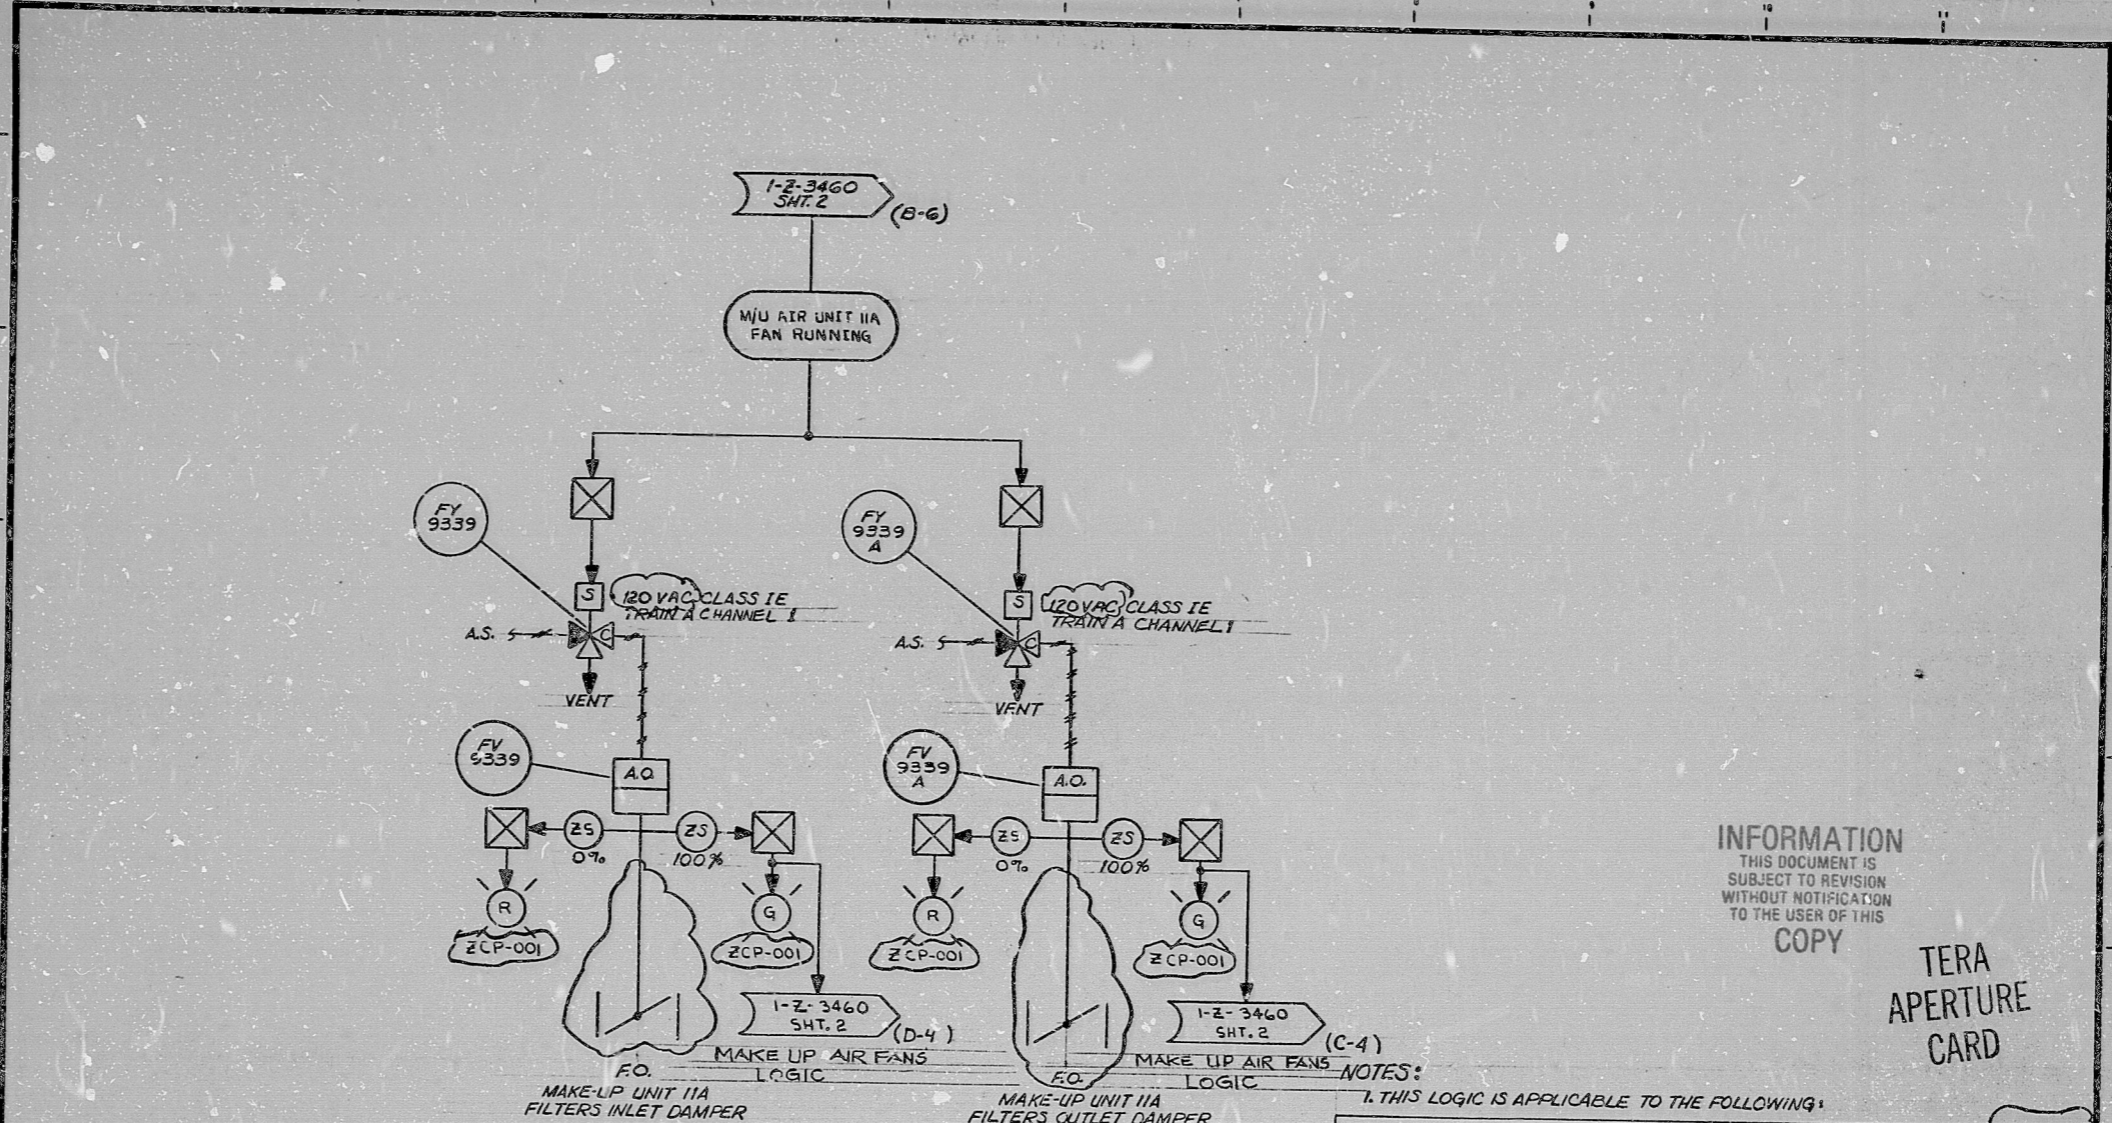

INFORMATION  
THIS DOCUMENT IS  
SUBJECT TO REVISION  
WITHOUT NOTIFICATION  
TO THE USER OF THIS  
COPY

TERA  
APERTURE  
CARD


NOTES:  
1. THIS LOGIC IS APPLICABLE TO THE FOLLOWING:

SERVICE	TRAIN	DAMPER NO.	SOLENOID VALVE	ELECTRICAL REF. DWG.
MAKE-UP UNIT IIA FILTERS INLET DAMPER	A	FV-9339	FY-9339	E-7428, SHT. 1
MAKE-UP UNIT IIA FILTERS OUTLET DAMPER	A	FV-9339A	FY-9339A	E-7428, SHT. 1
MAKE-UP UNIT IIB FILTERS INLET DAMPER	B	FV-9365	FY-9365	E-7428, SHT. 2
MAKE-UP UNIT IIB FILTERS OUTLET DAMPER	B	FV-9365A	FY-9365A	E-7428, SHT. 2
MAKE-UP UNIT IIC FILTERS INLET DAMPER	C	FV-9391	FY-9391	E-7428, SHT. 3
MAKE-UP UNIT IIC FILTERS OUTLET DAMPER	C	FV-9391A	FY-9391A	E-7428, SHT. 3

GENERAL NOTE:  
THIS DRAWING REPRESENTS FUNCTIONAL REQUIREMENTS ONLY. REFER TO ELECTRICAL REFERENCE DRAWING FOR HARDWARE IMPLEMENTATION.

B 1279 REVISED AS NOTED; ISSUED FOR USE A 1777 REVIEWED AS NOTED; ISSUED FOR USE										PKG. NO. 133 AREA 102 SOUTH TEXAS PROJECT ENGINEERS-CONSTRUCTORS HOUSTON, TEXAS DRAWING TITLE: ELEC. AUX. BLDG. CONT. RM. MAKE-UP AIR FILTERS LOGIC DIAGRAM SYSTEM: V-II CONTRACT NO. SCALE: CR-0241 NA DRAWING NO. 4V-11 1-Z-3463 B SHT. 11 <input type="checkbox"/> PRELIMINARY <input type="checkbox"/> REVIEW <input checked="" type="checkbox"/> USE <input type="checkbox"/> CONSTRUCTION									
NO.	DATE	DESCRIPTION	BY	CHK	PROJ. ENGR.	PROJ. MGR.	Q.C.	D.V.	NO.	DATE	DESCRIPTION	BY	CHK	PROJ. ENGR.	PROJ. MGR.	Q.C.	D.V.	NO.	DATE

BROWN & ROOT INC.  
MICROFILM SERVICES  
FRIDAY, OCT. 5 1979

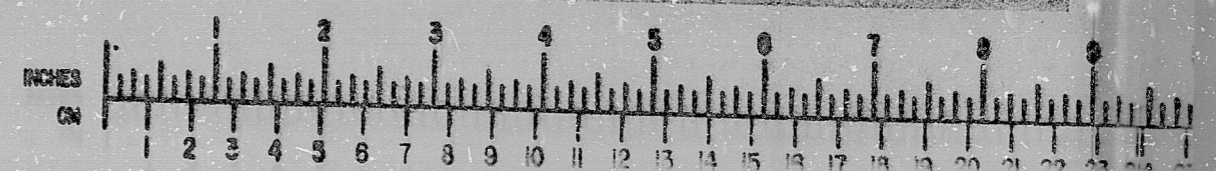

RIDS

812090381

