


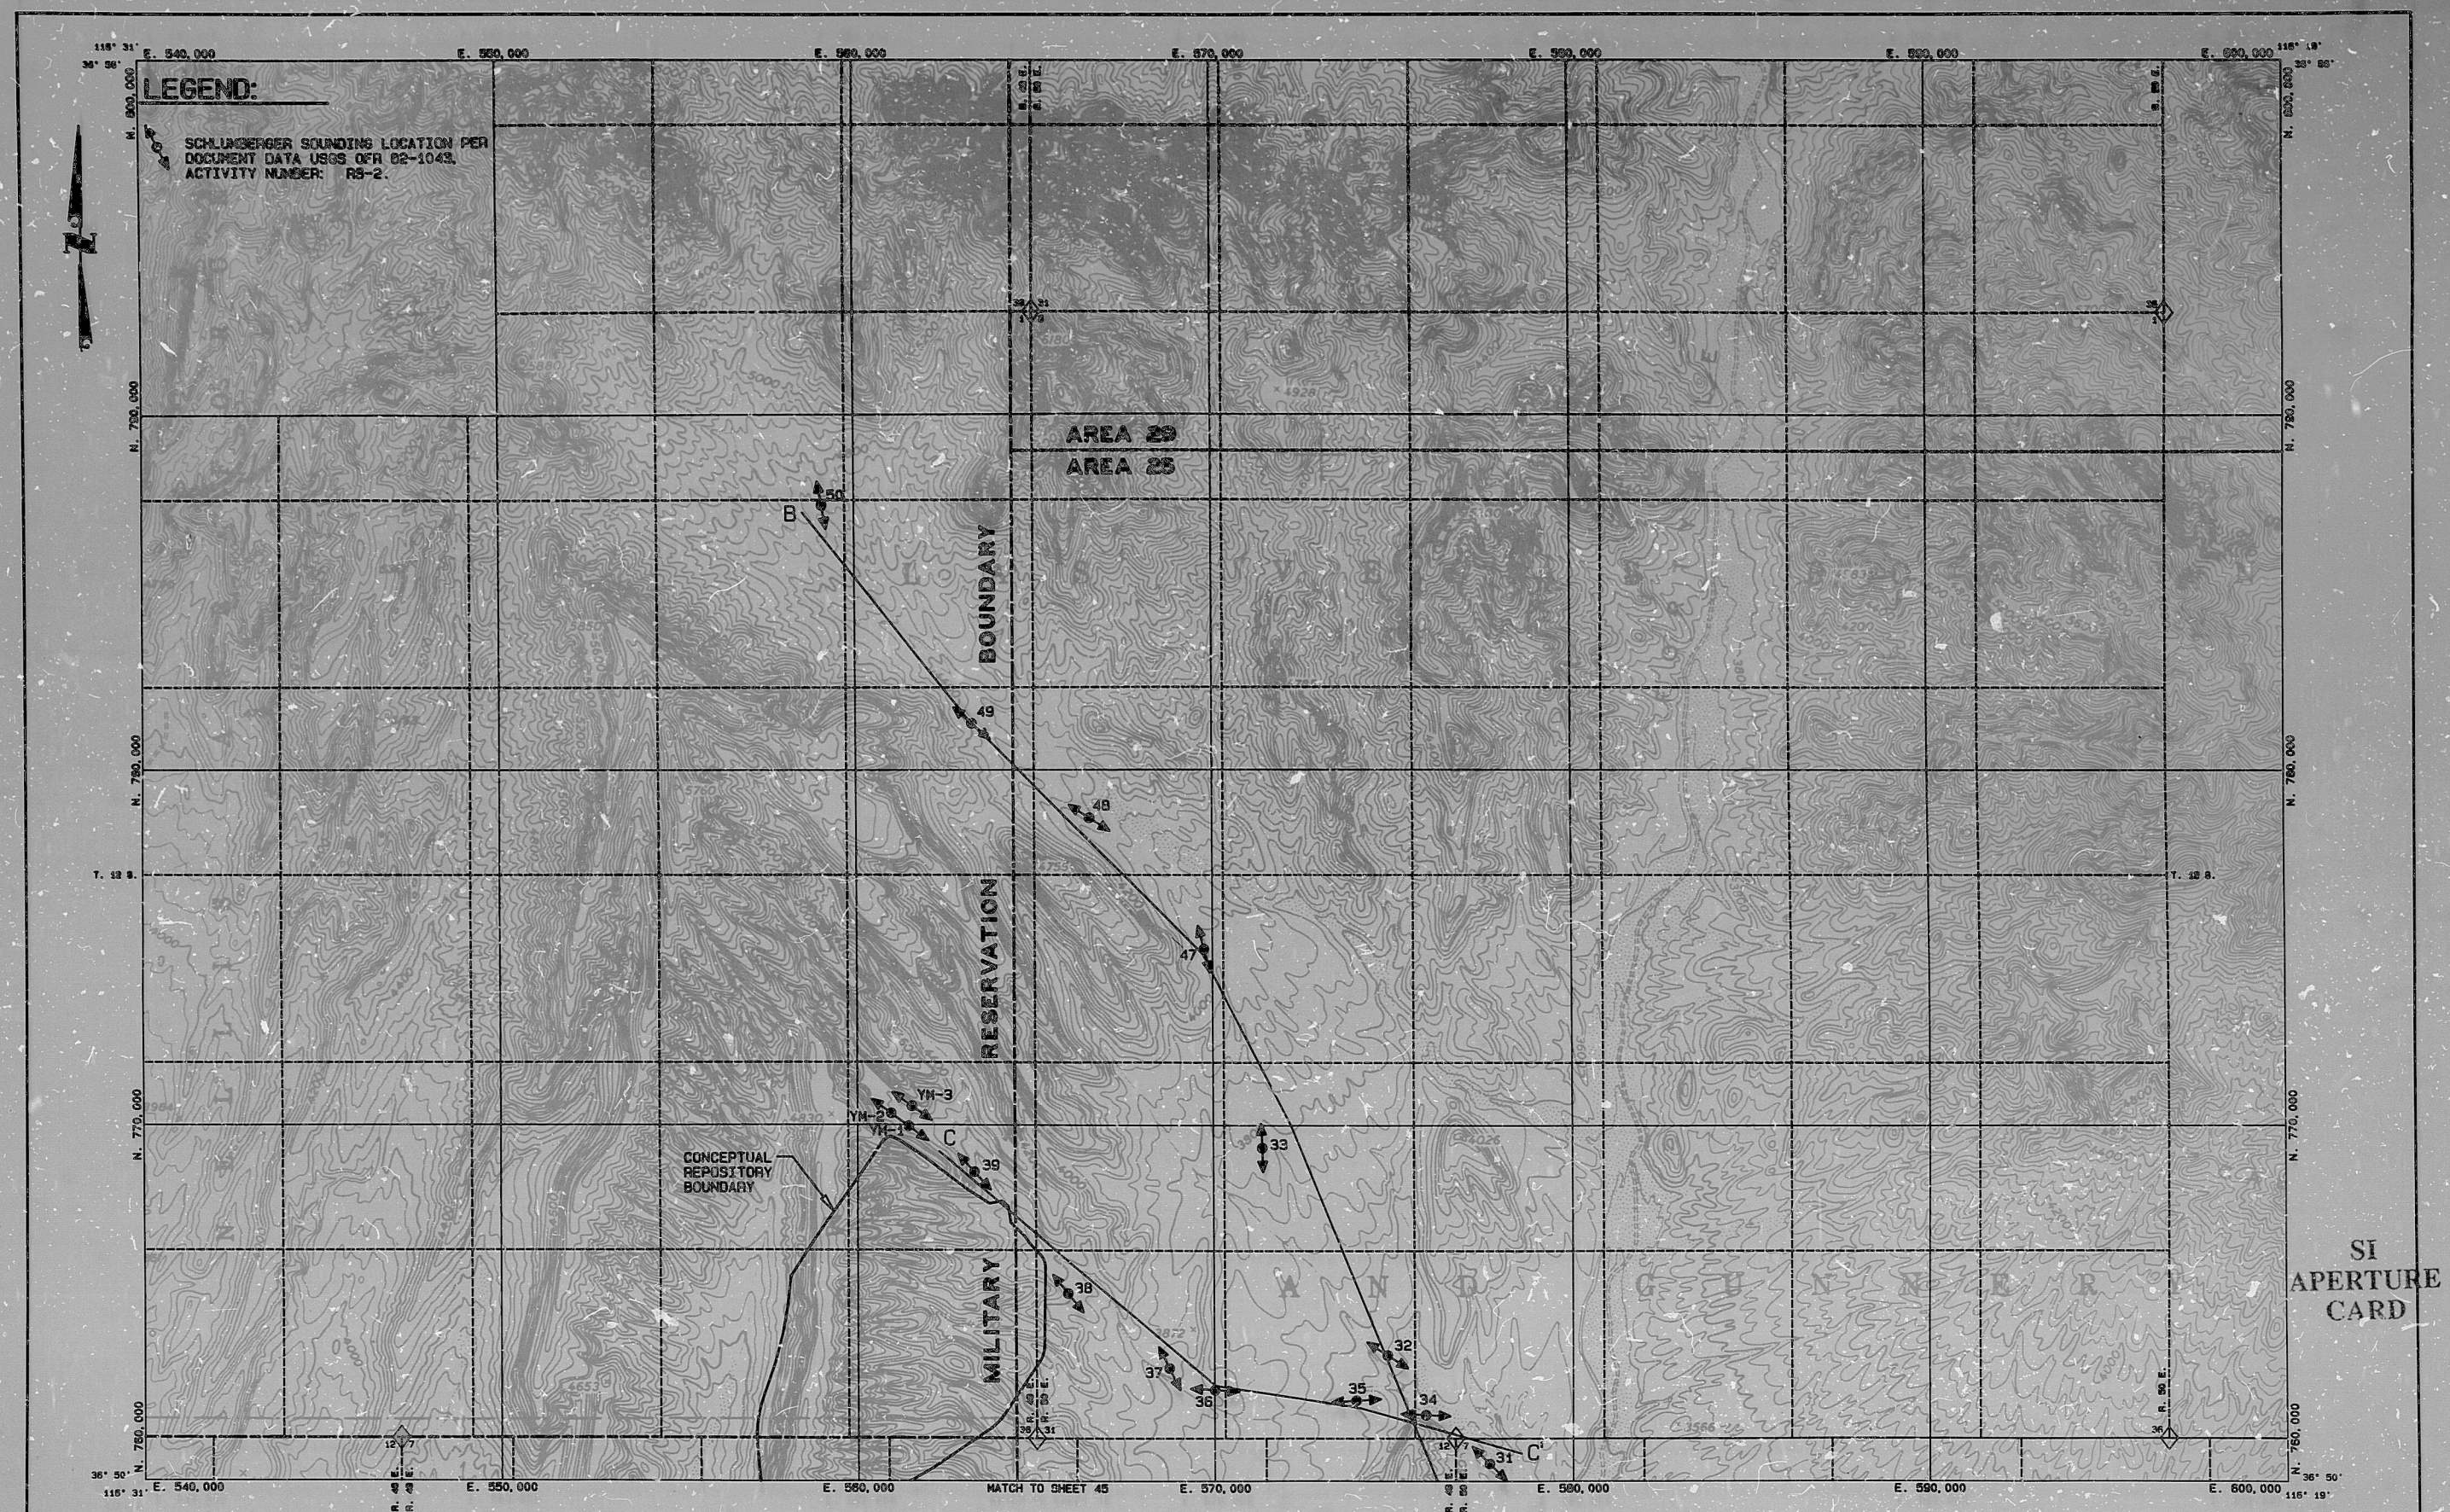

SI
APERTURE
CARD

ORIGINATOR: <i>W. J. [illegible]</i> DATE: <i>1/1/80</i>		ORIGINAL DRAWING REVISION: <i>1</i>		BY: <i>W. J. [illegible]</i> CK: <i>W. J. [illegible]</i> TPO: <i>W. J. [illegible]</i> DOE: <i>W. J. [illegible]</i>		COMPILED FROM THE GEOLOGICAL SURVEY DATES: 1952, 1953, 1954 VERTICAL DATUM: NORTH AMERICAN DATUM 1927 GRID DATUM: NEVADA COORDINATE SYSTEM CENTRAL ZONE		 HOLMES & NARVER, INC. ENERGY SUPPORT DIVISION 1050 EAST FLAMINGO ROAD LAS VEGAS, NEVADA		GRAPHIC SCALE 2000 0 2000 4000 SCALE FEET CONTOUR INTERVAL = 40'		SUBTITLE RESISTIVITY SURVEY TITLE NNWSI ATLAS OF FIELD ACTIVITIES		SHEET 44 1 OF 3 Dwg. No. V003790-5	
---	--	--	--	--	--	--	--	---	--	---	--	---	--	---	--

PDR RIDS

8812130147

