

11

11

8.5

8.5

11

17

11


11

8.5

8.5

11

17

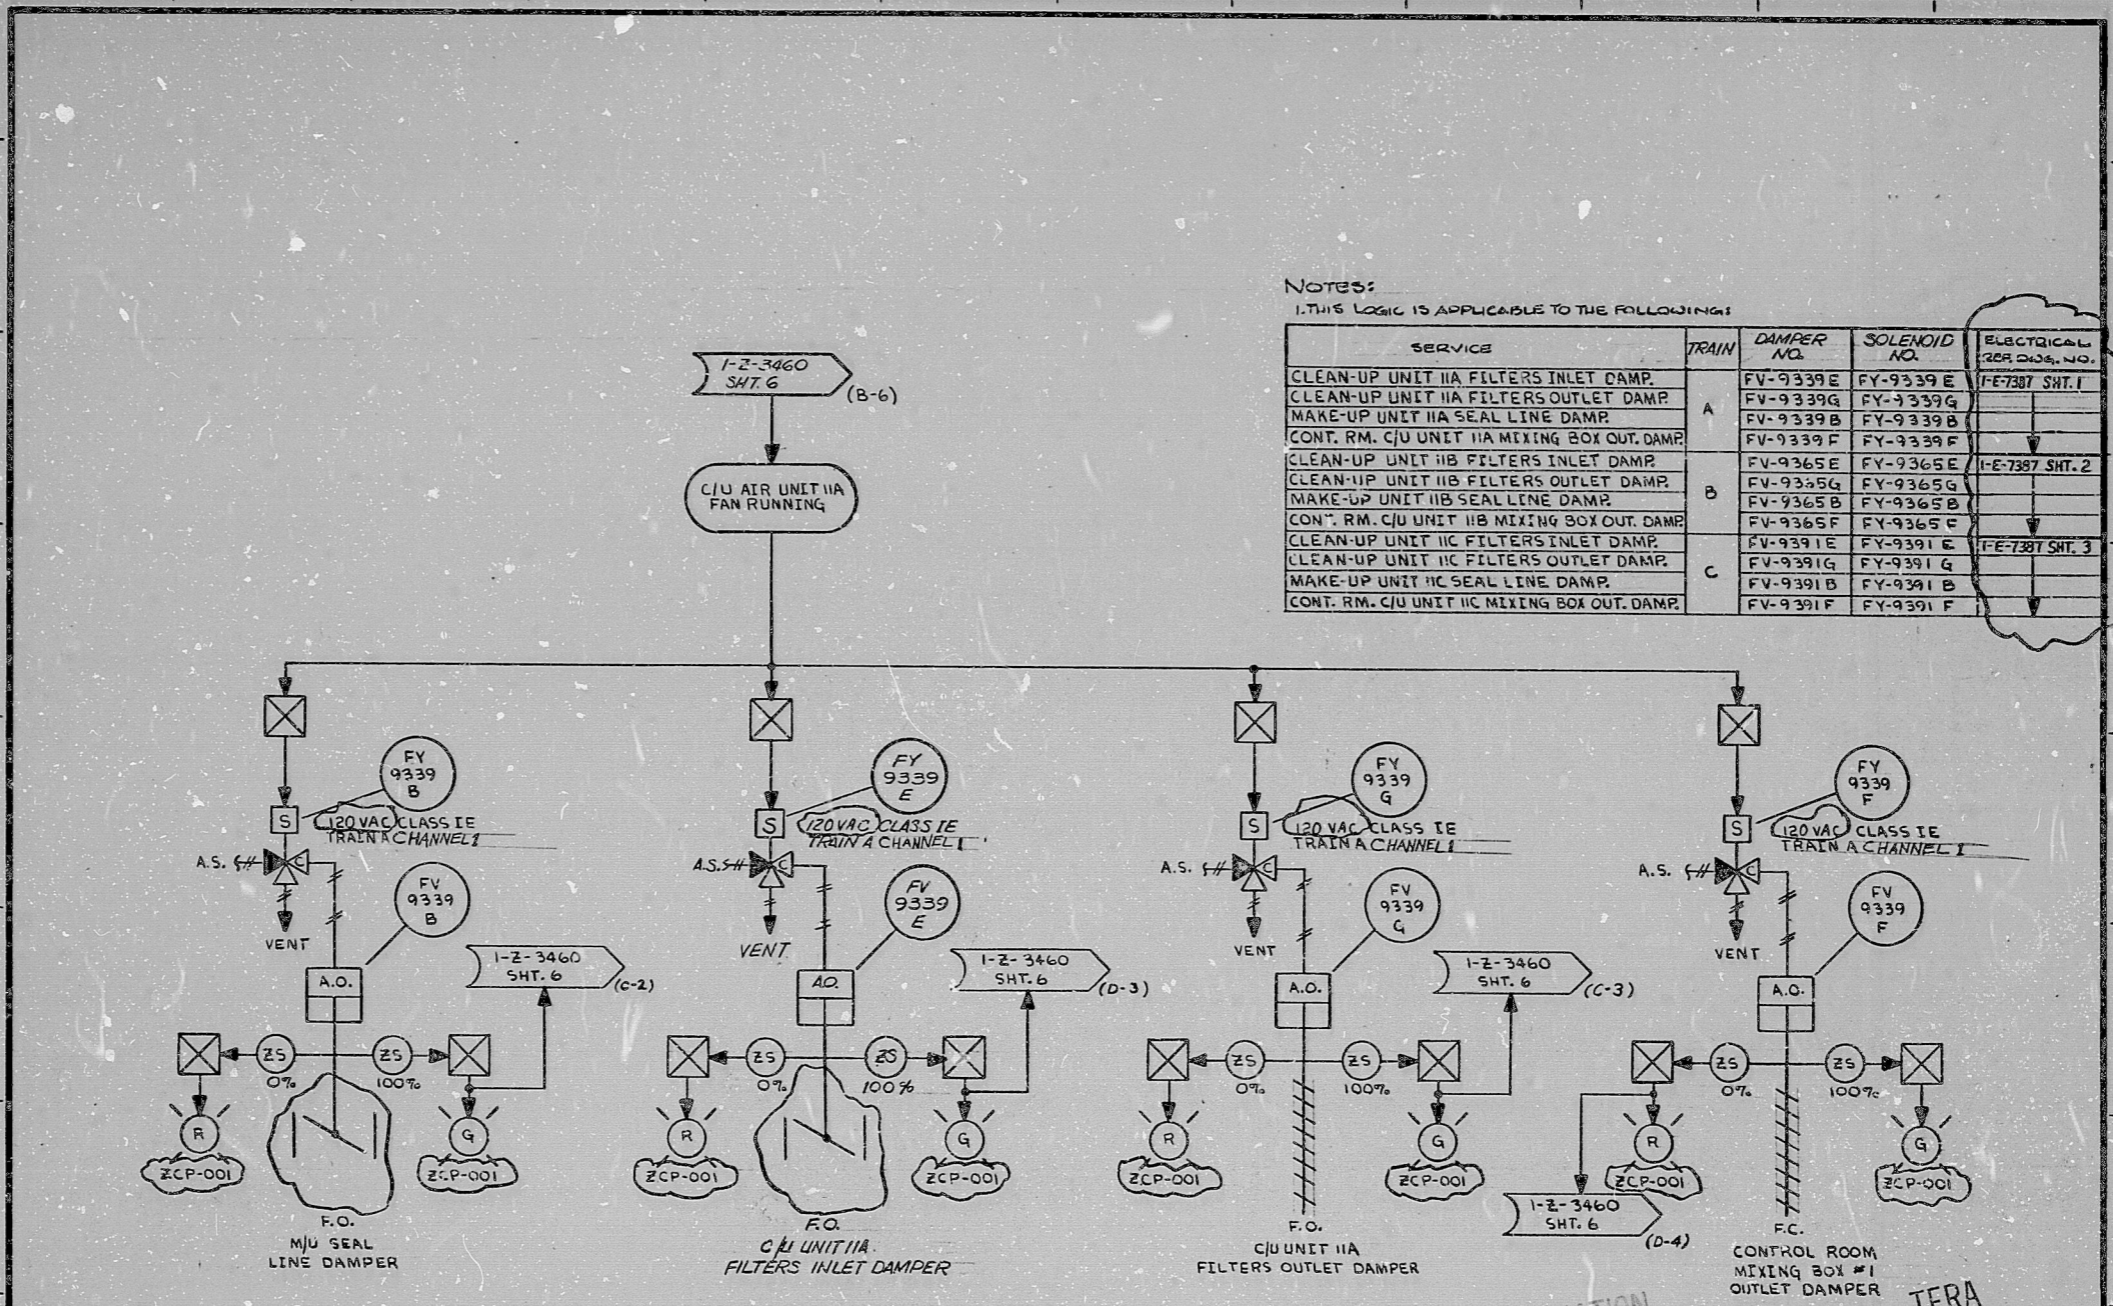

NOTES:
1. THIS LOGIC IS APPLICABLE TO THE FOLLOWING:

SERVICE	TRAIN	DAMPER NO.	SOLENOID NO.	ELECTRICAL (SER. NO.)
CLEAN-UP UNIT IIA FILTERS INLET DAMP.	A	FV-9339 E	FY-9339 E	FE-7387 SHT. 1
CLEAN-UP UNIT IIA FILTERS OUTLET DAMP.	A	FV-9339 G	FY-9339 G	
MAKE-UP UNIT IIA SEAL LINE DAMP.	A	FV-9339 B	FY-9339 B	
CONT. RM. CJU UNIT IIA MIXING BOX OUT. DAMP.	A	FV-9339 F	FY-9339 F	
CLEAN-UP UNIT IIB FILTERS INLET DAMP.	B	FV-9365 E	FY-9365 E	FE-7387 SHT. 2
CLEAN-UP UNIT IIB FILTERS OUTLET DAMP.	B	FV-9365 G	FY-9365 G	
MAKE-UP UNIT IIB SEAL LINE DAMP.	B	FV-9365 B	FY-9365 B	
CONT. RM. CJU UNIT IIB MIXING BOX OUT. DAMP.	B	FV-9365 F	FY-9365 F	
CLEAN-UP UNIT IIC FILTERS INLET DAMP.	C	FV-9391 E	FY-9391 E	FE-7387 SHT. 3
CLEAN-UP UNIT IIC FILTERS OUTLET DAMP.	C	FV-9391 G	FY-9391 G	
MAKE-UP UNIT IIC SEAL LINE DAMP.	C	FV-9391 B	FY-9391 B	
CONT. RM. CJU UNIT IIC MIXING BOX OUT. DAMP.	C	FV-9391 F	FY-9391 F	

GENERAL NOTE:
THIS DRAWING REPRESENTS FUNCTIONAL REQUIREMENTS ONLY. REFER TO ELECTRICAL REFERENCE DRAWING FOR HARDWARE IMPLEMENTATION.

DATE	DESCRIPTION	BY	CHK	PROJ. ENG.	PROJ. MGR.	DATE	DESCRIPTION	BY	CHK	PROJ. ENG.	PROJ. MGR.	DATE	DESCRIPTION	BY	CHK	PROJ. ENG.	PROJ. MGR.	


Brown & Root Inc.
ENGINEERS-CONSTRUCTORS
HOUSTON, TEXAS

SOUTH TEXAS PROJECT

DRAWING TITLE
ELEC. AUX. BLDG. & CONT. RM.
SEAL LINE & CLEAN-UP FILTER
DAMPERS LOGIC DIAGRAM
SYSTEM: V-11


PKG. NO. 133 AREA 102
CONTRACT NO. SCALE
CR-0241 NA
DRAWING NO. 2V-11
1-Z-3463E
SHT. 2

PRELIMINARY REVIEW USE CONSTRUCTION

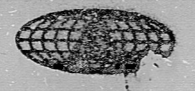

BROWN & ROOT INC.
MICROFILM SERVICES

FRIDAY, OCT. 5 1979

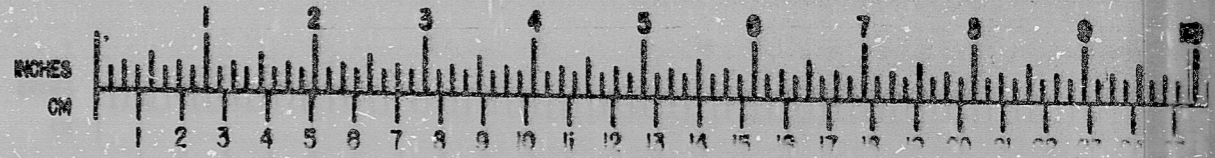

INFORMATION
THIS DOCUMENT IS
SUBJECT TO REVISION
WITHOUT NOTIFICATION
TO THE USER OF THIS
COPY

TERA
APERTURE
CARD

RIDS

812090551

