

17"

11"

8.5"

8.5"

11"

17"

17"


11"

8.5"

8.5"

11"

17"

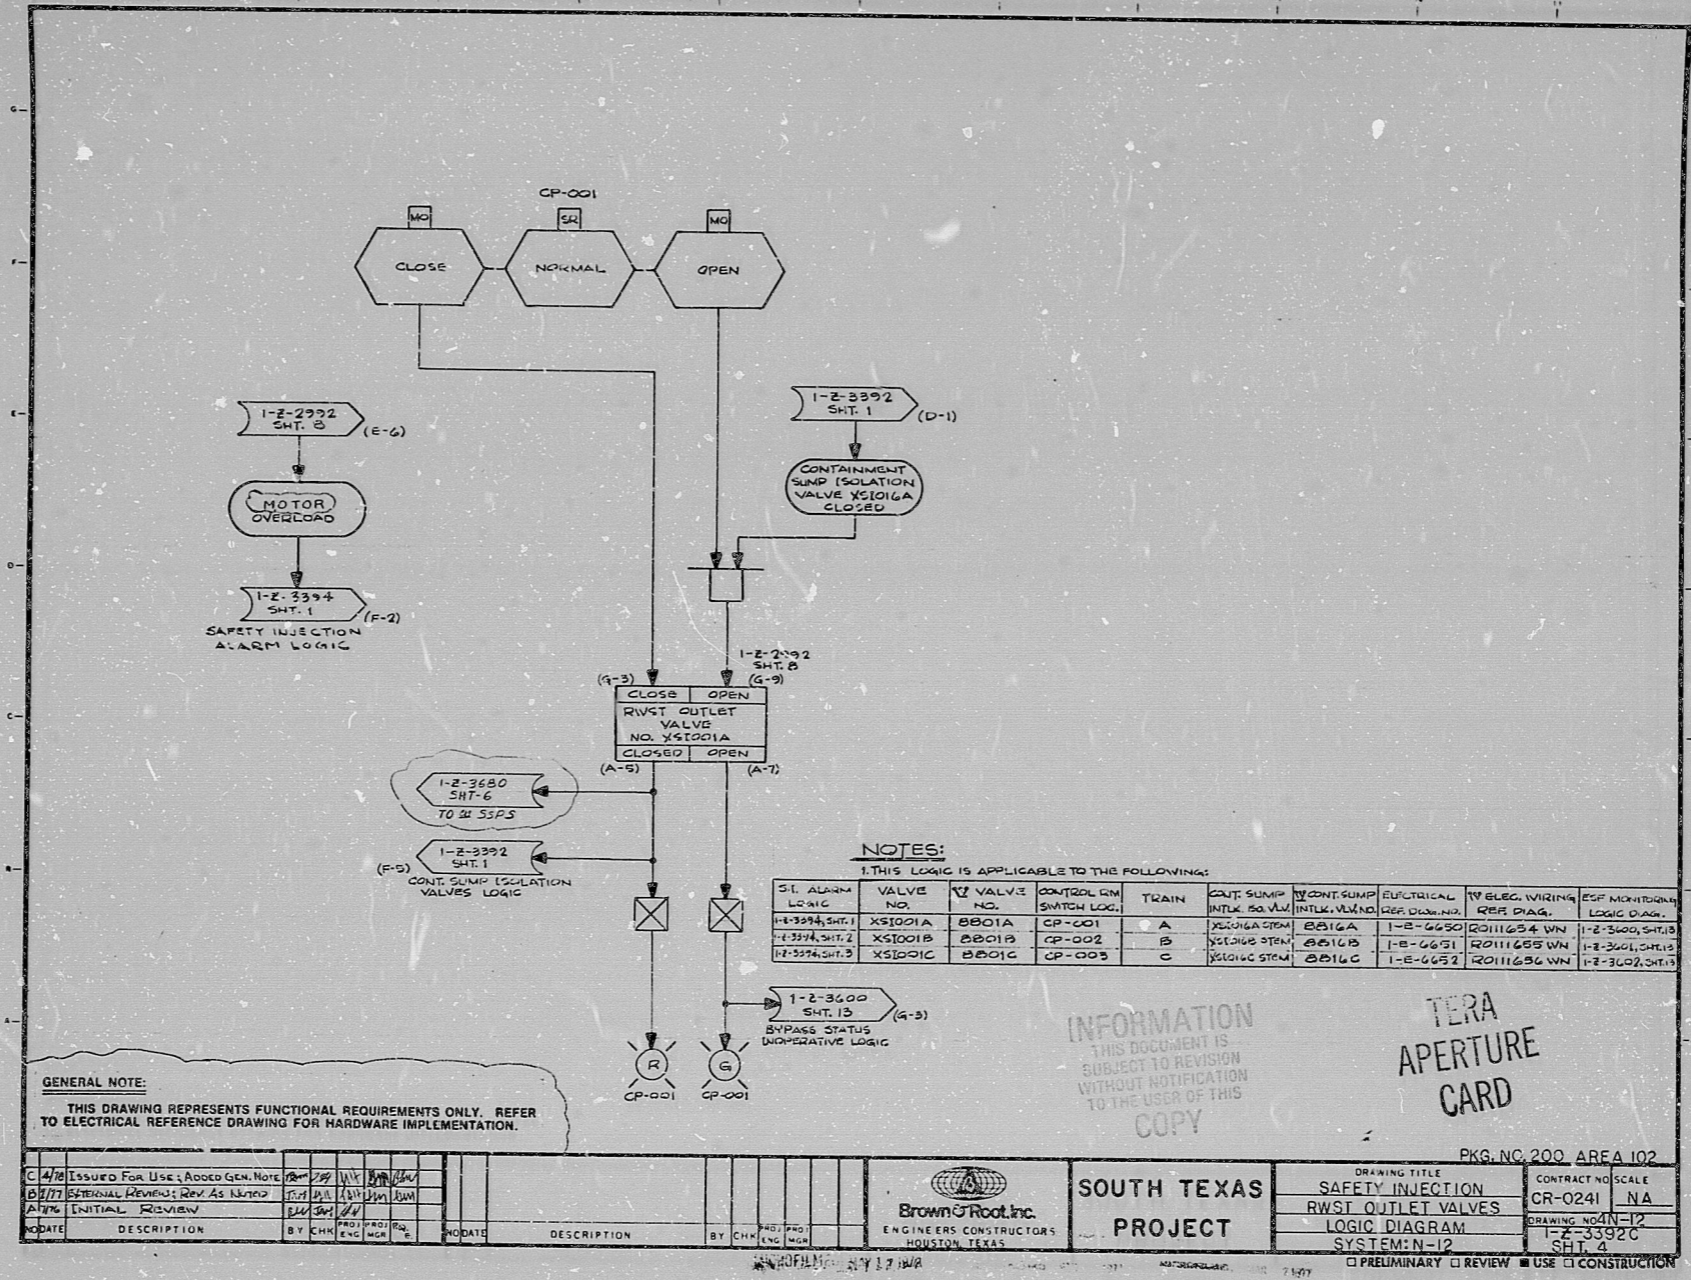

DATE	DESCRIPTION	BY	CHK	ENG	WCH	DATE	DESCRIPTION	BY	CHK	ENG	WCH

**Brown & Root Inc.**  
ENGINEERS CONSTRUCTORS  
HOUSTON, TEXAS

**SOUTH TEXAS PROJECT**

DRAWING TITLE: SAFETY INJECTION RWST OUTLET VALVES LOGIC DIAGRAM SYSTEM: N-12  
DRAWING NO: N-12  
SHEET: 4


CONTRACT NO: CR-0241  
SCALE: NA

PKG. NO. 200, AREA 102

PRELIMINARY □ REVIEW □ USE □ CONSTRUCTION



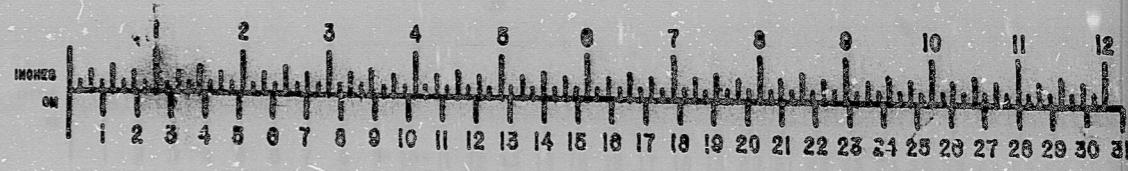

RIDS

8112090603

