


THIS SHEET IS FOR HANGER
 INFORMATION ONLY.
 SEE ORIGINAL FOR ALL
 OTHER INFORMATION.

HE	1/10/74	APPROVED	ACC
REV	DATE	BY	APPR

D-36-1
 PS-401
 N-S-E-W
 UP-DN

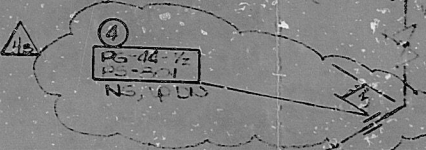

D-36-1
 PS-401
 N-S-E-W
 UP-DN

BECHTEL TURNOVER
 TO BG. & E
 FINAL DOCUMENT
 REV. 118 DATE 7/21/74

FOR INFORMATION ONLY

SI
 APERTURE
 CARD

8705050358

M. PATEL
 8-12-74

NO.	DESCRIPTION	HEATING AREA	GRID	SECTION
1	PIPE			
2	WELDING PROCEDURE			
3	PIPE WELDING			
4	WELDING CONTROL			
5	WELDING ROD			
6	STICK ROD			
7	PREHEAT			
8	MAX INTER			
9	QUALITY CONTROL DATA			
10	PIPE HEAT NOS			
11	FITTINGS HEAT NOS			
12	VALVES HEAT NOS			
13	EX. SYSTEM NO.			



PDR RIDS

89 01050358

