



8901090241

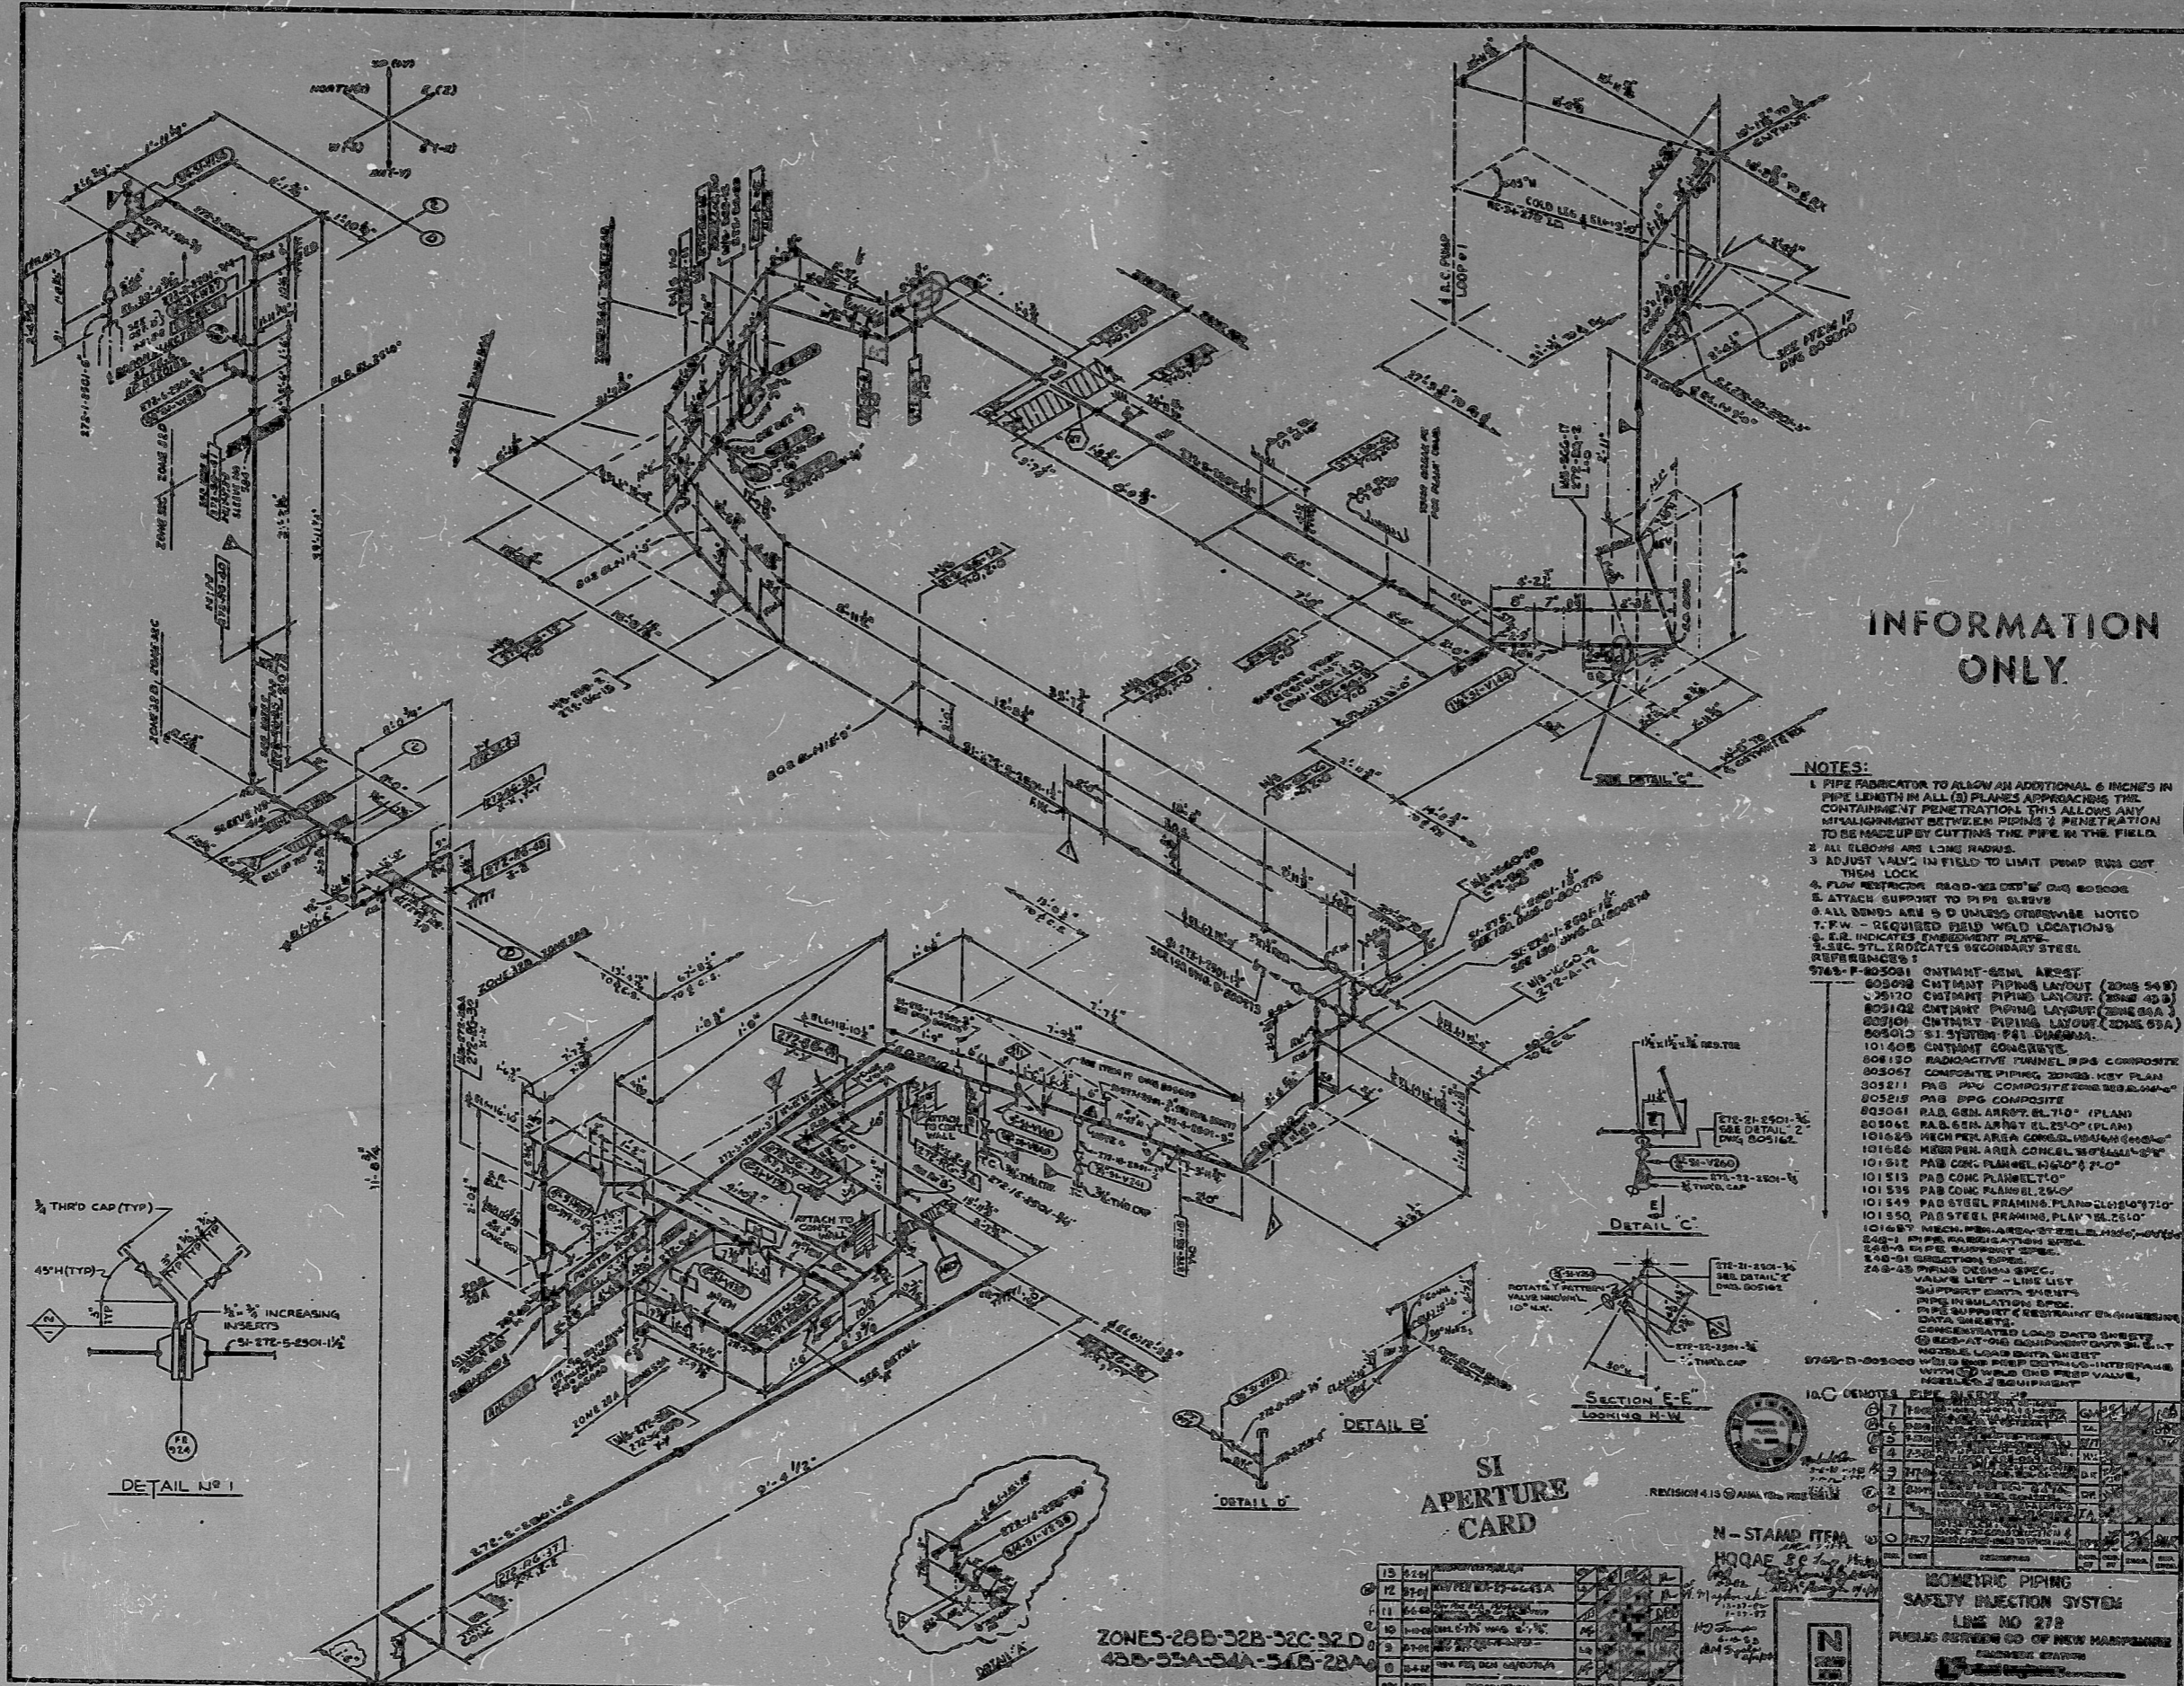

INFORMATION ONLY

- NOTES:**
- 1 PIPE FABRICATOR TO ALLOW AN ADDITIONAL 6 INCHES IN PIPE LENGTH IN ALL (D) PLANES APPROXIMATING THE CONTAINMENT PENETRATION THIS ALLOWS ANY MISALIGNMENT BETWEEN PIPING & PENETRATION TO BE MADE UP BY CUTTING THE PIPE IN THE FIELD.
 - 3 ADJUST VALVE IN FIELD TO LIMIT PUMP RUN OUT THEM LOCK.
 - 5 ATTACH SUPPORT TO PIPE SLEEVES.
 - 7 F.W. - REQUIRED FIELD WELD LOCATIONS.
 - 8 S.E. INDICATES EMBEDMENT PLATE.
 - 9 S.E.C. 57L INDICATES SECONDARY STEEL REFERENCES:
- 9763-F-00272-1 CONTINENT-GEN. AREA ST.
 - 805098 CONTINENT PIPING LAYOUT (ZONE 54 B)
 - 78170 CONTINENT PIPING LAYOUT (ZONE 40 B)
 - 805102 CONTINENT PIPING LAYOUT (ZONE 50 A)
 - 805104 CONTINENT PIPING LAYOUT (ZONE 50 A)
 - 805103 SI SYSTEM P&ID DIAGRAM.
 - 101408 CONTINENT CONCRETE.
 - 808150 RADIOACTIVE FANBELT SPS COMPOSITE.
 - 805067 COMPOSITE PIPING ZONES KEY PLAN.
 - 805211 P&ID COMPOSITE ZONES 50A-50B.
 - 805218 P&ID SPS COMPOSITE.
 - 805061 P&ID GEN. AREA ST. 710' (PLAN).
 - 805062 P&ID GEN. AREA ST. 710' (PLAN).
 - 101429 MECH. PER. AREA CONCRETE (ZONE 50A).
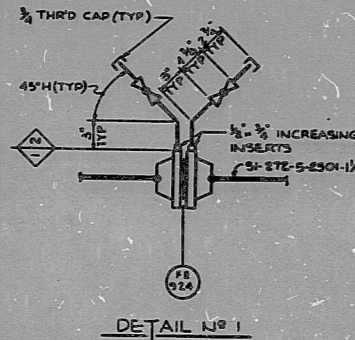

SI APERTURE CARD


ZONES-28B-32B-32C-32D
 43B-53A-54A-54B-28A

ISOMETRIC PIPING SAFETY INJECTION SYSTEM
 9763-F-00272

8901090241

PDR RIDS

89 01090241

