
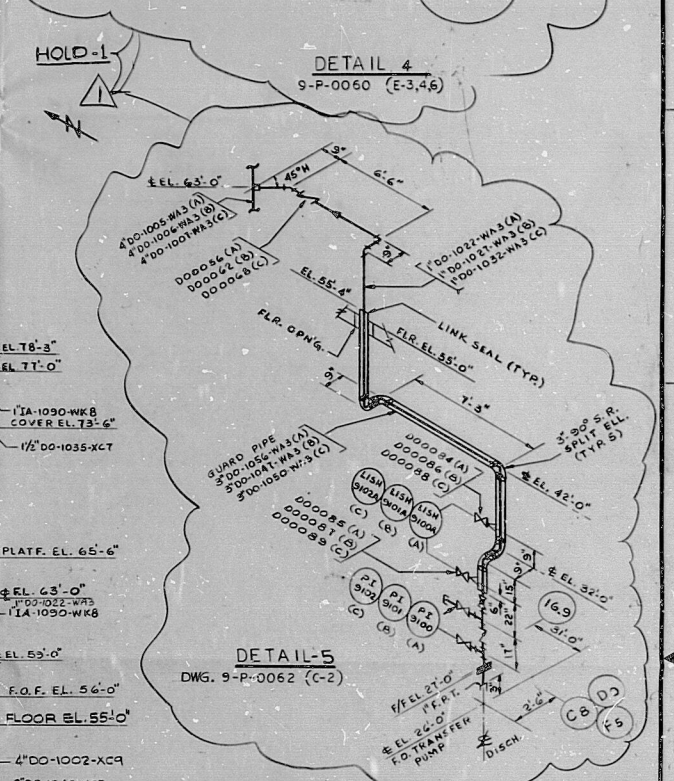
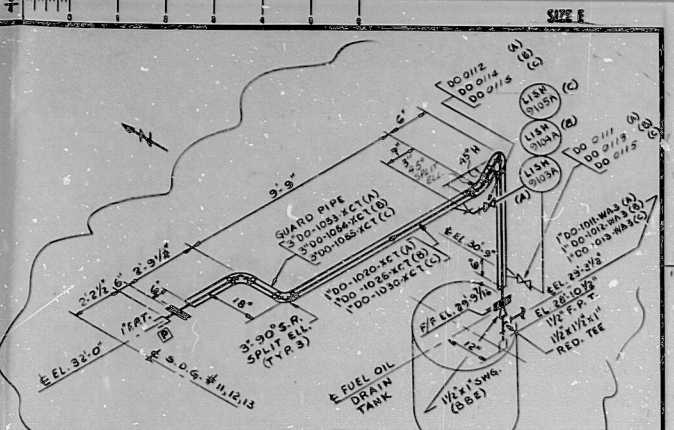


This drawing and the design it covers are the property of BECHTEL. They are hereby loaned and on the borrower's express agreement that they will not be reproduced, copied, loaned, exhibited, or used except in the limited manner and private use permitted by any written consent given by the lender to the borrower.

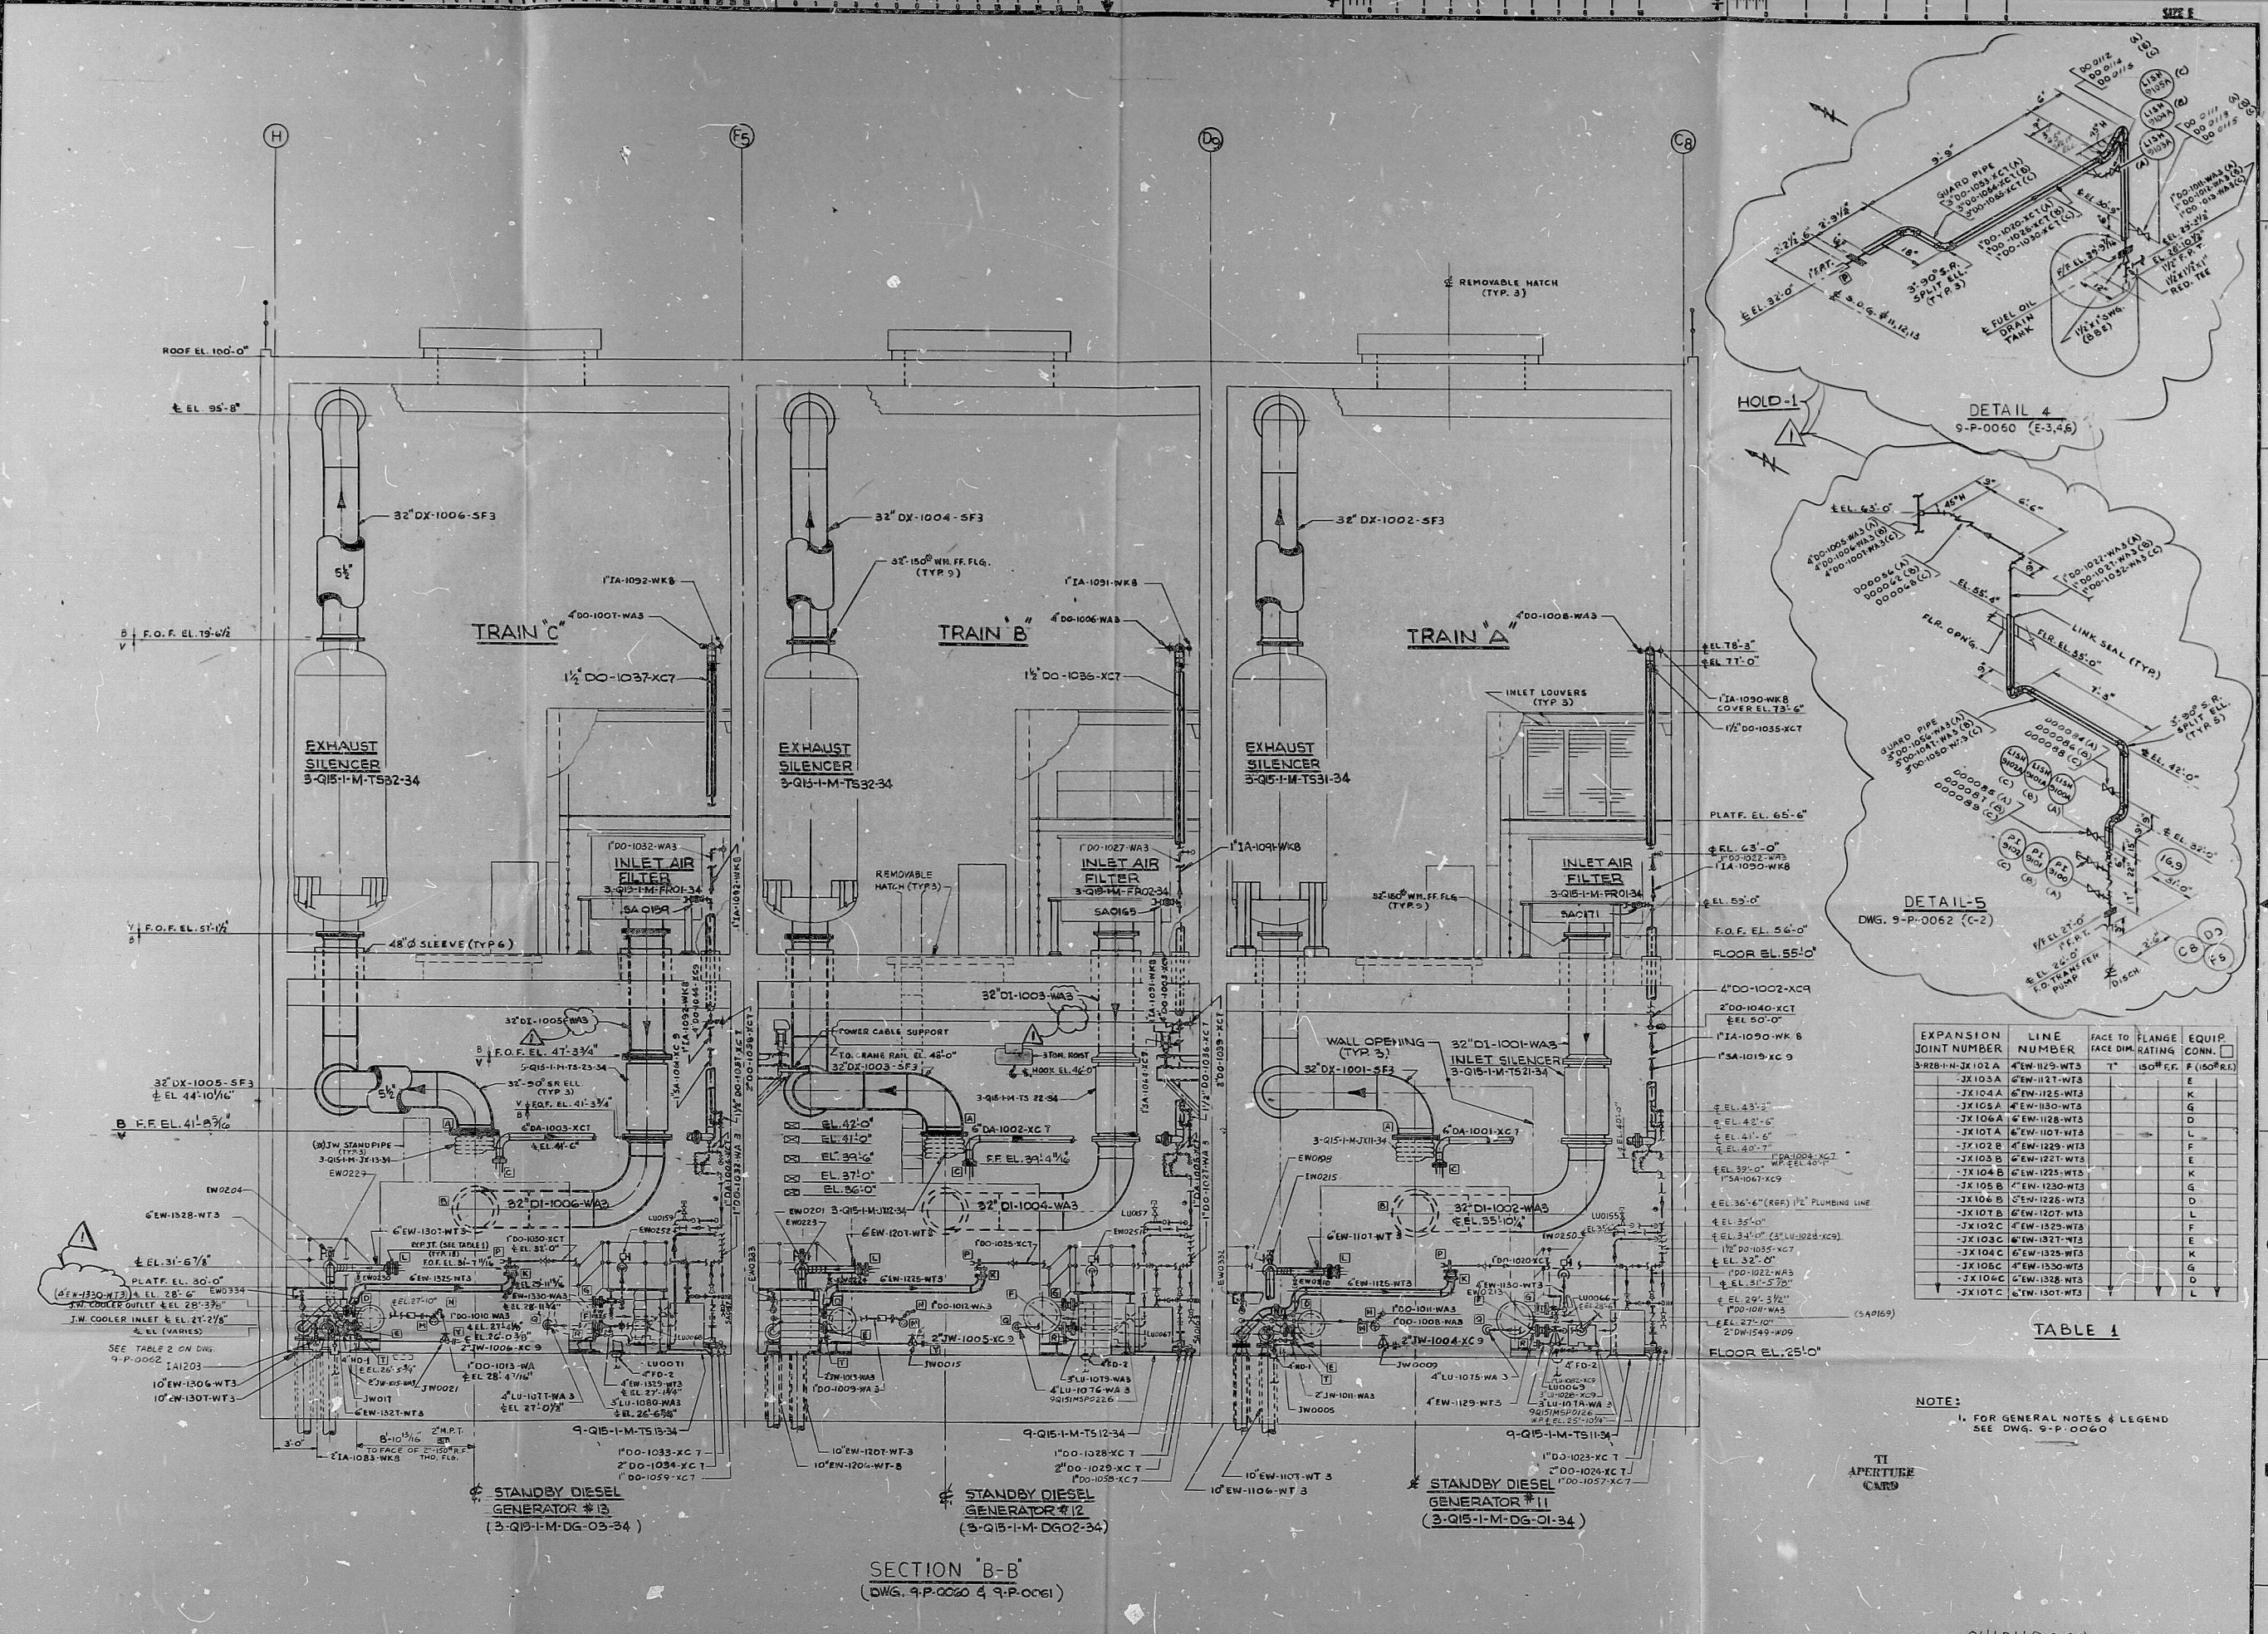

EXPANSION JOINT NUMBER	LINE NUMBER	FACE TO FACE DIM.	RATING	FLANGE	EQUIP. CONN.
3-REB-H-XK102A	4"EW-1125-WT3	T	150#	F	(150#P.R.)

NOTE:
1. FOR GENERAL NOTES & LEGEND SEE DWG. 9-P-0060

SECTION B-B
(DWG. 9-P-0060 & 9-P-0061)

NO.	REVISION	DATE	BY	CHKD	APP'D
1	REVISED AS NOTED (HOLD-1)	12-12-83			
2	ISSUED FOR CONSTRUCTION				

BECHTEL ENERGY CORPORATION
HOUSTON, TEXAS
HOUSTON LIGHTING & POWER CO.
SOUTH TEXAS PROJECT

8410110358

THIS DRAWING SUPERSEDES B & R DWGS 5D-12-1-P-0063-5
5D-12-2-P-0063-2

COMPOSITE PIPING
DIESEL GENERATOR BUILDING
SECTION & DETAILS

SCALE	JOB NO.	DRAWING NO.	REV.
1/4"=1'-0"	14926	5D-12-9-P-0063	1

PDR RIDS

8410110358

