


THESE DRAWINGS ARE THE PROPERTY OF BACORP. THEY ARE LOANED TO YOU FOR YOUR INFORMATION AND USE ONLY. YOU WILL NOT REPRODUCE, COPY, REPRODUCE, OR TRANSMIT IN ANY MANNER OR BY ANY MEANS, ELECTRONIC OR MECHANICAL, INCLUDING PHOTOCOPYING, RECORDING, OR BY ANY INFORMATION STORAGE AND RETRIEVAL SYSTEM, WITHOUT THE WRITTEN PERMISSION OF BACORP.

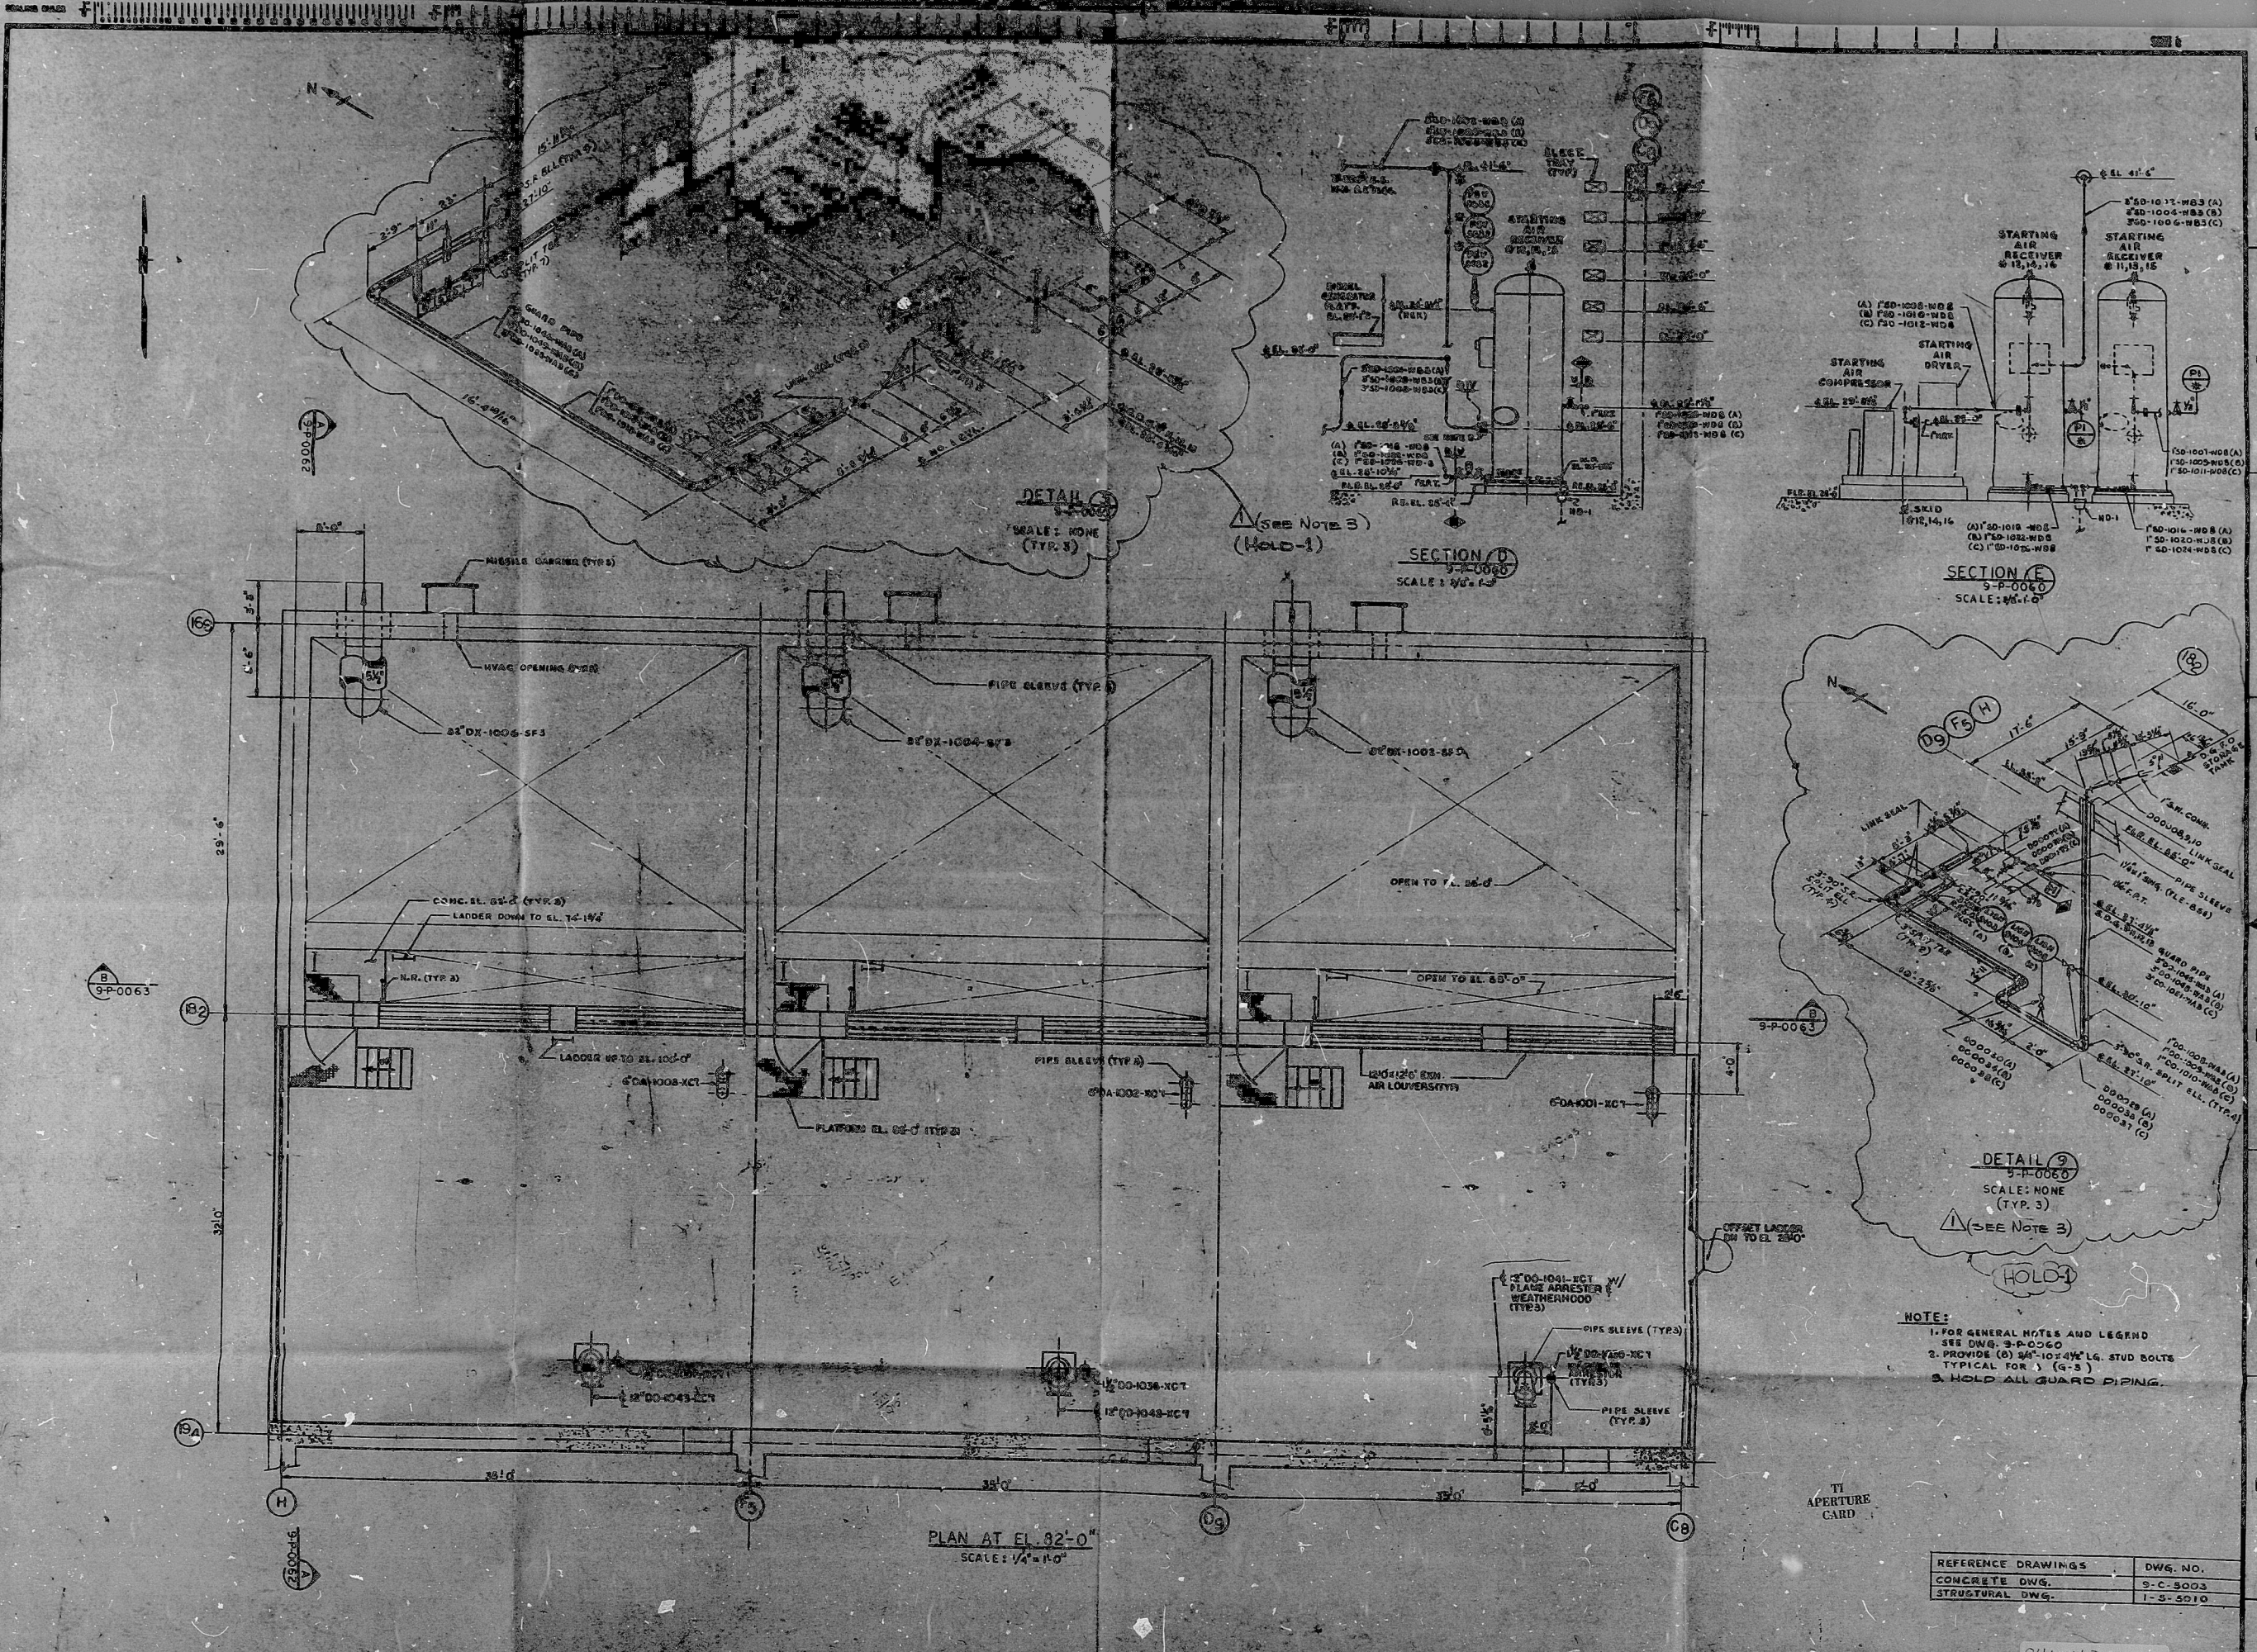

PLAN AT EL. 82'-0"
SCALE: 1/4" = 1'-0"

SECTION D
SCALE: 1/4" = 1'-0"

SECTION E
SCALE: 1/4" = 1'-0"

DETAIL 9
SCALE: NONE
(TYP. 3)
(SEE NOTE 3)
HOLD-1

- NOTE:
- FOR GENERAL NOTES AND LEGEND SEE DWG. 3-P-0060
 - PROVIDE (A) 3/4" x 4 1/2" LG. STUD BOLTS TYPICAL FOR 1 (G-3)
 - HOLD ALL GUARD PIPING.

REFERENCE DRAWINGS	DWG. NO.
CONCRETE DWG.	3-C-5003
STRUCTURAL DWG.	1-3-5010

8410110360

THIS DRAWING SUPERCEDES B&R DWG. 5015-1-P-0064-4 & 2-P-0064-2

DATE	BY	REVISION NO.	REV.
AS NOTED	14000	50-15-9-P-0064	1

NO.	DESCRIPTION	DATE	BY	CHKD.
1	ISSUED FOR CONSTRUCTION			

PDR RIDS

8410110360

