


1-Z-0522

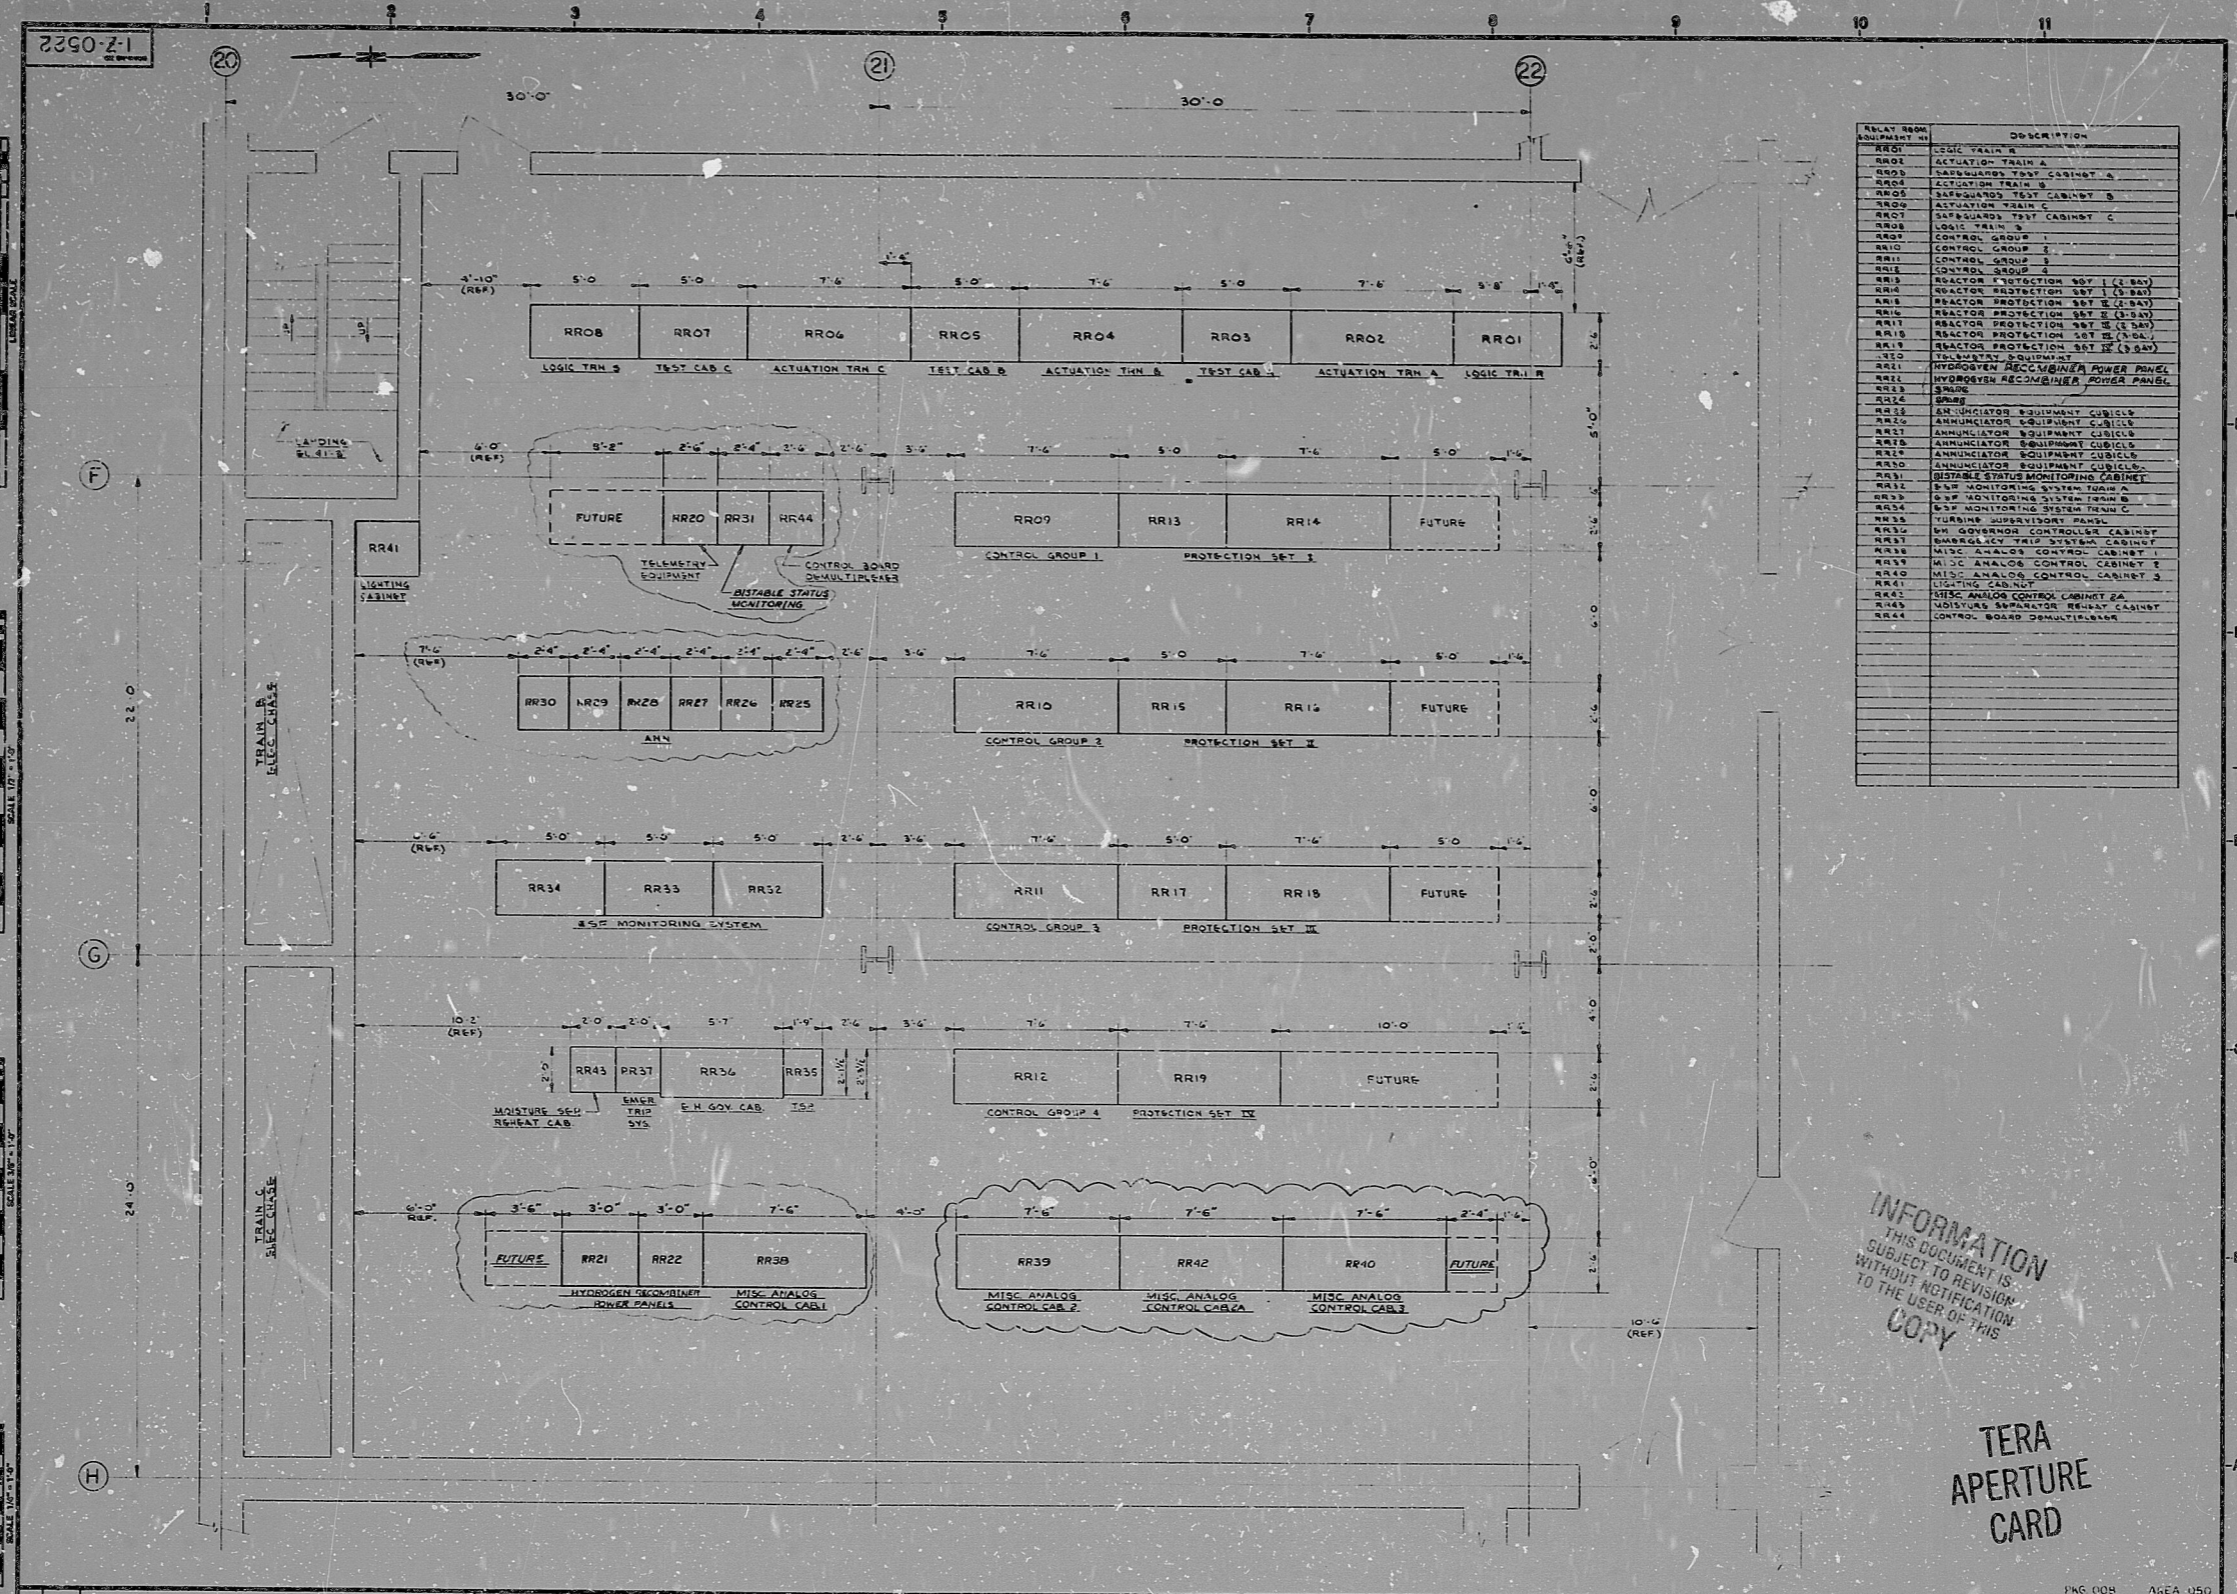

EQUIPMENT NO.	DESCRIPTION
RR01	LOGIC TRM. A
RR02	ACTUATION TRM. A
RR03	TEST CAB. A
RR04	ACTUATION TRM. B
RR05	TEST CAB. B
RR06	ACTUATION TRM. C
RR07	TEST CAB. C
RR08	LOGIC TRM. B
RR09	CONTROL GROUP 1
RR10	CONTROL GROUP 2
RR11	CONTROL GROUP 3
RR12	CONTROL GROUP 4
RR21	HYDROGEN RECOMBINER POWER PANEL
RR22	HYDROGEN RECOMBINER POWER PANEL
RR25	ANNUNCIATOR EQUIPMENT CUBICLE
RR26	ANNUNCIATOR EQUIPMENT CUBICLE
RR27	ANNUNCIATOR EQUIPMENT CUBICLE
RR28	ANNUNCIATOR EQUIPMENT CUBICLE
RR29	ANNUNCIATOR EQUIPMENT CUBICLE
RR30	ANNUNCIATOR EQUIPMENT CUBICLE
RR38	MISC. ANALOG CONTROL CABINET 1
RR39	MISC. ANALOG CONTROL CABINET 2
RR40	MISC. ANALOG CONTROL CABINET 3
RR42	MISC. ANALOG CONTROL CABINET 2A
RR44	CONTROL BOARD DEMULTIPLEXER


INFORMATION
THIS DOCUMENT IS
SUBJECT TO REVISION
WITHOUT NOTIFICATION
TO THE USER OF THIS
COPY

TERA
APERTURE
CARD



BROWN & ROOT INC.
MICROFILM SERVICES

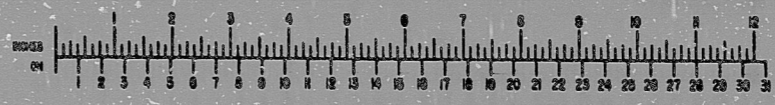

THURSDAY, APR. 6 1979

RIPS

8/12/00/98

