


This drawing and its designations are the property of BECHTEL. They are hereby loaned and on the borrower's express agreement that they will not be reproduced, copied, loaned, exhibited, nor used except in the limited way and for the purpose intended by the lender to the borrower.

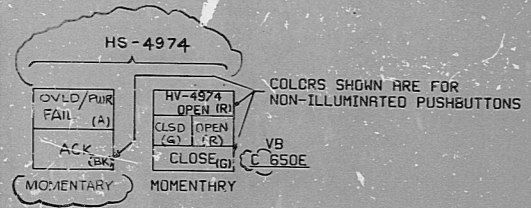

- NOTES:**
1. THE BASIC POSITION AND TORQUE SWITCH NOS FOR EACH VALVE ARE GIVEN IN THE TABLE. DASH NOS TO IDENTIFY SPECIFIC CONTACTS SHALL BE ADDED AS SHOWN ON THE DIAGRAM.
  2. CIRCUIT NO. APPLIES TO AND ORIGINATES ON J-102-O.

PRC APERTURE CARD

1/17/62	DESIGN FREEZE ISSUE				
1/24/62	REVISED BAILEY INTERFACE AND AS NOTED				
2/14/62	INC DCN #3				
1/17/62	REVISED AS NOTED				
2/20/62	ISSUED FOR CONSTRUCTION				
DATE	REVISIONS	BY	CHECKED	DESIGNED	ENGR
SCALE	PC/NE	DESIGNED	PMK	DRAWN	RCG
<b>BECHTEL</b> SAN FRANCISCO					
PUBLIC SERVICE ELECTRIC AND GAS COMPANY HOPE CREEK GENERATING STATION					
LOGIC DIAGRAM CONTAINMENT ATMOSPHERE CONTROL FEED ISLN VALVE HV-4974					
JOB No.	DRAWING No.	REV.			
10855	J-57-0	SHT 4	4	Q	

S/U - GS

22 x 34 "O" SIZE

A  
RIDS

8307250189

