


J-57-O
SHEET 18

LOGIC CABINET AC652

RESETS ON RESTORATION OF POWER.

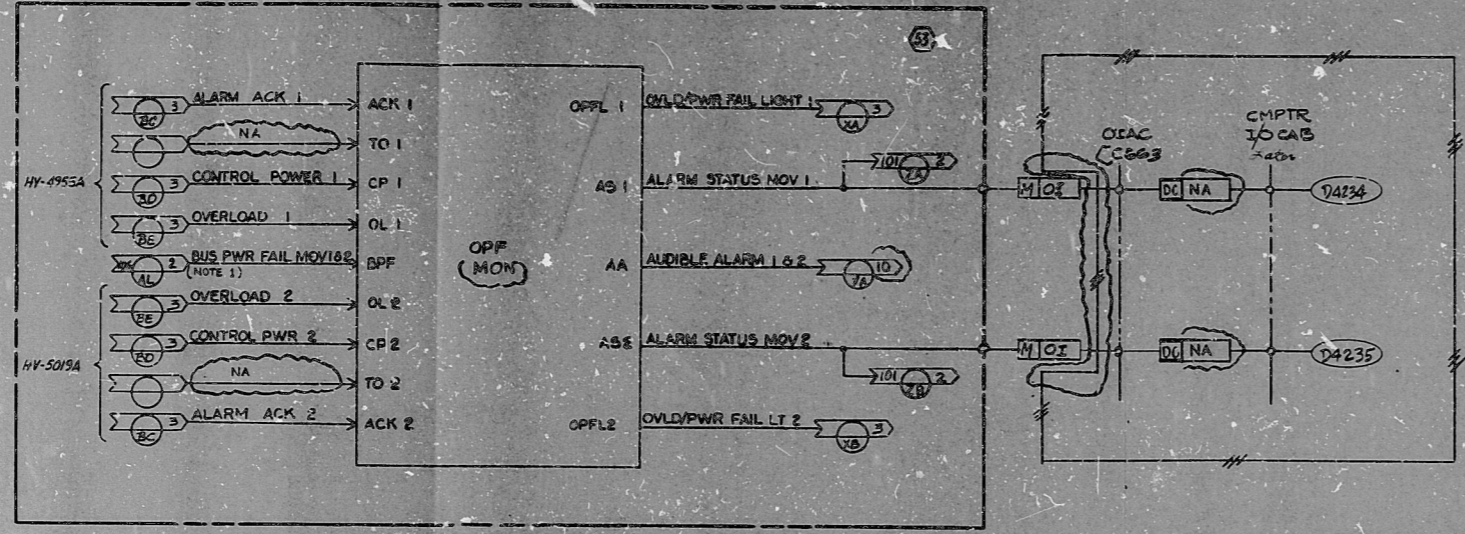

OVERLOAD/POWER FAILURE MONITOR

CROSS REFERENCE TABLE

OPF MD CKT. NO.	VALVE NO.	ACK.	CONT. PWR	OVERLOAD	BUS PWR FAIL	CHANNEL	LOGIC CABINET NO.	AUDIBLE ALARM AEROSOLS	OVERLOAD/POWER FAILURE LIGHT AEROSOLS	COMPUTER I/O CAB. NO.	COMPUTER IDENTIFY	ALARM STATUS MOV
53	HV-4955A	J-57/BC/3	J-57/BD/3	J-57/BE/3	J106/AL/2	A	AC652	J-57/VA/10	J-57/VA/10	74234	D4234	J-101/EA/2
53	HV-5019A	J-57/BC/3	J-57/BD/3	J-57/BE/3	J106/AS/2	A	AC652	J-57/VA/10	J-57/VA/10	74235	D4235	J-101/EA/2
53	HV-4966A	J-57/BC/3	J-57/BD/3	J-57/BE/3	J106/AT/2	A	AC652	J-57/VA/10	J-57/VA/10			
53	HV-5741A	J-57/BA/17	J-57/BA/17	J-57/BA/17	J106/AT/2	A	AC652	J-57/VA/10	J-57/VA/10			
53	HV-4952	J-57/BA/2	J-57/BA/2	NA	J106/AL/2	A	AC652	J-57/VA/10	J-57/VA/10			
53	HV-4956	J-57/BA/2	J-57/BA/2	NA	J106/AL/2	A	AC652	J-57/VA/10	J-57/VA/10			
53	HV-4958	J-57/BA/2	J-57/BA/2	NA	J106/AV/2	A	AC652	J-57/VA/10	J-57/VA/10			
53	HV-4964	J-57/BA/2	J-57/BA/2	NA	J106/AV/2	A	AC652	J-57/VA/10	J-57/VA/10			
54	HV-4955B	J-57/BC/3	J-57/BD/3	J-57/BE/3	J106/AS/3	B	BC652	J-57/VA/10	J-57/VA/10			
54	HV-5019B	J-57/BC/3	J-57/BD/3	J-57/BE/3	J106/AS/3	B	BC652	J-57/VA/10	J-57/VA/10			
54	HV-4957B	J-57/BC/3	J-57/BD/3	J-57/BE/3	J106/AS/3	B	BC652	J-57/VA/10	J-57/VA/10			
54	HV-4962B	J-57/BC/3	J-57/BD/3	J-57/BE/3	J106/AS/3	B	BC652	J-57/VA/10	J-57/VA/10			
54	HV-5741C	J-57/BA/17	J-57/BA/17	J-57/BA/17	J106/AS/3	B	BC652	J-57/VA/10	J-57/VA/10			
55	HV-4983A	J-57/BC/3	J-57/BD/3	J-57/BE/3	J106/AT/4	C	CC652	J-57/VA/10	J-57/VA/10			
55	HV-4984A	J-57/BC/3	J-57/BD/3	J-57/BE/3	J106/AT/4	C	CC652	J-57/VA/10	J-57/VA/10			
55	HV-4985A	J-57/BC/3	J-57/BD/3	J-57/BE/3	J106/EL/4	C	CC652	J-57/VA/10	J-57/VA/10			
55	HV-5027A	J-57/BC/3	J-57/BD/3	J-57/BE/3	J106/EL/4	C	CC652	J-57/VA/10	J-57/VA/10			
56	HV-4983B	J-57/BC/3	J-57/BD/3	J-57/BE/3	J106/AT/5	D	CC652	J-57/VA/10	J-57/VA/10			
56	HV-4984B	J-57/BC/3	J-57/BD/3	J-57/BE/3	J106/AT/5	D	CC652	J-57/VA/10	J-57/VA/10			
56	HV-4985B	J-57/BC/3	J-57/BD/3	J-57/BE/3	J106/AT/5	D	CC652	J-57/VA/10	J-57/VA/10			
56	HV-5027B	J-57/BC/3	J-57/BD/3	J-57/BE/3	J106/AT/5	D	CC652	J-57/VA/10	J-57/VA/10			
56	HV-4987	J-57/BA/5	J-57/BA/5	J-57/BA/5	J106/AT/5	D	CC652	J-57/VA/10	J-57/VA/10			
56	HV-4982	J-57/BA/5	J-57/BA/5	J-57/BA/5	J106/AT/5	D	CC652	J-57/VA/10	J-57/VA/10			
56	HV-4974	J-57/BA/14	J-57/BA/14	J-57/BA/14	J106/AT/5	D	CC652	J-57/VA/10	J-57/VA/10			
56	HV-4978	J-57/BA/13	J-57/BA/13	NA	J106/AT/5	D	CC652	J-57/VA/10	J-57/VA/10			
56	HV-4970	J-57/BA/2	J-57/BA/2	NA	J106/AT/5	D	CC652	J-57/VA/10	J-57/VA/10			
56	HV-4962	J-57/BA/2	J-57/BA/2	NA	J106/AT/5	D	CC652	J-57/VA/10	J-57/VA/10			
56	HV-4979	J-57/BA/2	J-57/BA/2	NA	J106/AT/5	D	CC652	J-57/VA/10	J-57/VA/10			
56	HV-4980	J-57/BA/2	J-57/BA/2	NA	J106/AT/5	D	CC652	J-57/VA/10	J-57/VA/10			
53	HV-6900A	J-57/BC/19	J-57/BD/19	J-57/BE/19	J106/AT/2	A	AC652	J-57/VA/10	J-57/VA/10			
53	HV-6900C	J-57/BC/19	J-57/BD/19	J-57/BE/19	J106/AT/2	A	AC652	J-57/VA/10	J-57/VA/10			
56	HV-6900B	J-57/BC/19	J-57/BD/19	J-57/BE/19	J106/AT/15	D	DC652	J-57/VA/10	J-57/VA/10			
56	HV-6900D	J-57/BC/19	J-57/BD/19	J-57/BE/19	J106/AT/15	D	DC652	J-57/VA/10	J-57/VA/10			

PRC APERTURE CARD

DESIGN FREEZE ISSUE	DATE	BY
ISSUED FOR CONSTRUCTION ADDED THIS SHT	DATE	BY
<p>BECHTEL SAN FRANCISCO</p> <p>PUBLIC SERVICE ELECTRIC AND GAS COMPANY HOPE CREEK GENERATING STATION</p> <p>LOGIC DIAGRAM CONTAINMENT ATMOSPHERE CONTROL OVERLOAD POWER FAILURE MONITOR</p>		
JOB NO.	DATE	REV.
10365	J-57-O	1

RIDS

8307250195

