


MAN FEED - 3500CH PER 6 @ NEUTRAL FROM INTAKE AUX. BUS 3A  
3500CH PER 6 @ NEUTRAL FROM INTAKE AUX. BUS 3B

1	2	3	4	5	6	7	8	9	10
			AL	AR		AL	AR	AL	AR
A	A	A			B	B	B	B	B
B	B	B	C	C	C	C	C	C	C
C	C	C							

UNIT 6B		UNIT 7C	
1P-20A	IP-20A	2P-20A	IP-20A
2P-20A	IP-20A	3P-20A	IP-20A
3P-20A	IP-20A	4P-20A	IP-20A
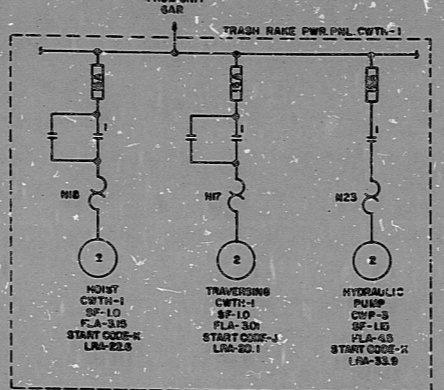

NOTE:  
FOR LEGEND - SEE SHEET EC-206-060.

1. AS BUILT PER M&E 84-06-14-01	2. AS BUILT PER M&E 84-06-14-01

PRODUCTION ENGINEERING DEPARTMENT  
ELECTRICAL  
ONE LINE-VECTOR CONTROL CENTER  
INTAKE 3

DATE: 12-4-78  
DRAWN BY: [Signature]  
CHECKED BY: [Signature]  
ELECTRICAL  
CR/3  
SCALE: AS SHOWN  
SHEET NO: EC-206-068



PDR RIDS

8902090244

