


H-86-O-SHT 3


SIZE D 22 X 34

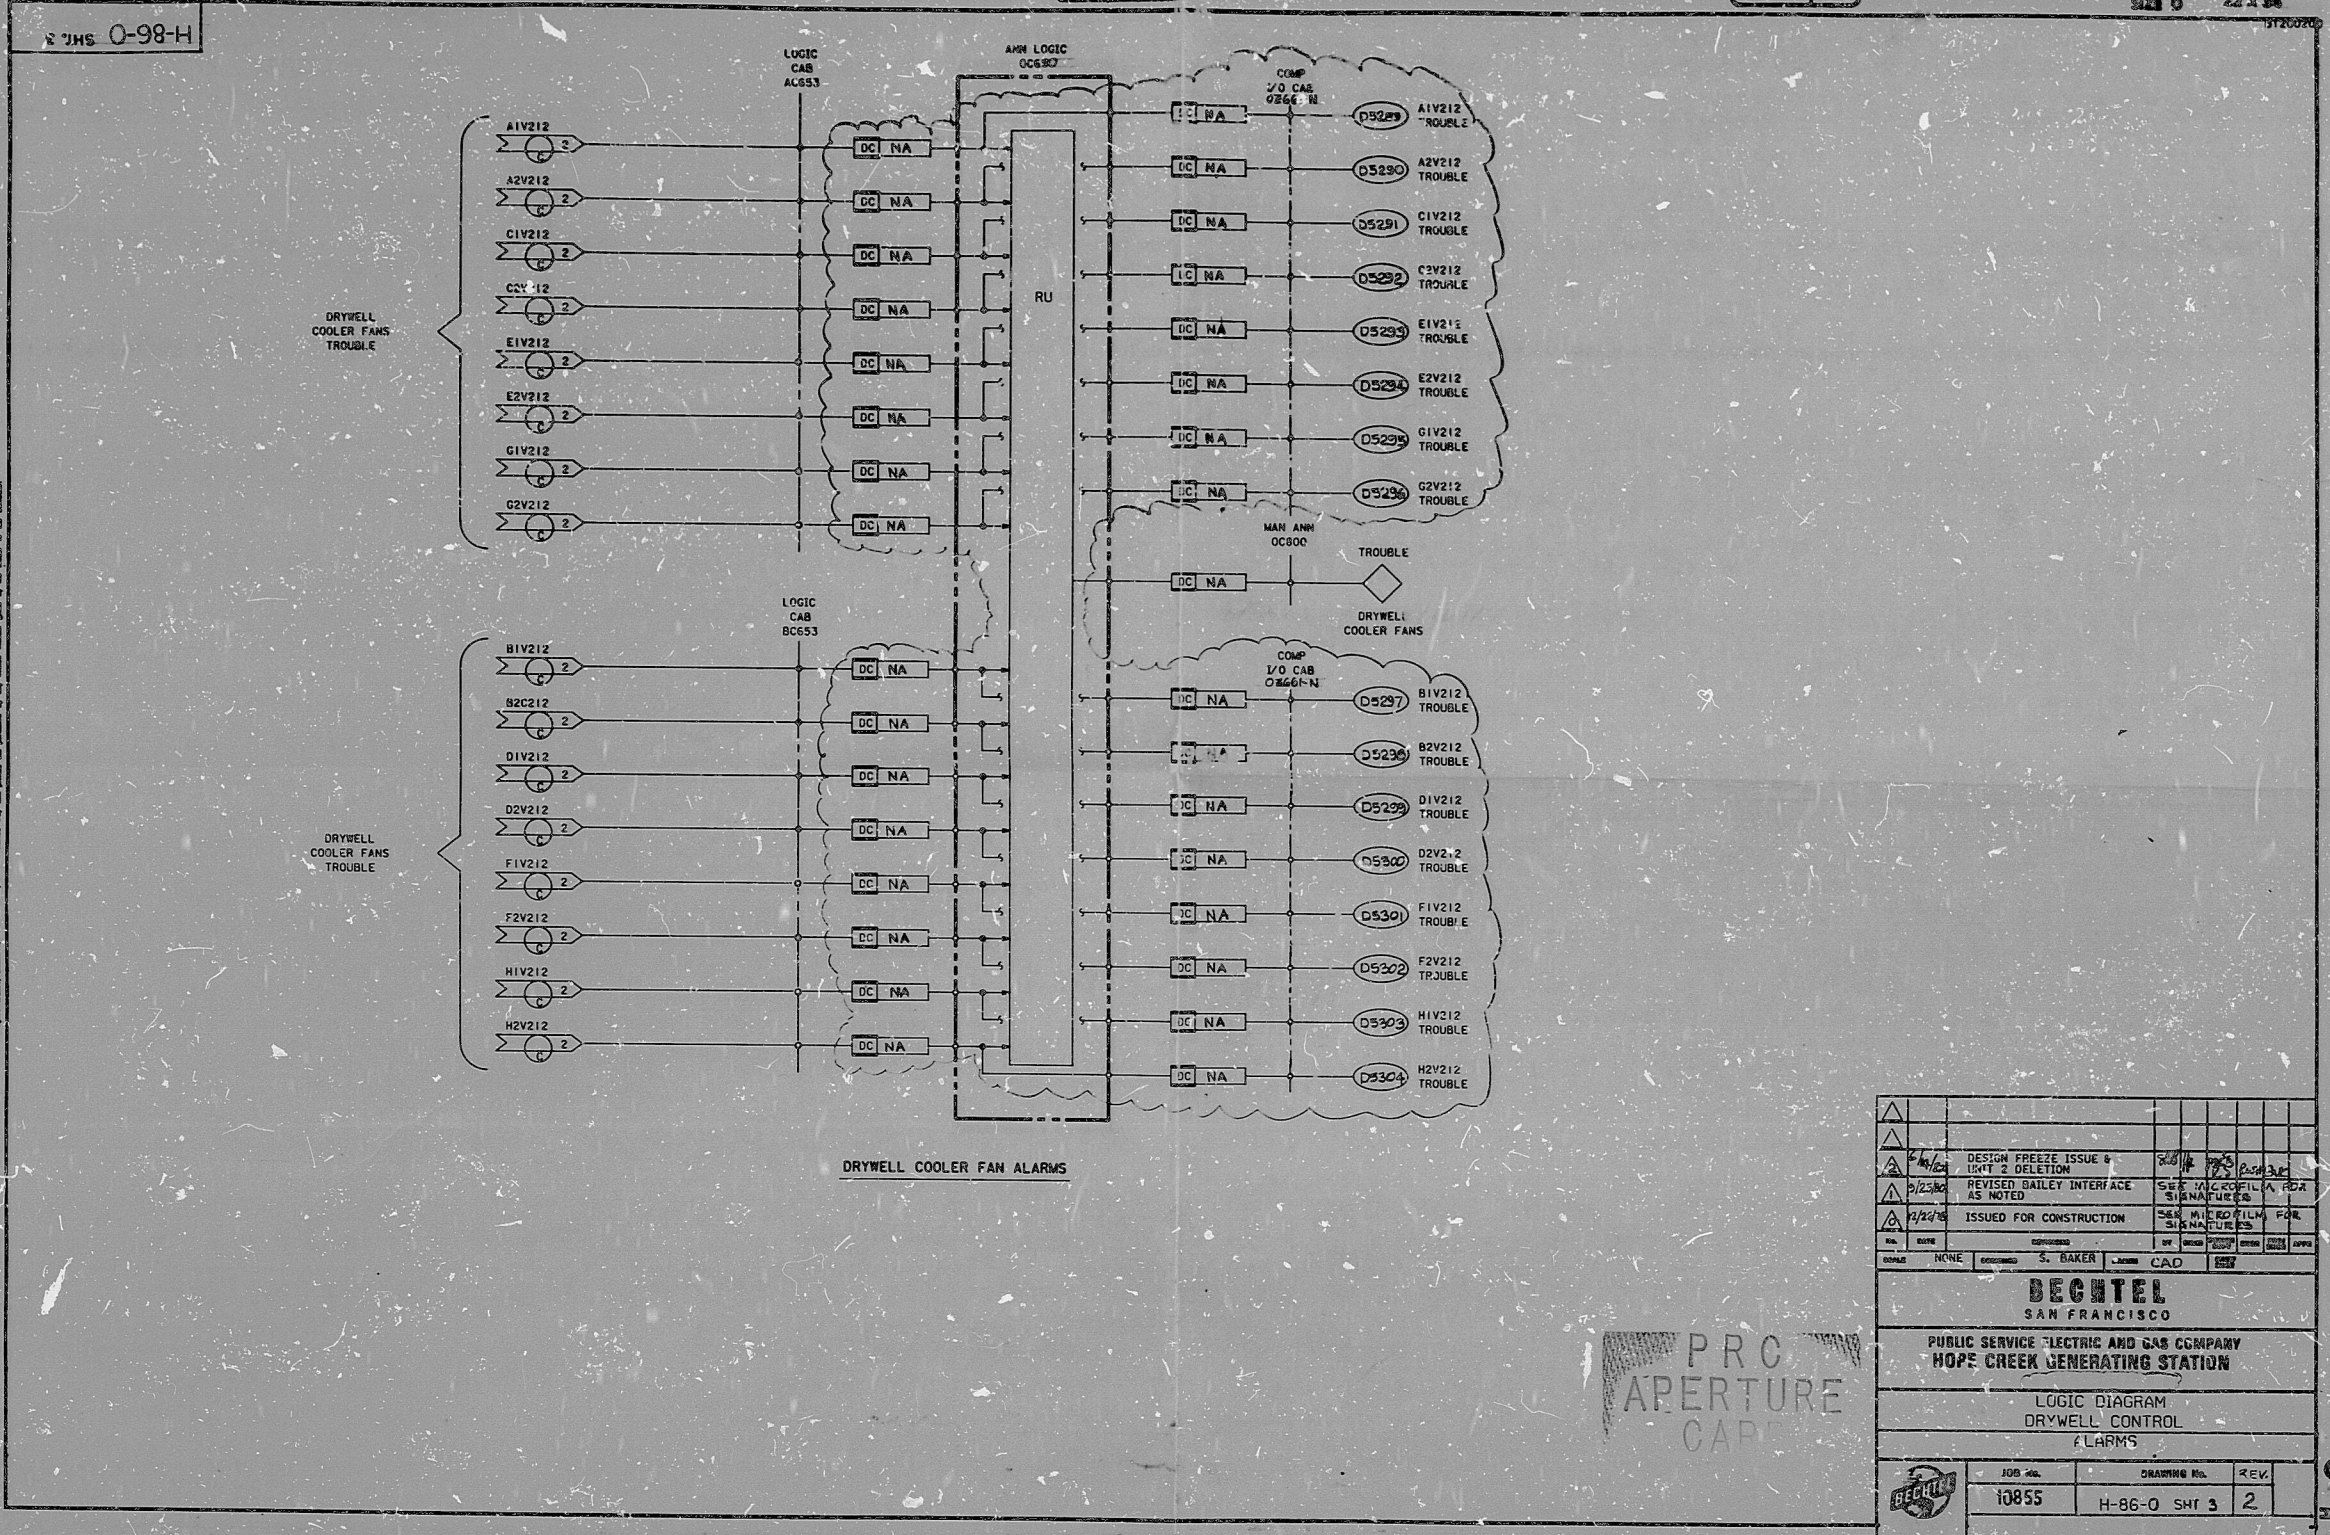

DRYWELL COOLER FAN ALARMS

△									
DATE	DESCRIPTION	BY	CHKD	APPD					
	BY BAKER	CAD							
BEUTEL SAN FRANCISCO									
PUBLIC SERVICE ELECTRIC AND GAS COMPANY HOPE CREEK GENERATING STATION									
LOGIC DIAGRAM DRYWELL CONTROL & ALARMS									
JOB No.	DRAWING No.	REV.							
10855	H-86-O-SHT 3	2							

PRO APERTURE CAP

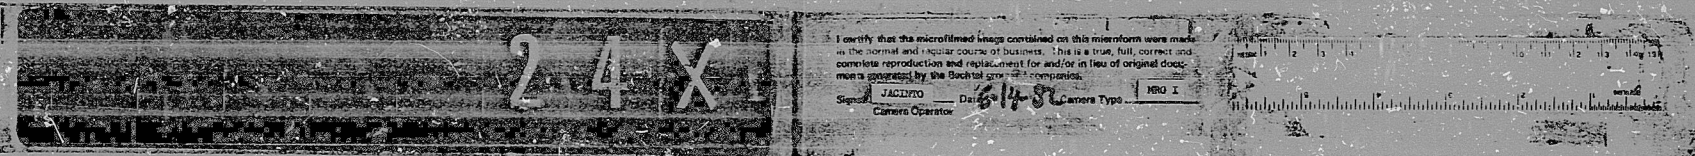


Signature: JACINTO Date: 6-14-84 Camera Type: MBO 2

RIDS

8307250205

