


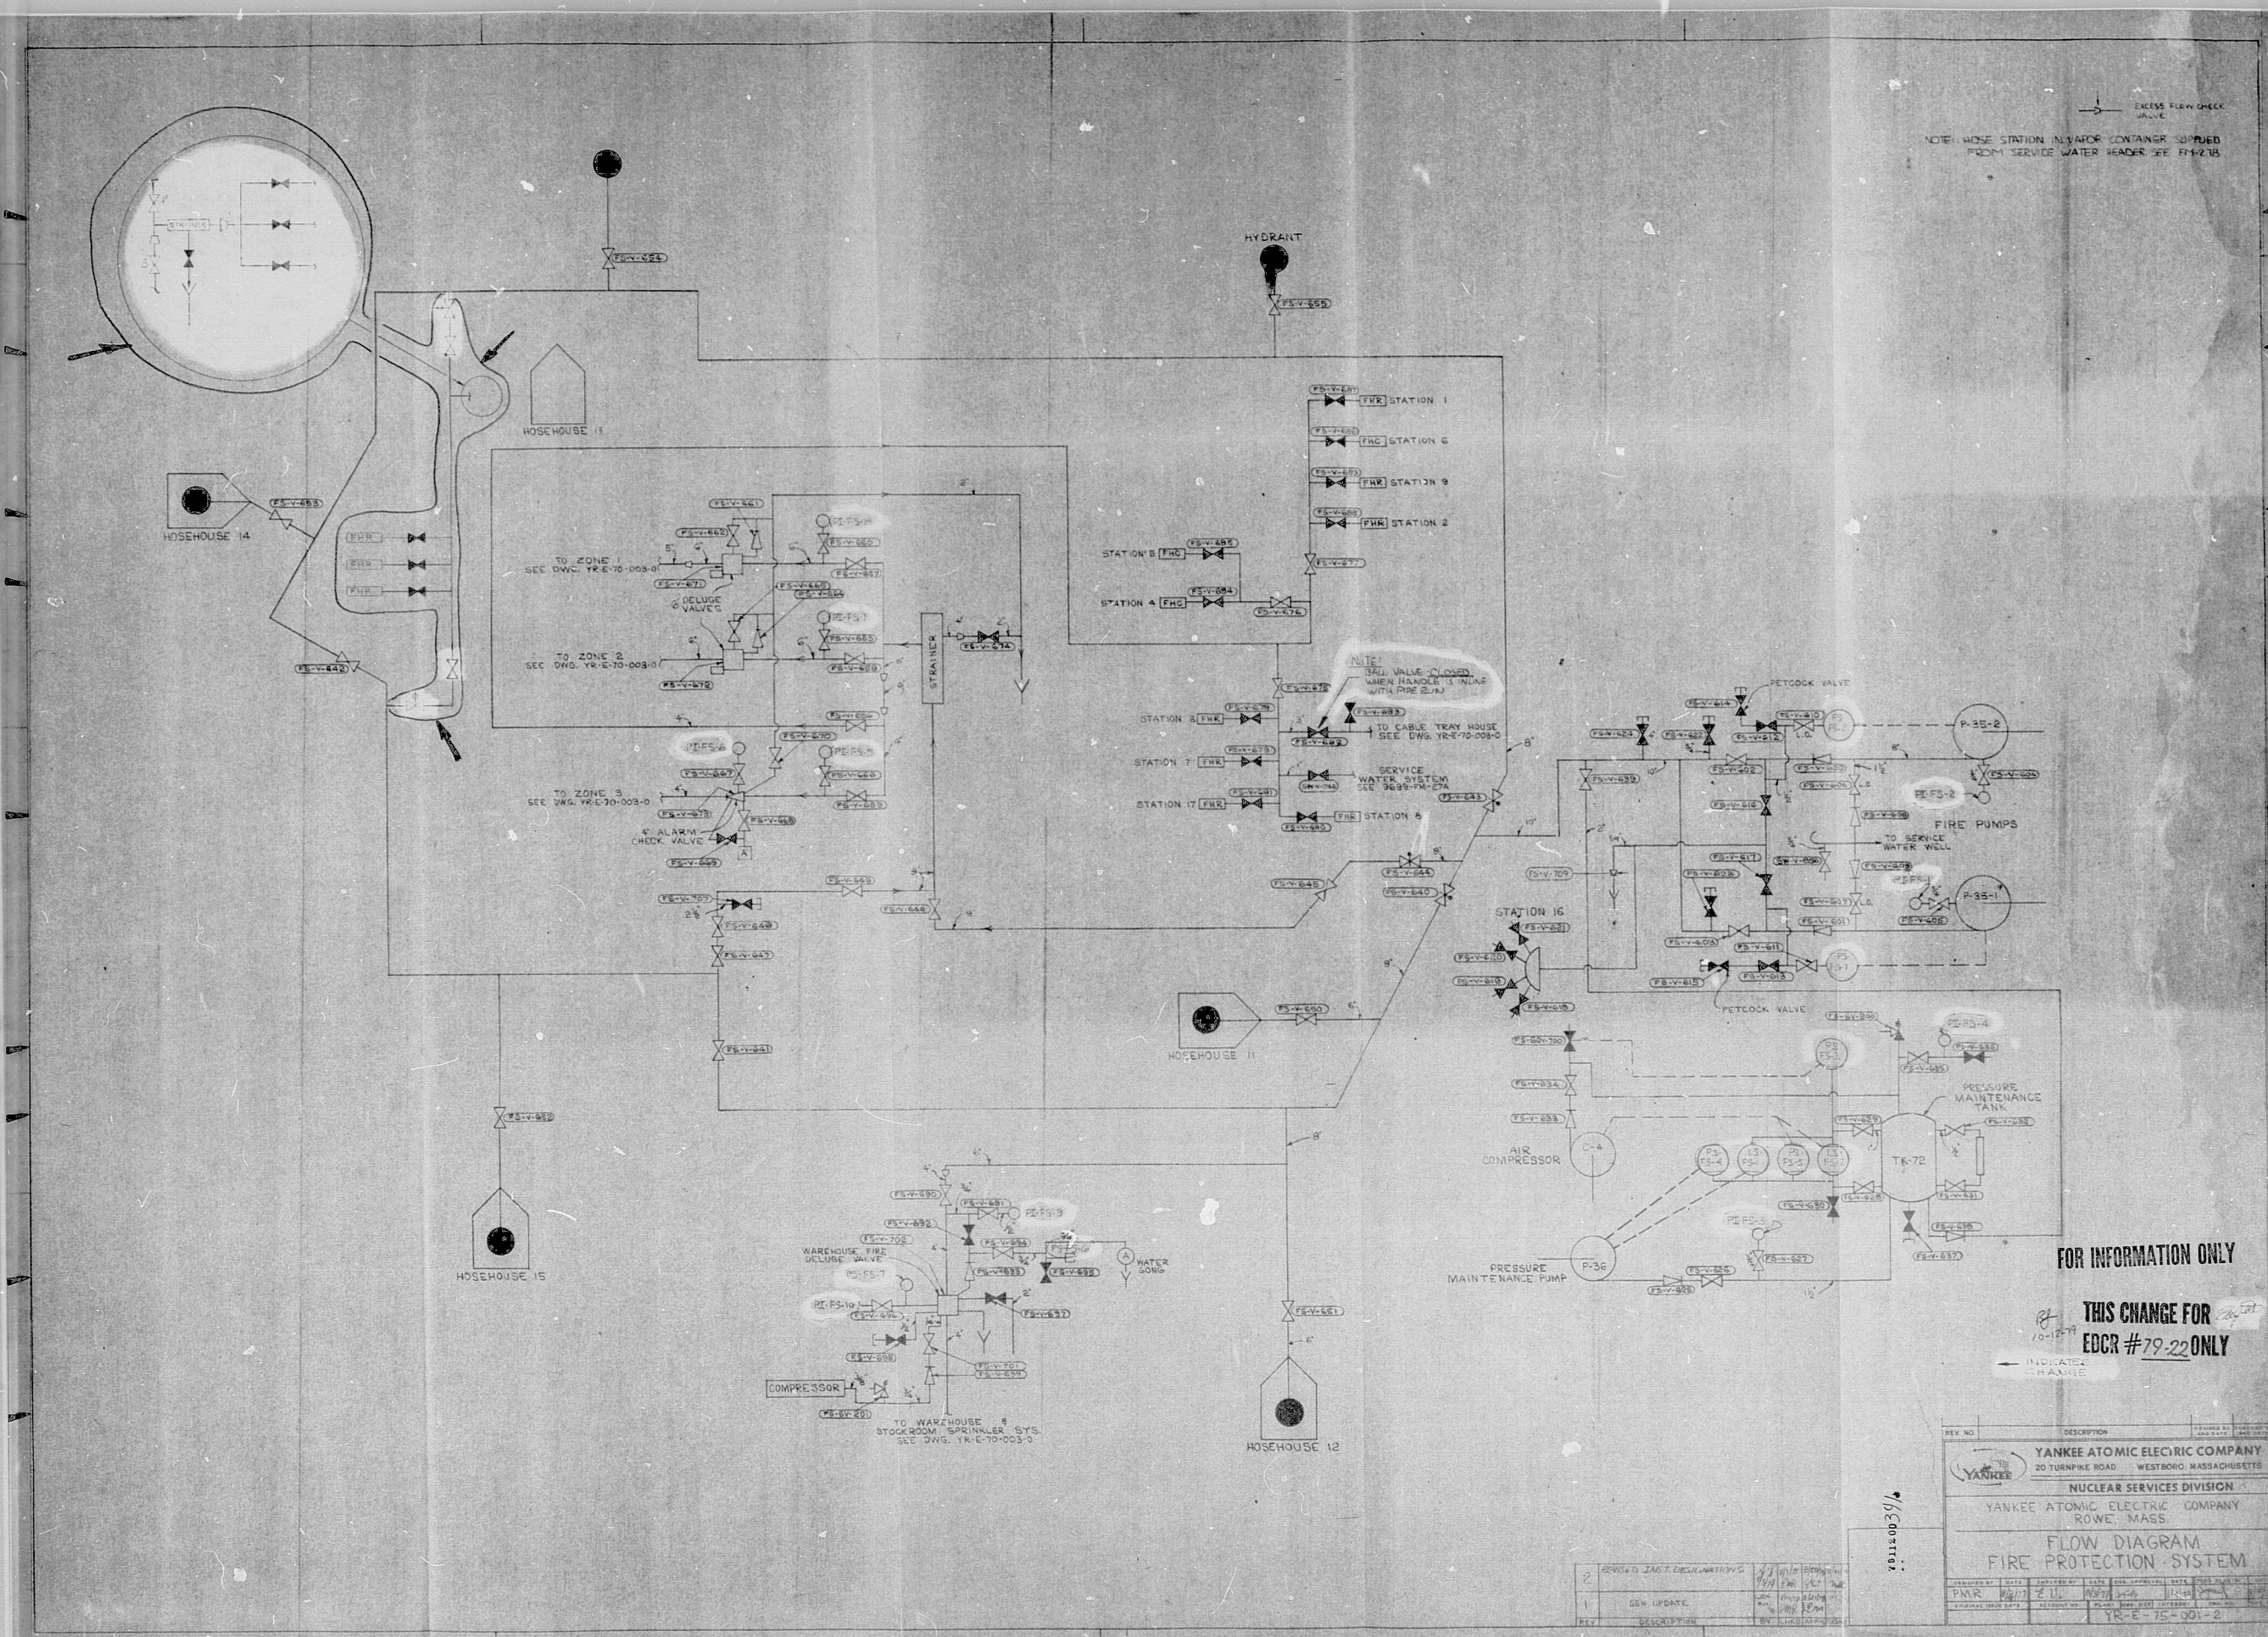

7911200341

