


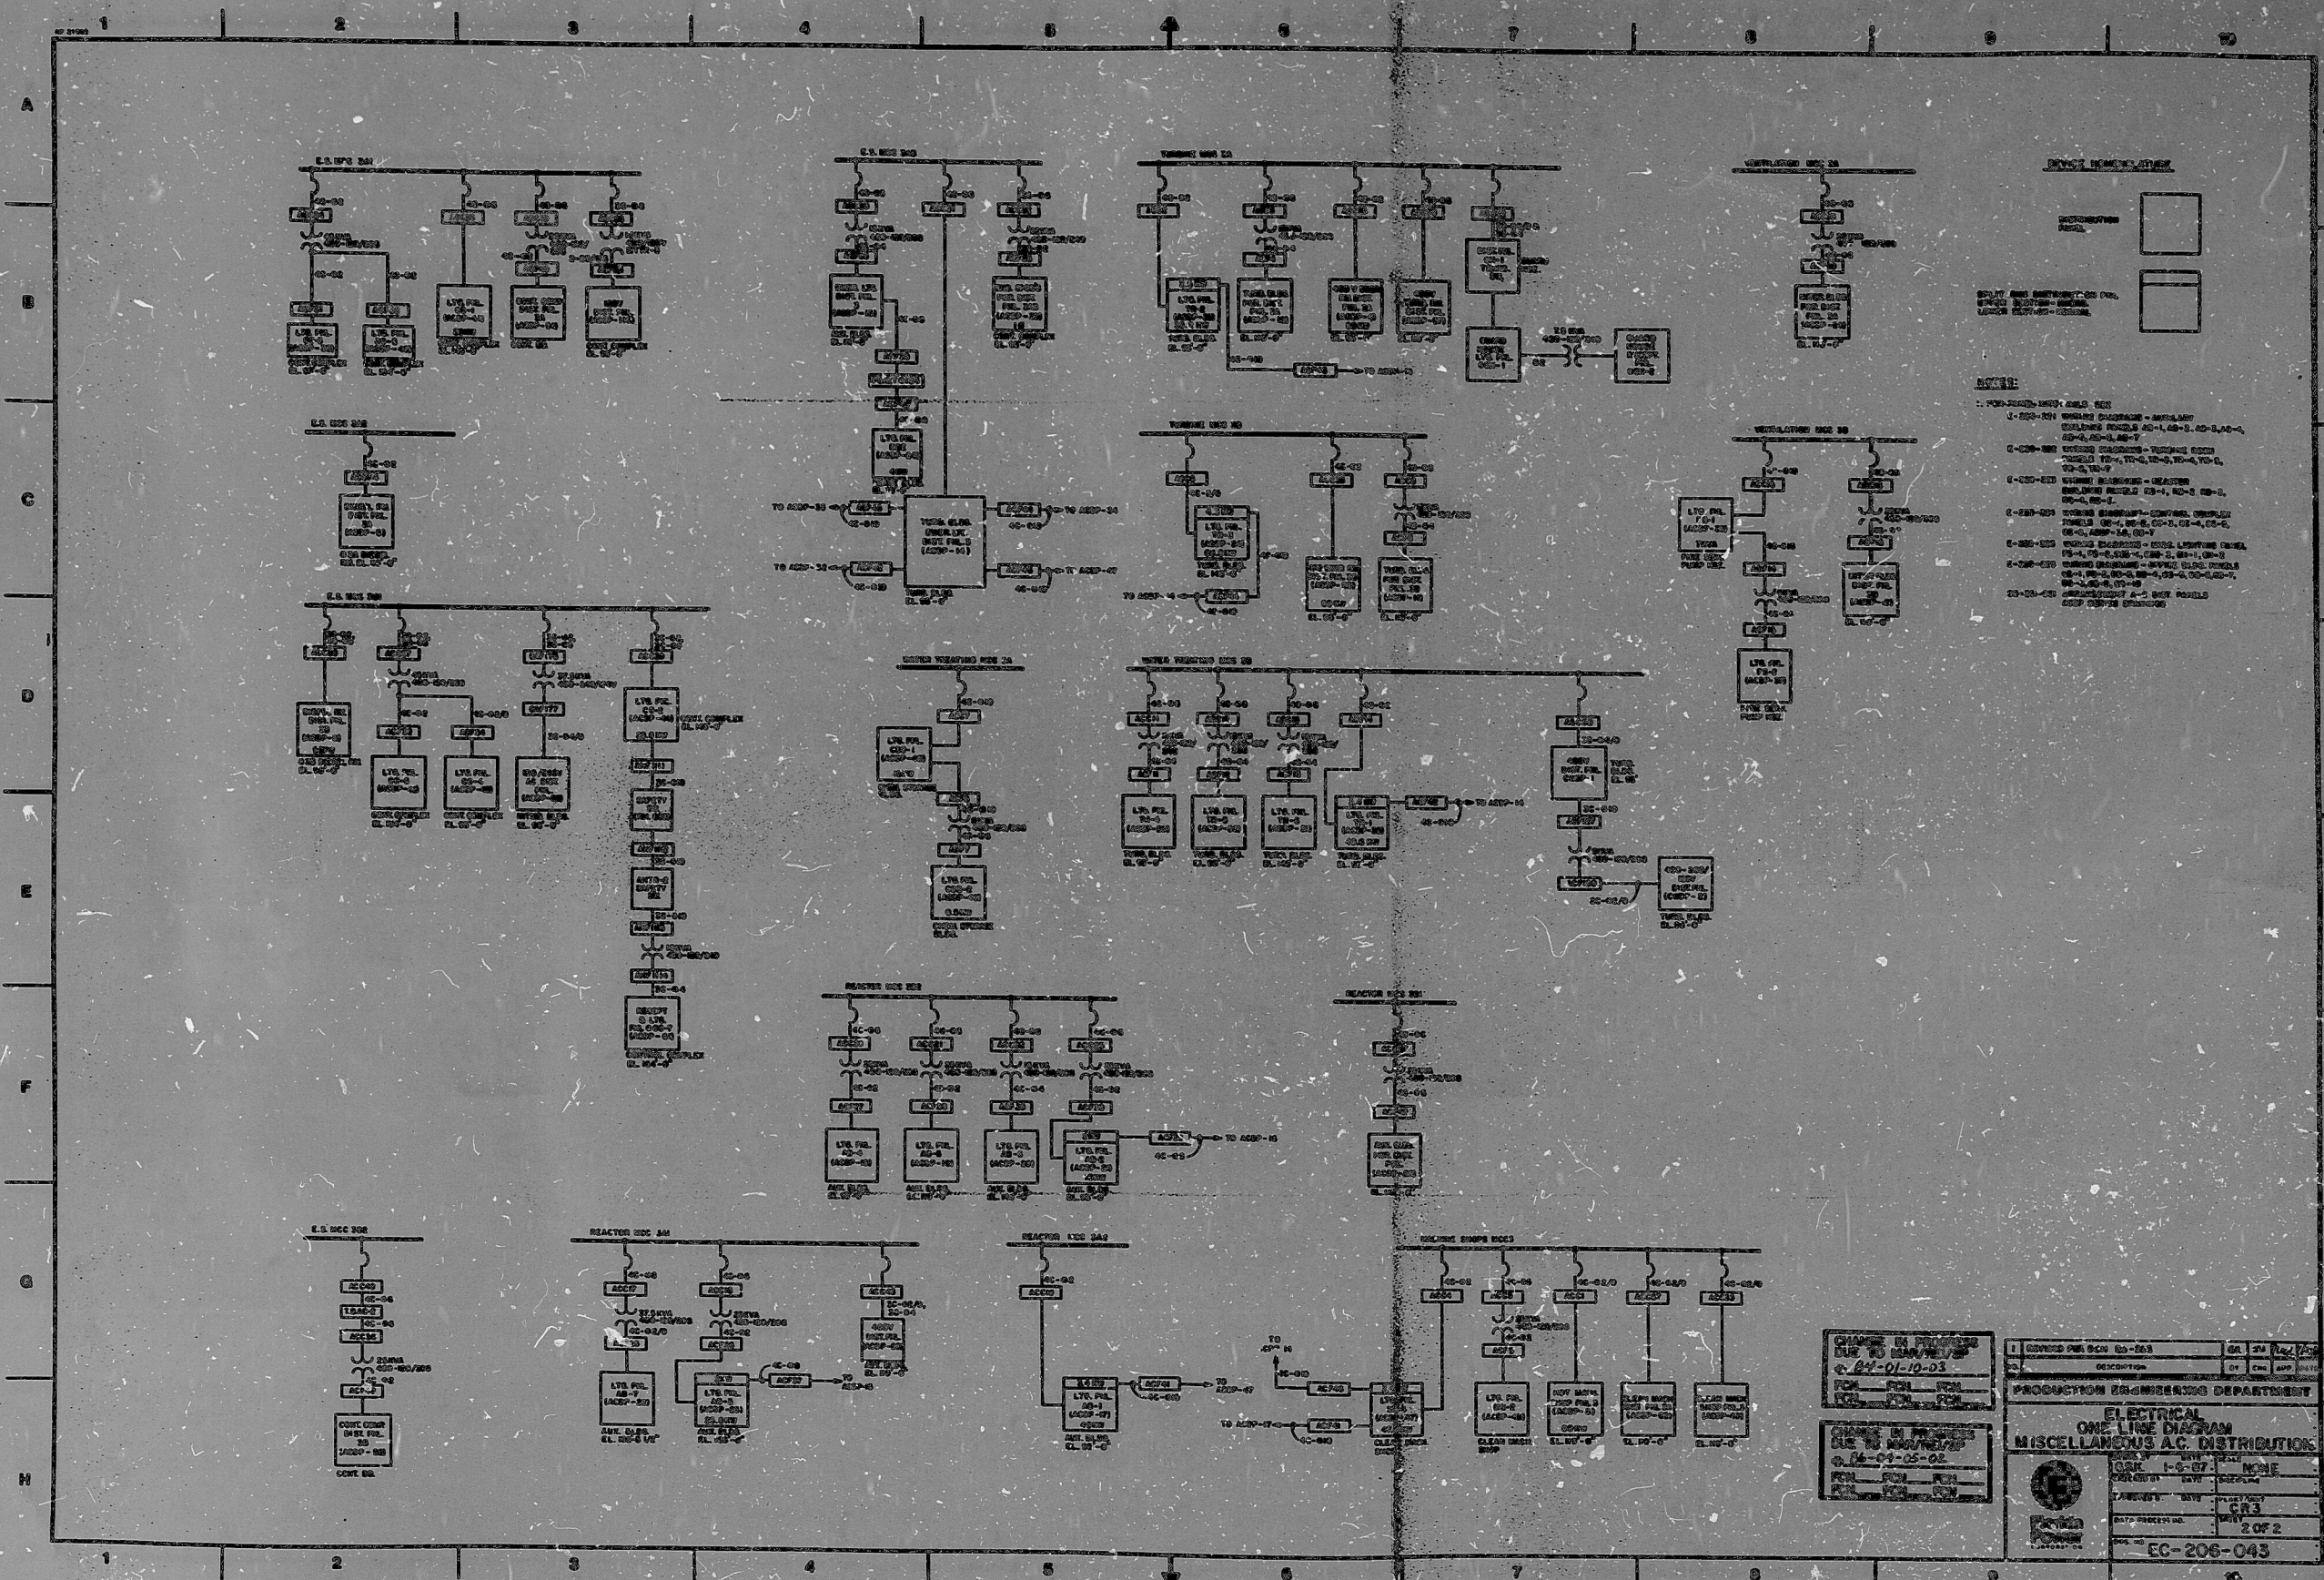



PDR RIDS

8902090 506

