


H-90-0 SHT 6 Q

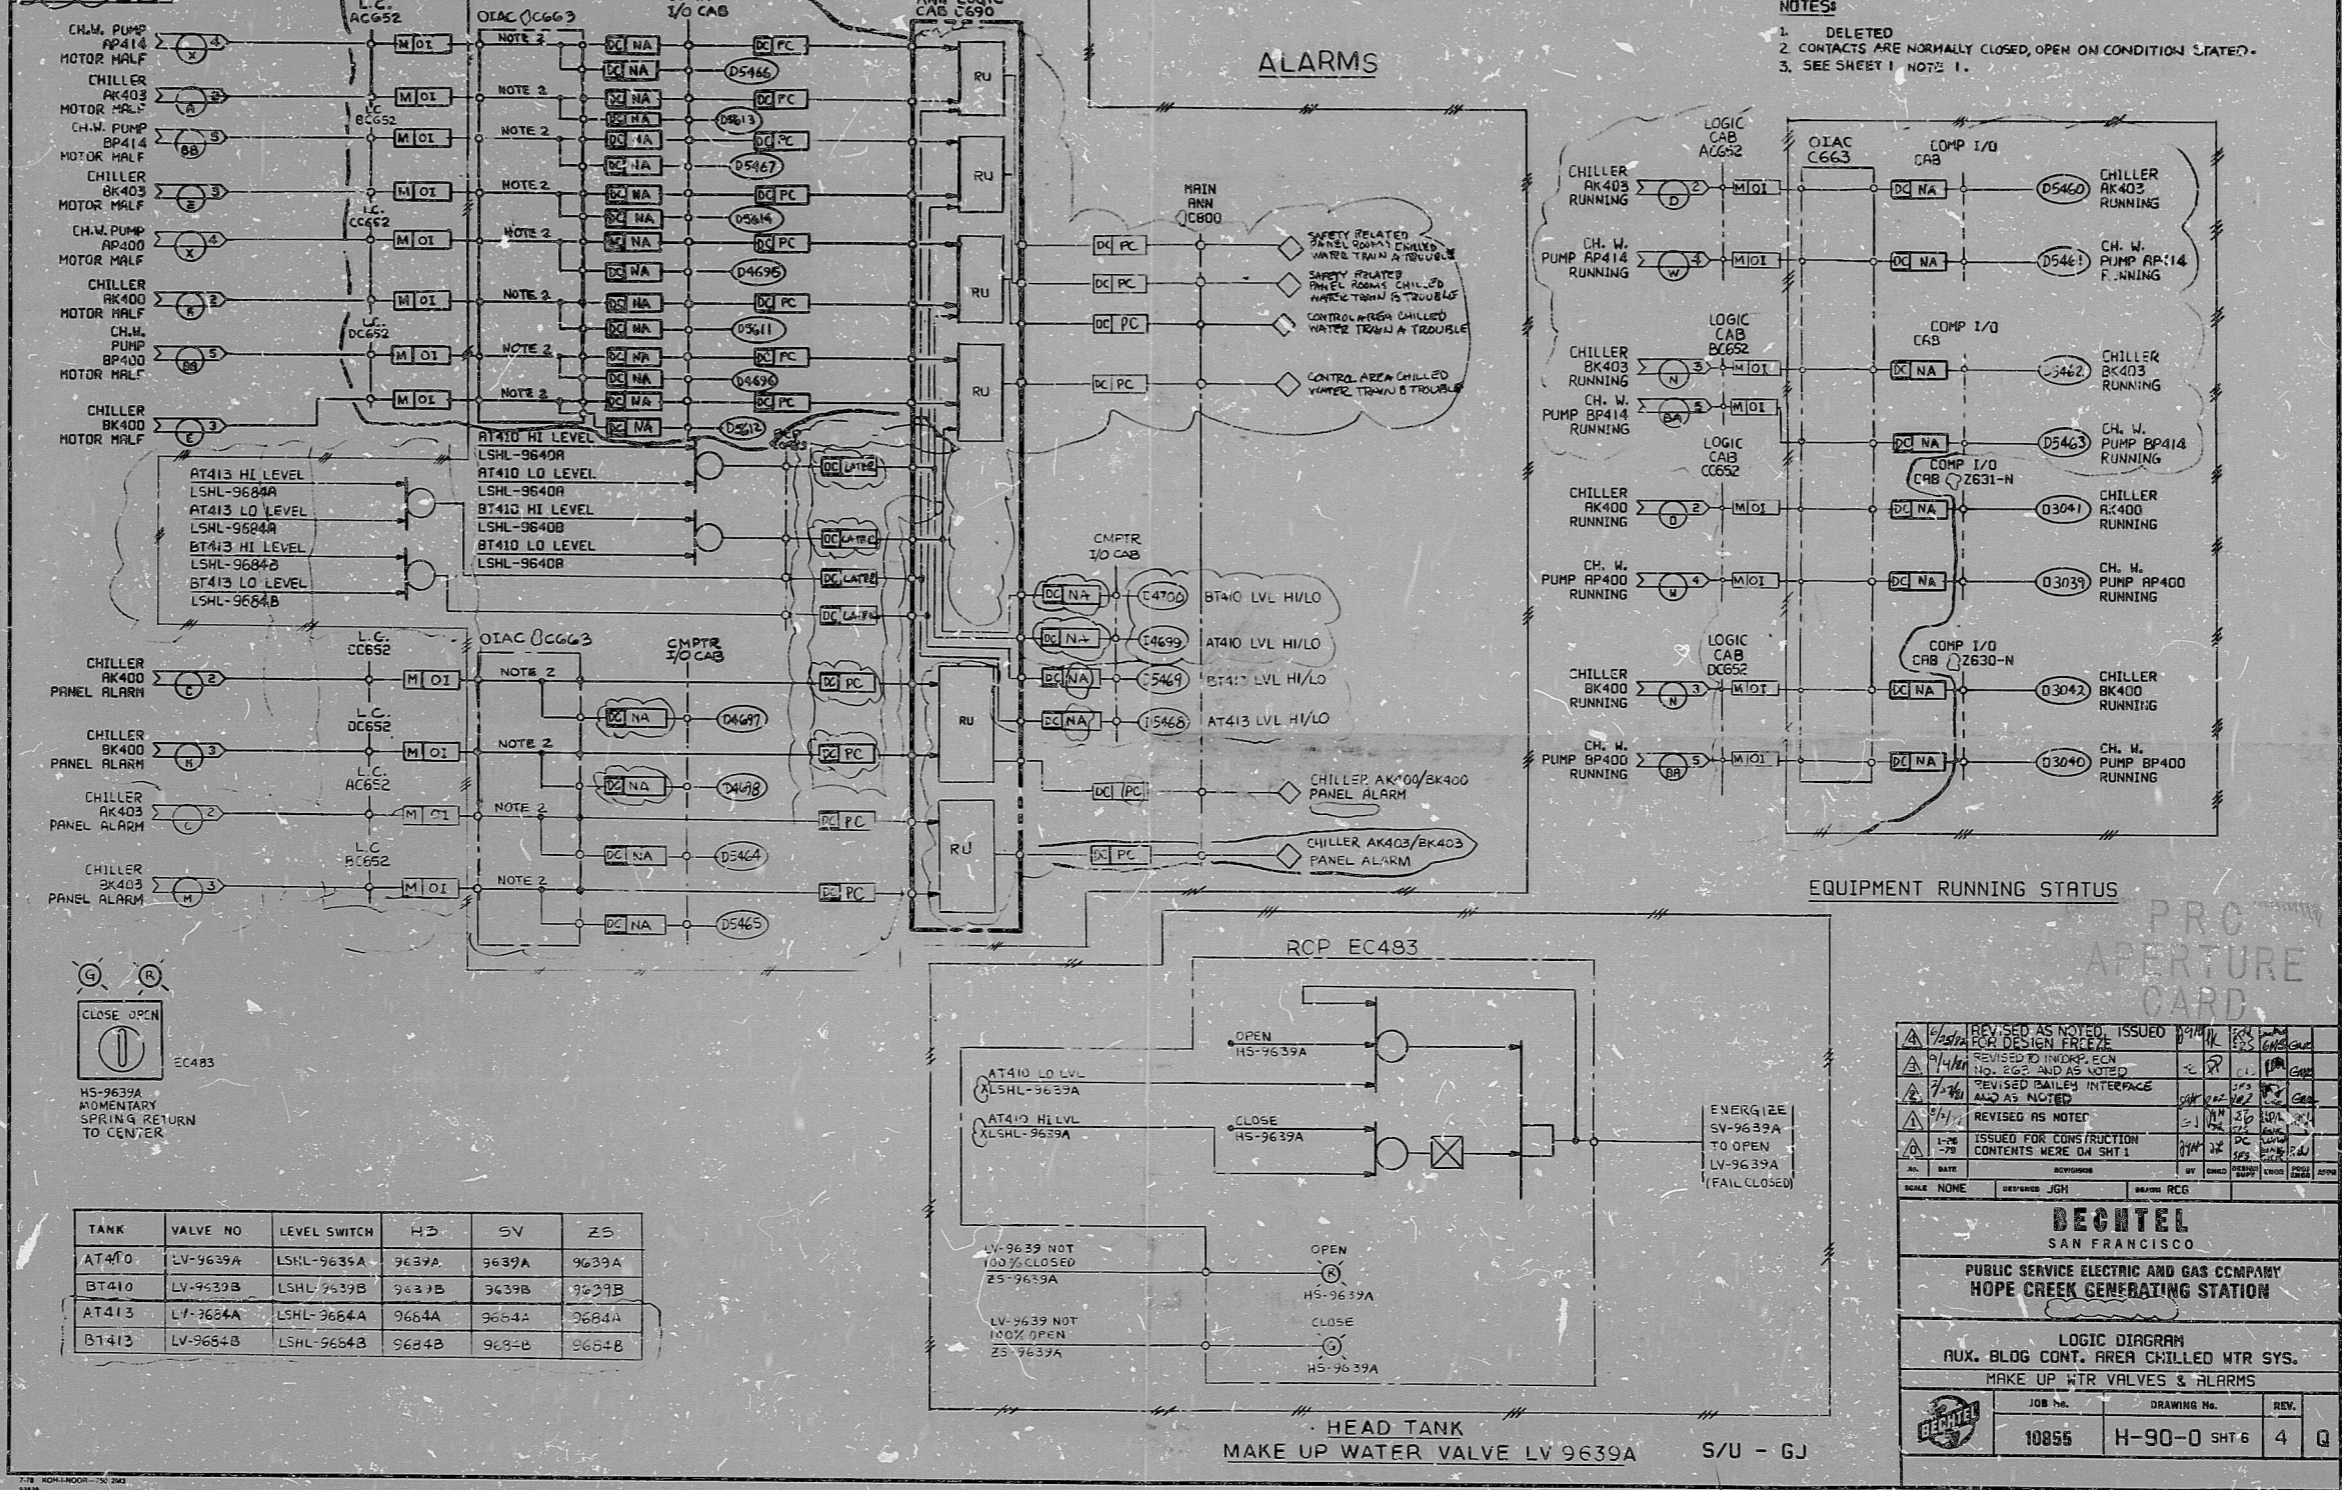

This drawing and its design are the property of BECHTEL. They are hereby loaned and on the borrower's express agreement that they will not be reproduced, copied, transmitted, or used in any way without express consent of the licensor.

TANK	VALVE NO.	LEVEL SWITCH	HD	SV	ZS
AT410	LV-9639A	LSHL-9639A	9639A	9639A	9639A
BT410	LV-9639B	LSHL-9639B	9639B	9639B	9639B

- NOTES
1. DELETED
  2. CONTACTS ARE NORMALLY CLOSED, OPEN ON CONDITION STATED.
  3. SEE SHEET I, NOTE 1.

NO.	DATE	REVISION	BY	CHKD.	APP'D.

**BECHTEL**  
SAN FRANCISCO

PUBLIC SERVICE ELECTRIC AND GAS COMPANY  
HOPE CREEK GENERATING STATION

LOGIC DIAGRAM  
AUX. BLOC CONT. AREA CHILLED WTR SYS.  
MAKE UP WTR VALVES & ALARMS

JOB No.	DRAWING No.	REV.
10856	H-90-0 SHT 6	4 Q

HEAD TANK MAKE UP WATER VALVE LV 9639A S/U - GJ

24X

I certify that the microfilm image contained in this microform was made in the normal and regular course of business. This is a true, full, correct and complete reproduction and replacement for and/or in lieu of original documents generated by the Bechtel group of companies.

Signed: **DANNY** Date: **78** Camera Type: **MRG 1**  
Camera Operator

RIDS

8307250294

