


INFORMATION
THIS DOCUMENT IS
SUBJECT TO REVISION
WITHOUT NOTIFICATION
TO THE USER OF THIS
COPY

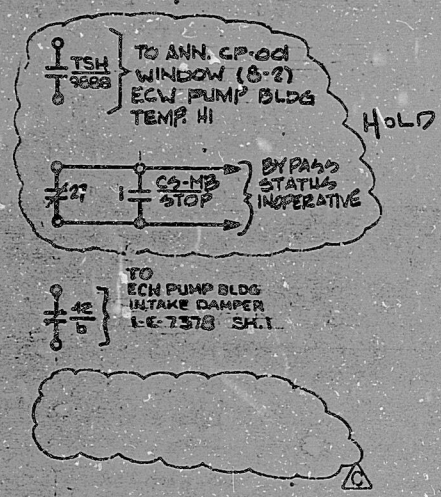

CS-MB (15160)

BLOCK	CONTACT	POSITION	USE
A	NC (1)	X	CONT
	NO (2)		CONT
B	NC (3)	X	CONT
	NO (4)	X	SP

MAINTAINED CONTACTS
X-DENOTES CONTACTS CLOSED
G.E. CAT. #CR2940UB203C



LCS-17372

BLOCK	CONTACT	POSITION	USE
A	NC (1)	X	SP
	NC (2)	X	CONT
B	NC (3)	X	SP
	NO (4)	X	SP

MAINTAINED CONTACTS
X-DENOTES CONTACTS CLOSED
G.E. CAT. #CR2940UB203A



- REFERENCE DRAWINGS
- 0-E-0105 - ELECTRICAL WIRING STANDARDS & SYMBOLS
 - 1-Z-3510-SH.1 - ECW PUMP BLDG. HVAC VENT FANS LOGIC DIAGRAMS
 - 1-Z-3511-SH.1 - ECW PUMP BLDG HVAC VENT FANS INTAKE & OUTLET DAMPERS
 - 1-E-7372 - CONTROL WIRING DIAGRAM ECW PUMP BLDG HVAC VENT FAN IIA.
 - 1-E-4745 - ELEM. DIAGRAM ECW PUMP IIA

- LEGEND
- 20/EY-9897 - ECW PUMP BLDG VENT FAN IIA OUTLET DAMP SOLENOID VALVE (FAILS OPEN)
 - 42X - LOW VOLTAGE PICK-UP RELAY
 - 42A - 480V-MCC-EIAB-COMPT. CI
 - TSH-9885 - ECW PUMP BLDG TEMP. SWITCH CONTACT CLOSING ON HI-TEMP
 - TSH-9885-1 - ECW PUMP BLDG VENT FAN TEMP. CONT. CONTACT CLOSING ON HI-TEMP (ISOLATED)
 - 27 - LOSS OF CONTROL POWER RELAY
 - MECH. EQUIP. NO. 3V151VFN001

TERA APERTURE CARD

NUCLEAR SAFETY RELATED
CLASS I E

PKG : 007 SUFF : 051 ACT : 561


DRAWING TITLE ELECTRICAL ELEMENTARY DIAGRAM ECW PUMP BLDG HVAC VENTILATION FAN IIA	CONTRACT NO. SCALE CR-0241 NONE DRAWING NO. 4-V-15 1-E-5372-C
--	--

DATE	DESCRIPTION	BY	CHK	ENC	NOV	DATE	DESCRIPTION	BY	CHK	ENC	NOV	DATE
	ISSUED FOR USE	VI										
	REVISIONS & REISSUES FOR COMMENT											
	ISSUES FOR REVIEW & COMMENT											

Brown & Root Inc.
ENGINEERS-CONSTRUCTORS
HOUSTON, TEXAS

SOUTH TEXAS
PROJECT

BROWN & ROOT INC.
MICROFILM SERVICES

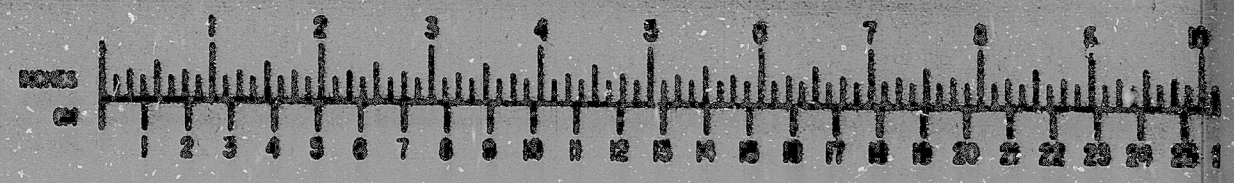

MONDAY, MAR. 26 1979

R:DB

8112100327

