

17"


11"

8.5"

8.5"

11"

17"

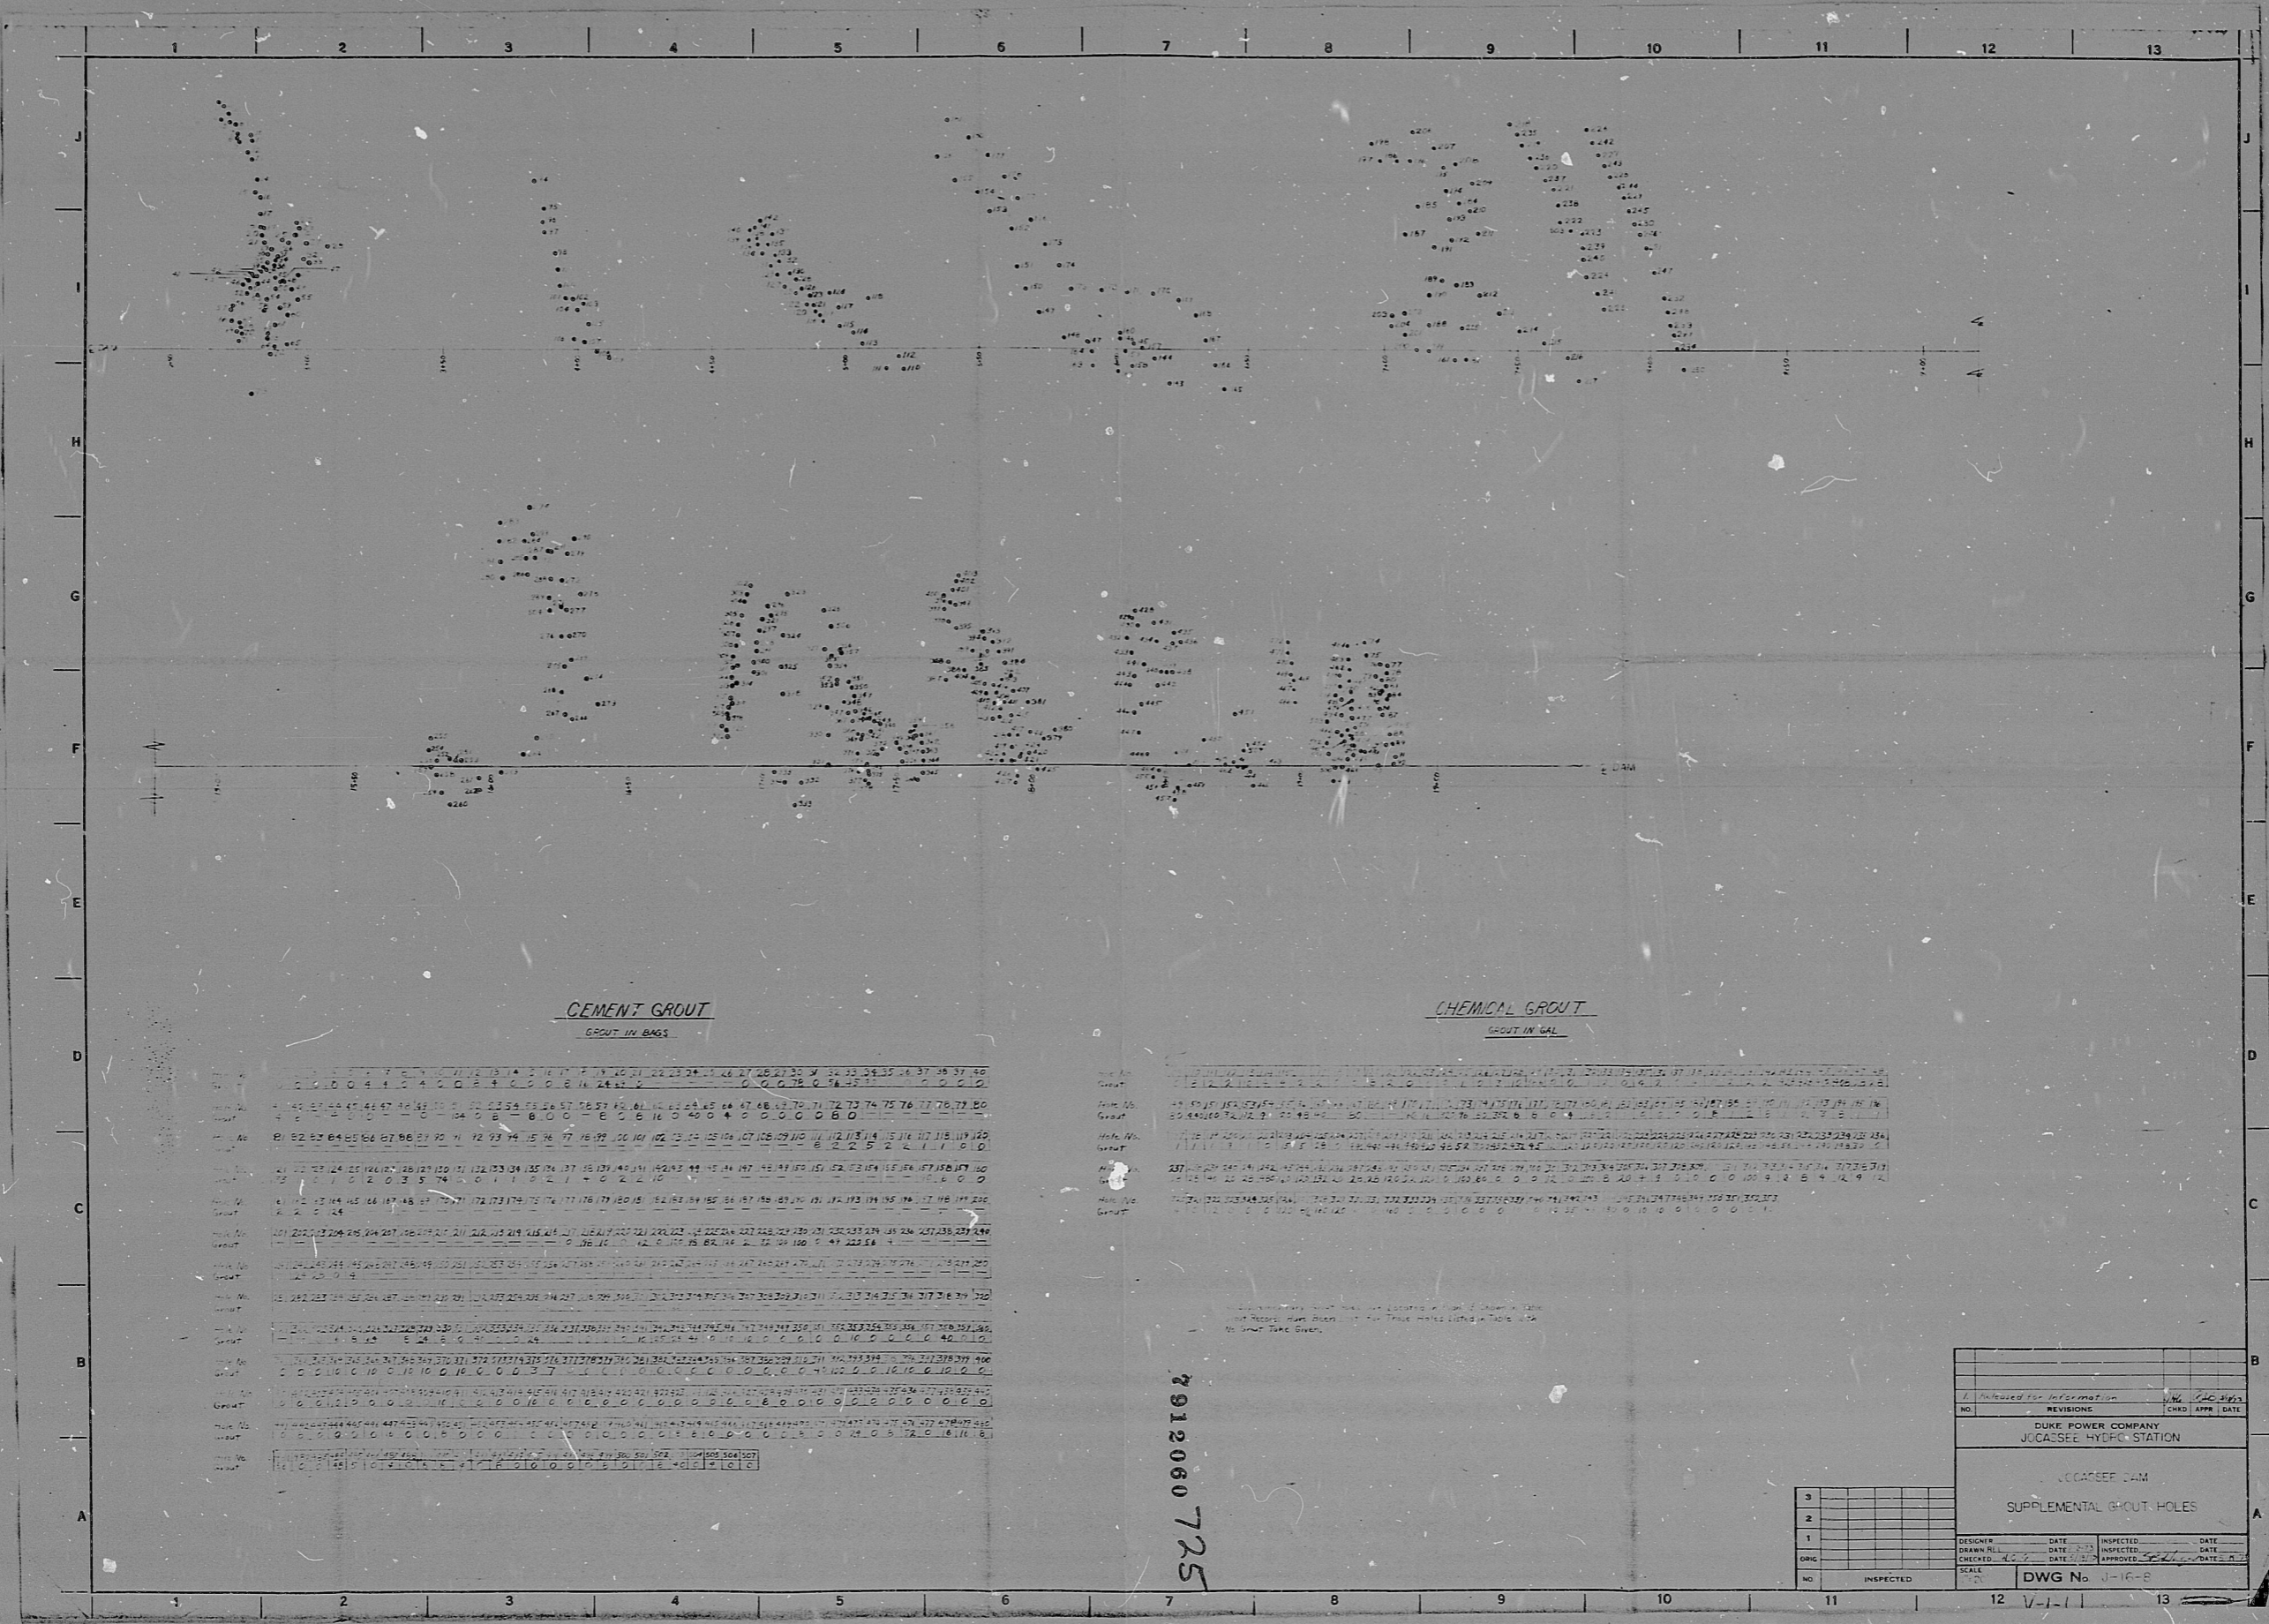

CEMENT GROUT
GROUT IN BAGS

CHEMICAL GROUT
GROUT IN GAL

7912060 725 P

3					
2					
1					
DESIGNER	DATE	INSPECTED	DATE		
DRAWN BY	DATE	INSPECTED	DATE		
CHECKED	DATE	APPROVED	DATE		
SCALE	DWG No. J-16-E				
NO.	INSPECTED				

Docket #
Control #
Date Rec'd
REGULATORY DOCKET FILE

DUKE POWER COMPANY
JUCASSEE HYDRO STATION
JUCASSEE DAM
SUPPLEMENTAL GROUT HOLES

7912060725 pdr

