


17" 11" 8.5" 8.5" 11" 17"

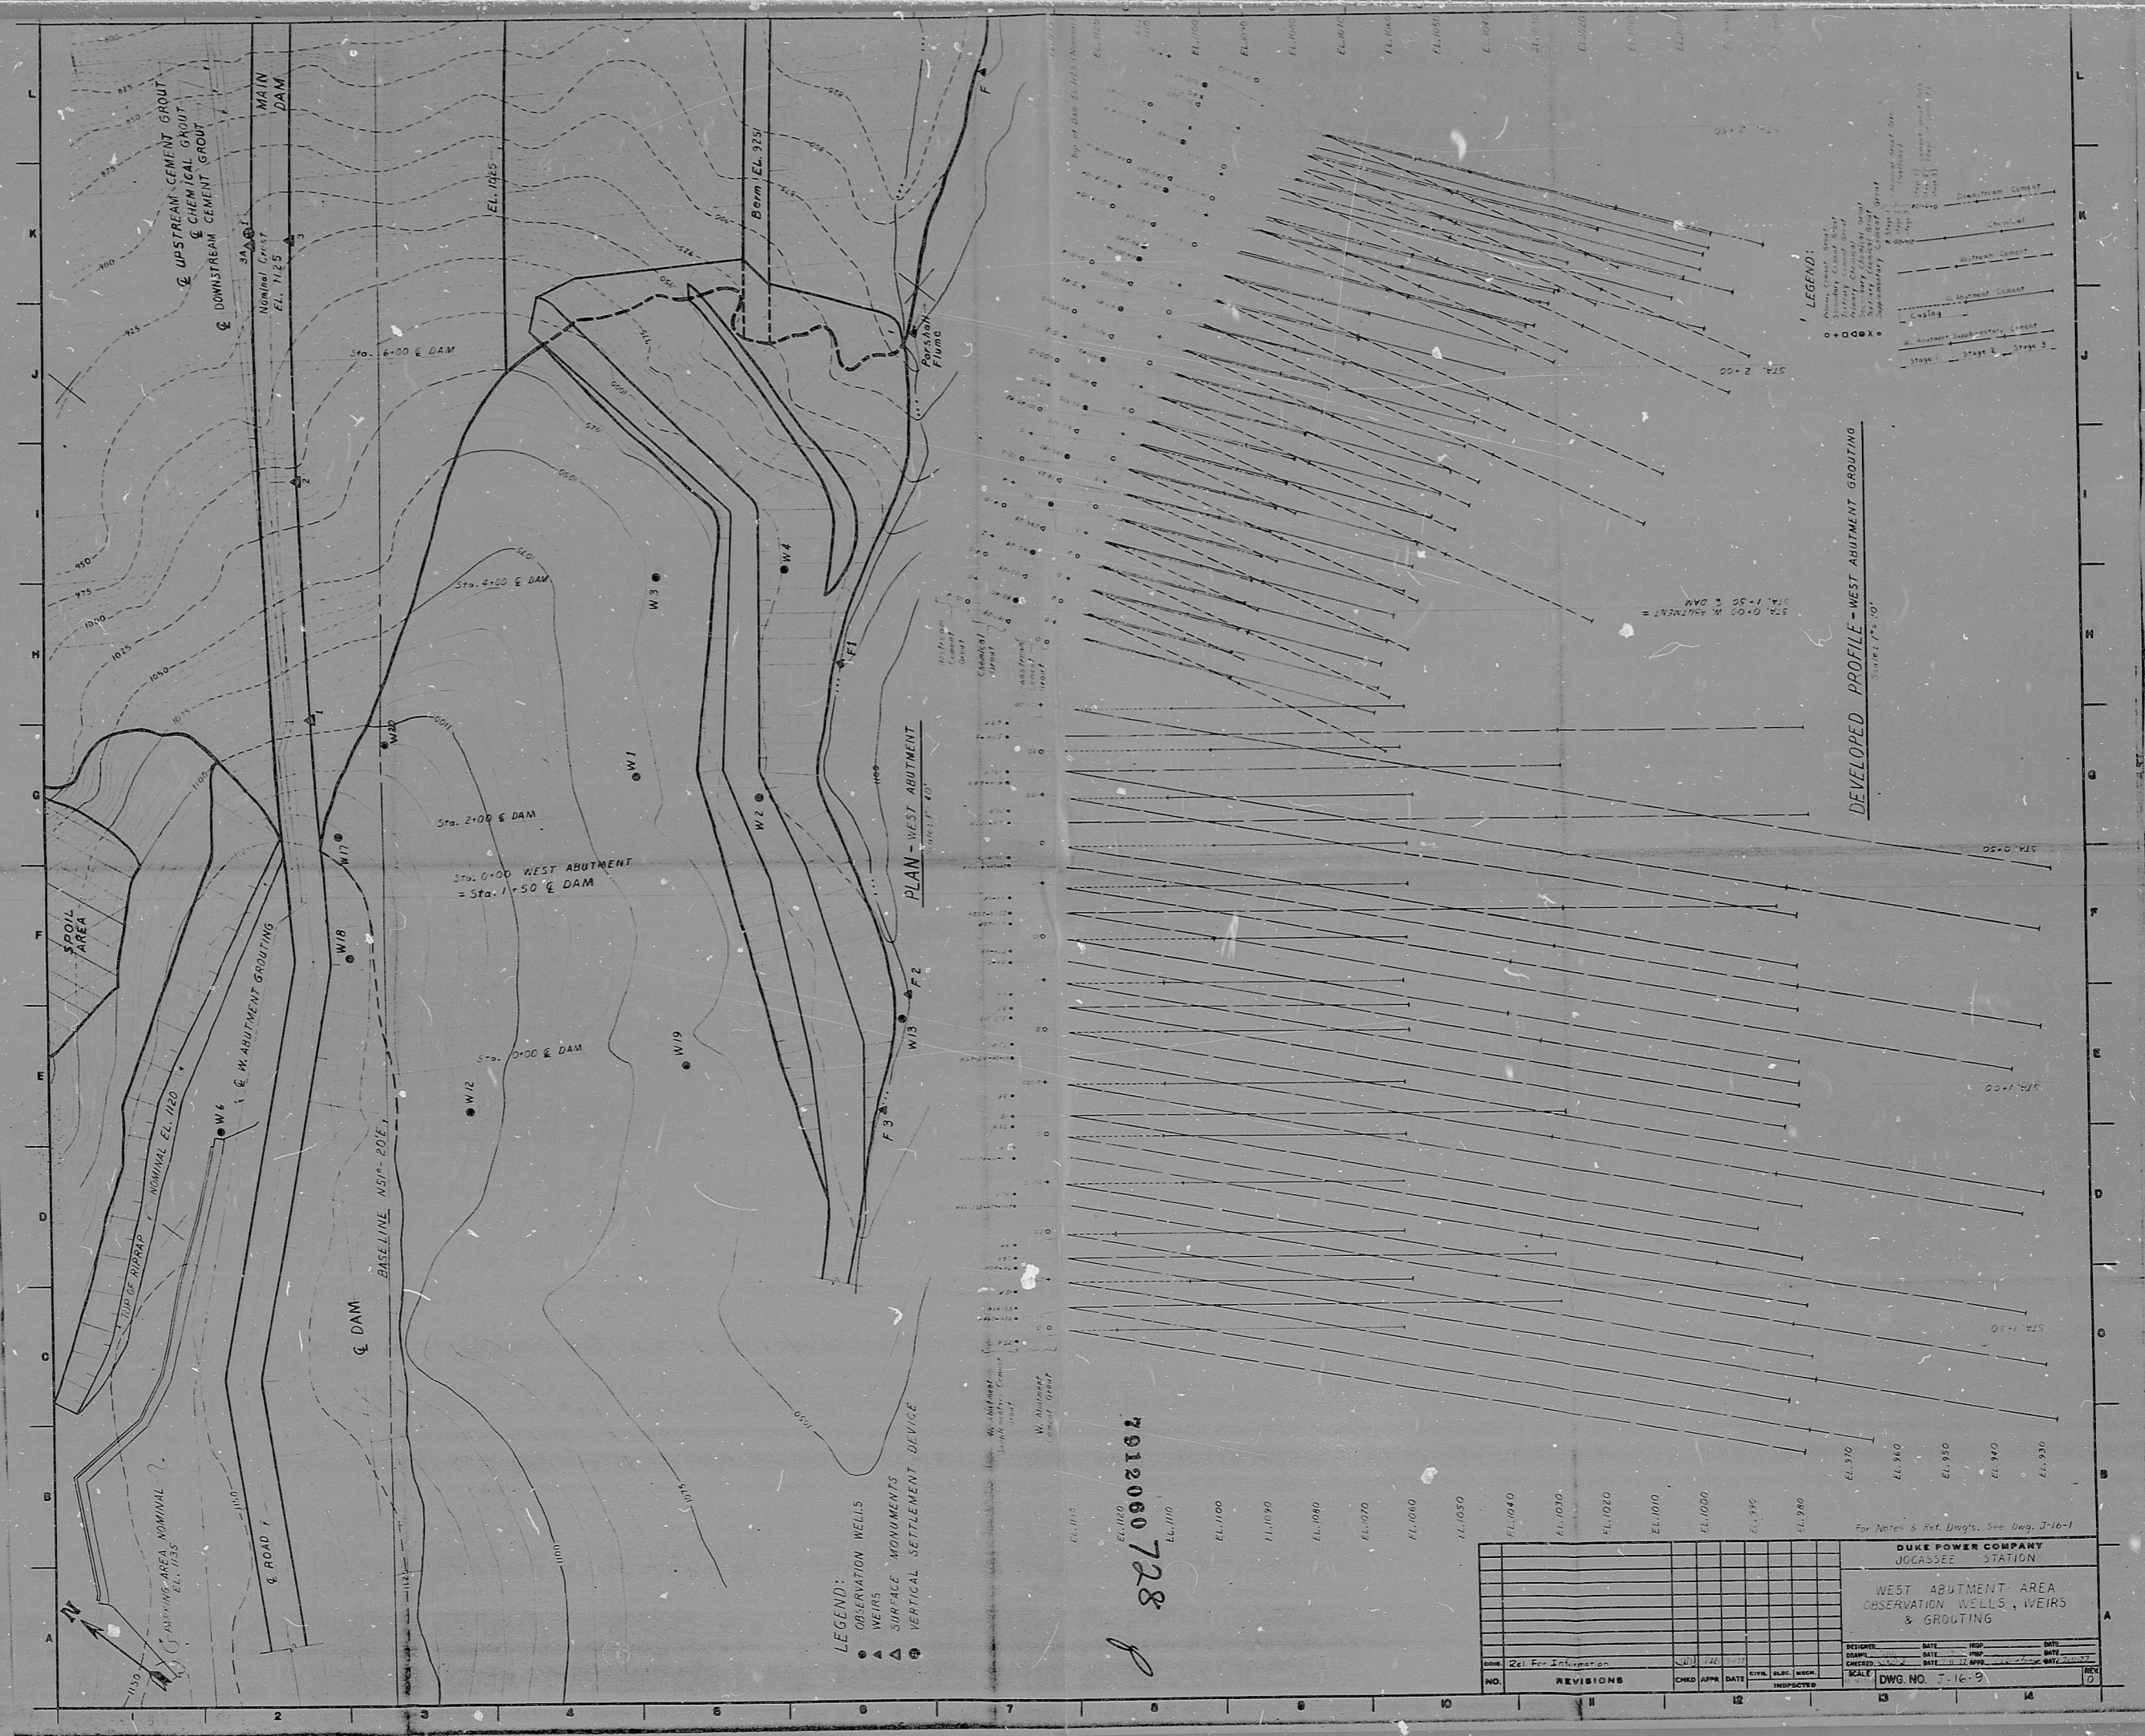

LEGEND:
 ● OBSERVATION WELLS
 ▲ WEIRS
 ▲ SURFACE MONUMENTS
 ⊕ VERTICAL SETTLEMENT DEVICE

7912060 728

NO.		REVISIONS		CHKD	APPR	DATE	BY	DATE	INSPECTED

DESIGNED	DATE	ISSUED	DATE
DRAWN	DATE	CHKD	DATE
CHECKED	DATE	BY	DATE

SCALE: DWG. NO. 7-16-9

DUKE POWER COMPANY
 JOCASSEE STATION

WEST ABUTMENT AREA
 OBSERVATION WELLS, WEIRS
 & GROUTING

LEGEND:
 --- STAGE 1
 --- STAGE 2
 --- STAGE 3

Doc # 50-268
 County # 77240013
 Date 1-17-77 of Documents
 REGULATORY DOCUMENT FILE

7912060728 pdr

