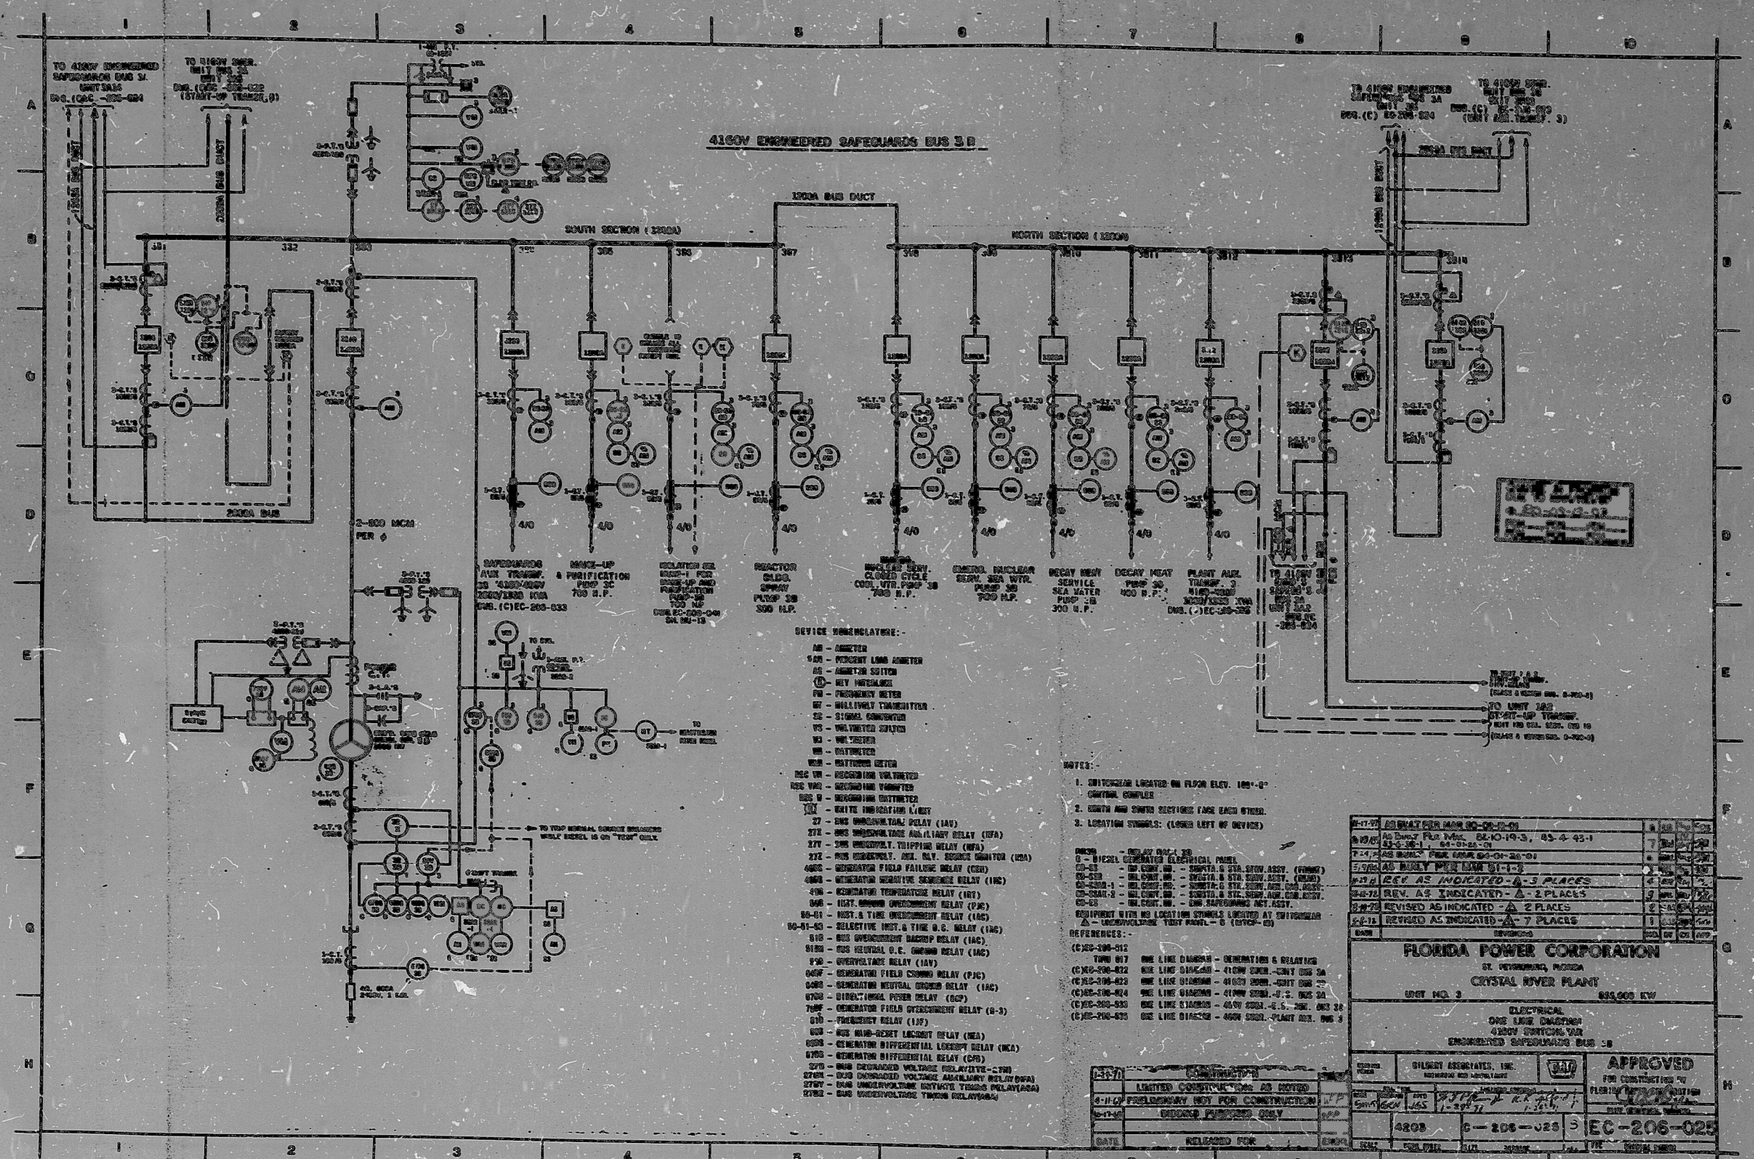
4160V ENGINEERED SAFEGUARDS BUS 3B
SOUTH SECTION (1200A)
NORTH SECTION (1200A)
1200A BUS DUCT
2000A BUS
SAFEGUARDS AUX TRANSF. 2B
MAKE-UP & PURIFICATION PUMP 3C 700 H.P.
REACTOR BLDG. SPRAY PUMP 3B 300 H.P.
EMERG. NUCLEAR SERV. SEA WTR. PUMP 3B 700 H.P.
DECAY HEAT SERVICE SEA WATER PUMP 3B 300 H.P.
DECAY HEAT PUMP 3B 400 H.P.
PLANT AUX. TRANSF. 3
DEVICE NOMENCLATURE:-
NOTES:-
REFERENCES:-
FLORIDA POWER CORPORATION
ST. PETERSBURG, FLORIDA
CRYSTAL RIVER PLANT
UNIT NO. 3
ELECTRICAL
ONE LINE DIAGRAM
4160V SWITCHGEAR
ENGINEERED SAFEGUARDS BUS 3B
GILBERT ASSOCIATES, INC.
APPROVED
FOR CONSTRUCTION
EC-206-025

PDR RIDS

8902100037

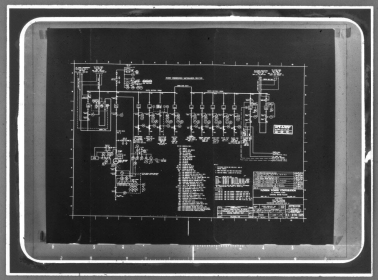

MMM 5824 — FILMSORT® Broad Aperture 8 Camera Cards and DUPLICARD® Broad Copy Cards — Product of 3M — St. Paul, Minn.