




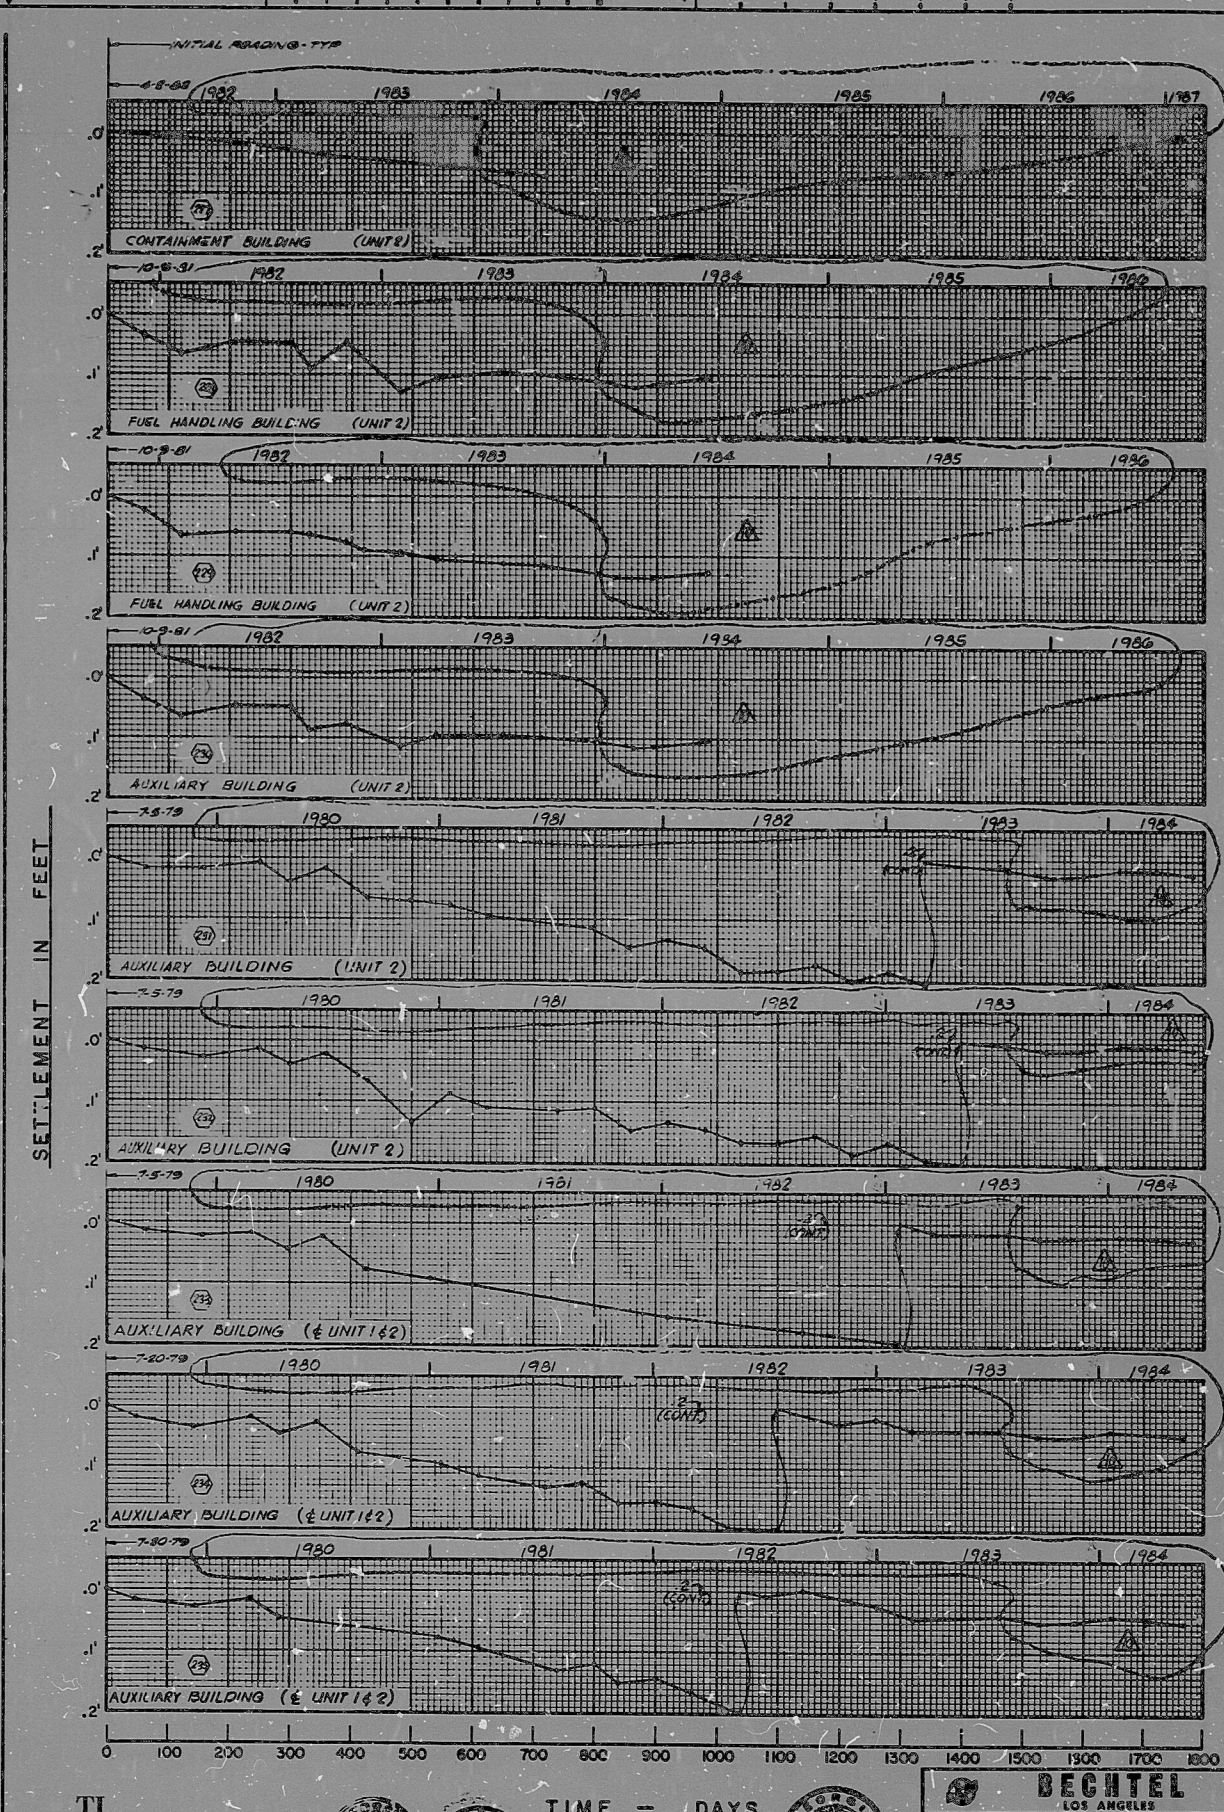

TI
APERTURE
CARD

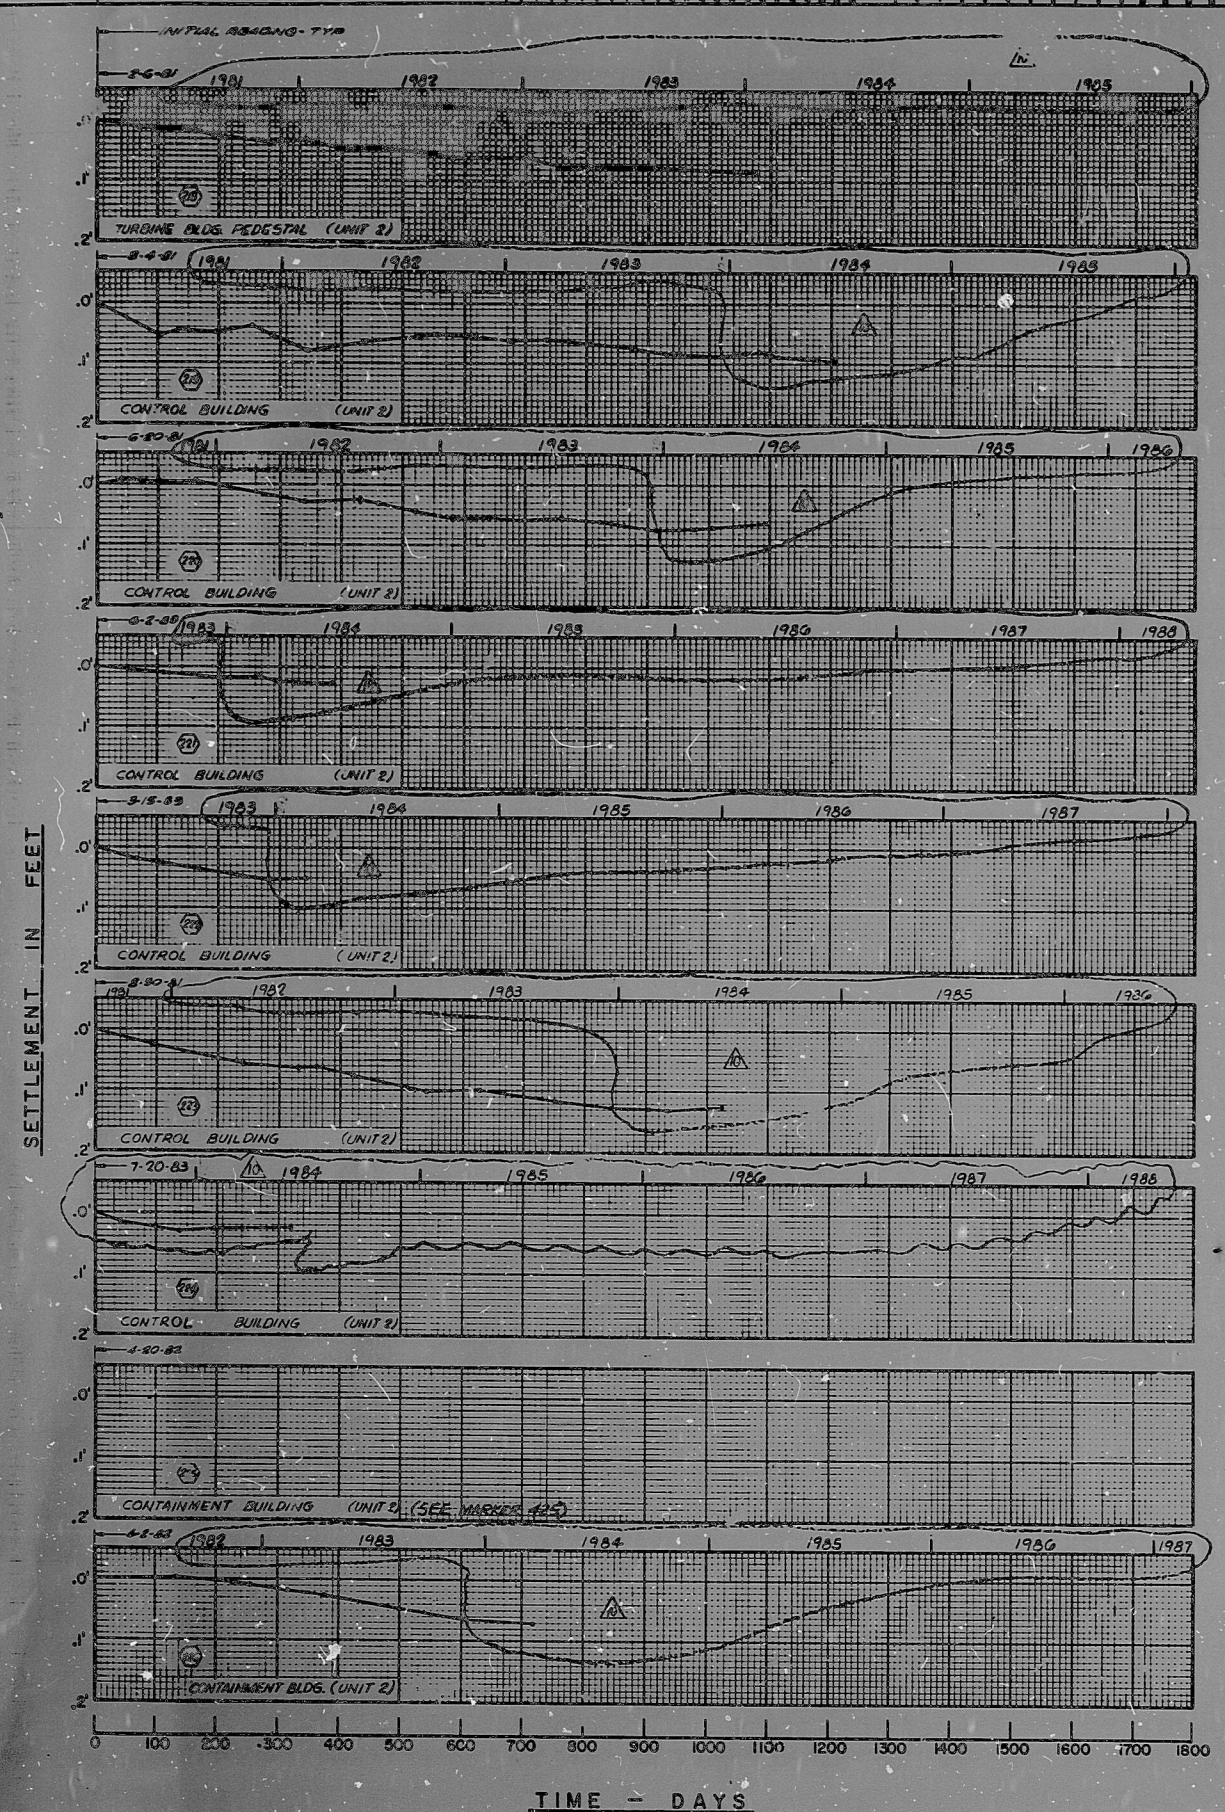

BECHTEL
LOS ANGELES

GEORGIA POWER COMPANY
ALVIN W. VOGTLE NUCLEAR PLANT

SETTLEMENT OBSERVATION RECORDS
GRAPH SHEET 5

SCALE: NONE

DRAWING NO. _____

JOB NO. 9510

DATE _____

REVISIONS

NO. _____

DATE _____

DR. _____

CHK. _____

SUPV. _____

ENGR. _____

DATE _____













NO.	DATE	DR.	CHK.	SUPV.	ENGR.	REVISIONS
1						
2						
3						
4						
5						
6						
7						

8410250074

PDR RIDS

8410250076

