

17

11

8

5"

1"

7"

17


11

8.5"

8.5"

11"

17"

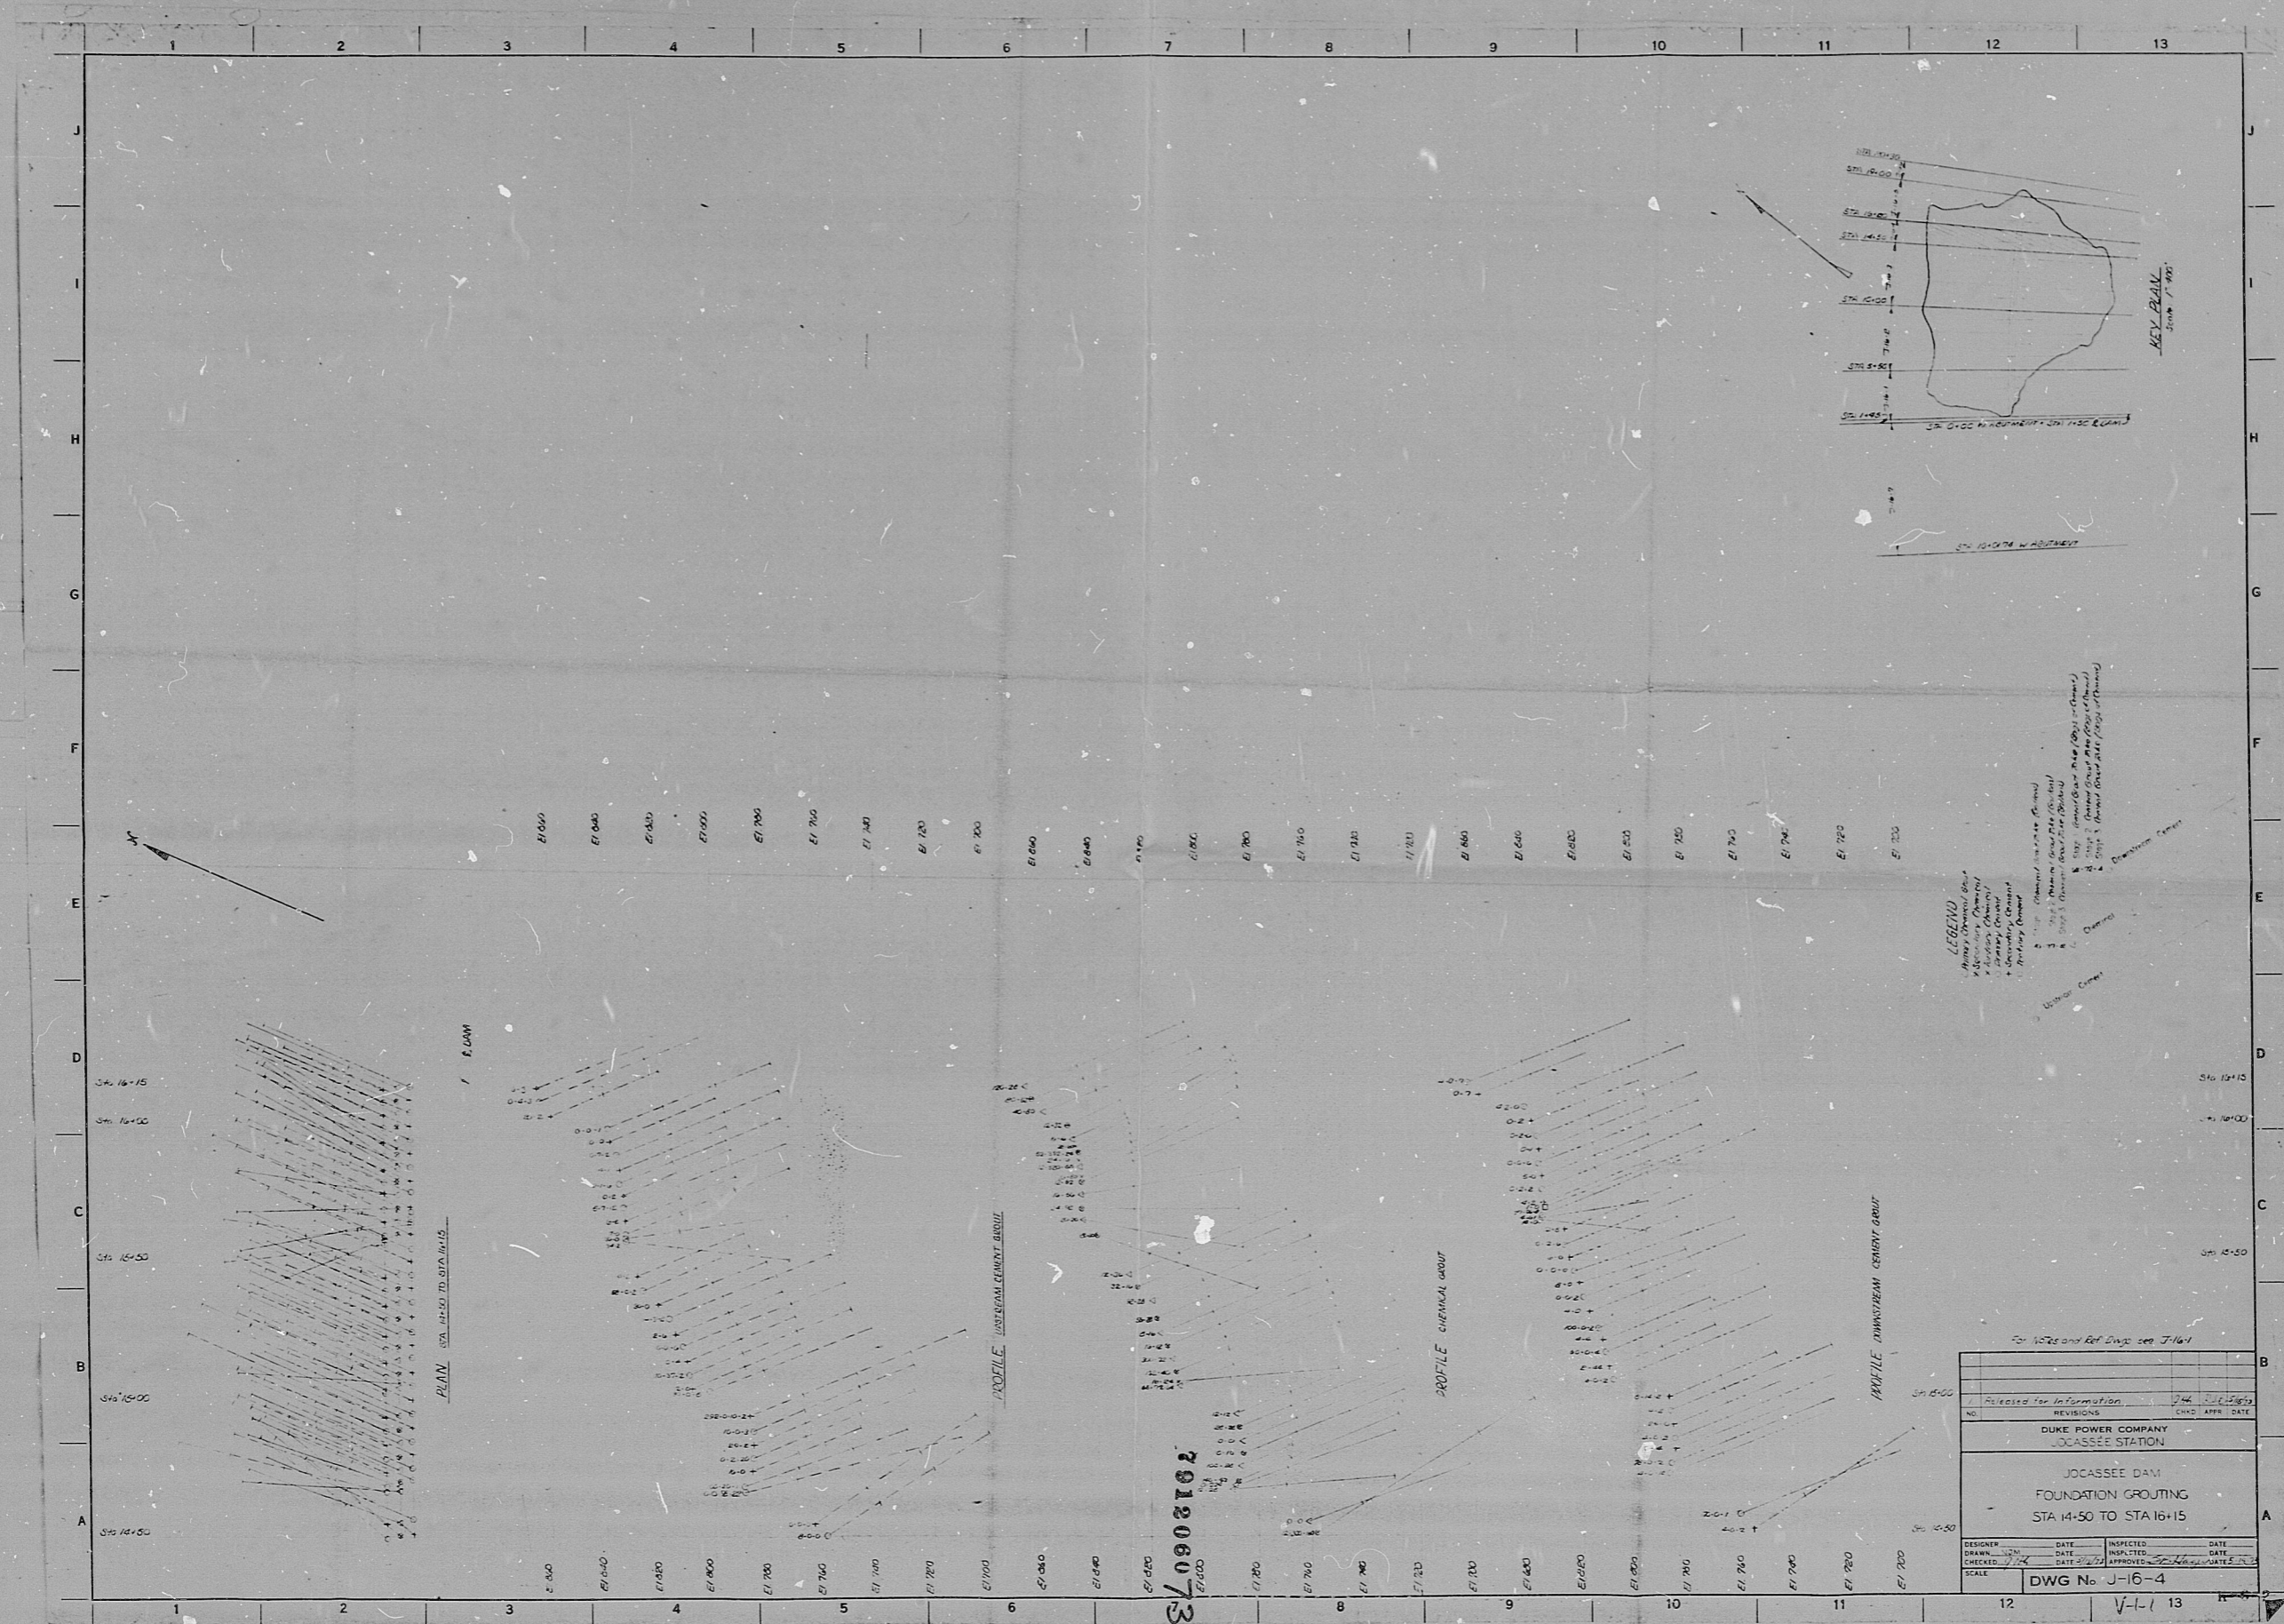

7012060737 P

Booklet # 50-269
Control # 77240013
Date 7-19-77
REGULATORY DOCKET FILE

For Notes and Ref. Drawg. see J-16-1

Released for Information	DATE	BY	
REVISIONS	CHG	APP. DATE	
DUKE POWER COMPANY JOCASSEE STATION			
JOCASSEE DAM FOUNDATION GROUTING STA 14-50 TO STA 16-15			
DESIGNER	DATE	INSPECTED	DATE
DRAWN	DATE	INSPECTED	DATE
CHECKED	DATE	APPROVED	DATE
SCALE	DWG No. J-16-4		

7912060737

