



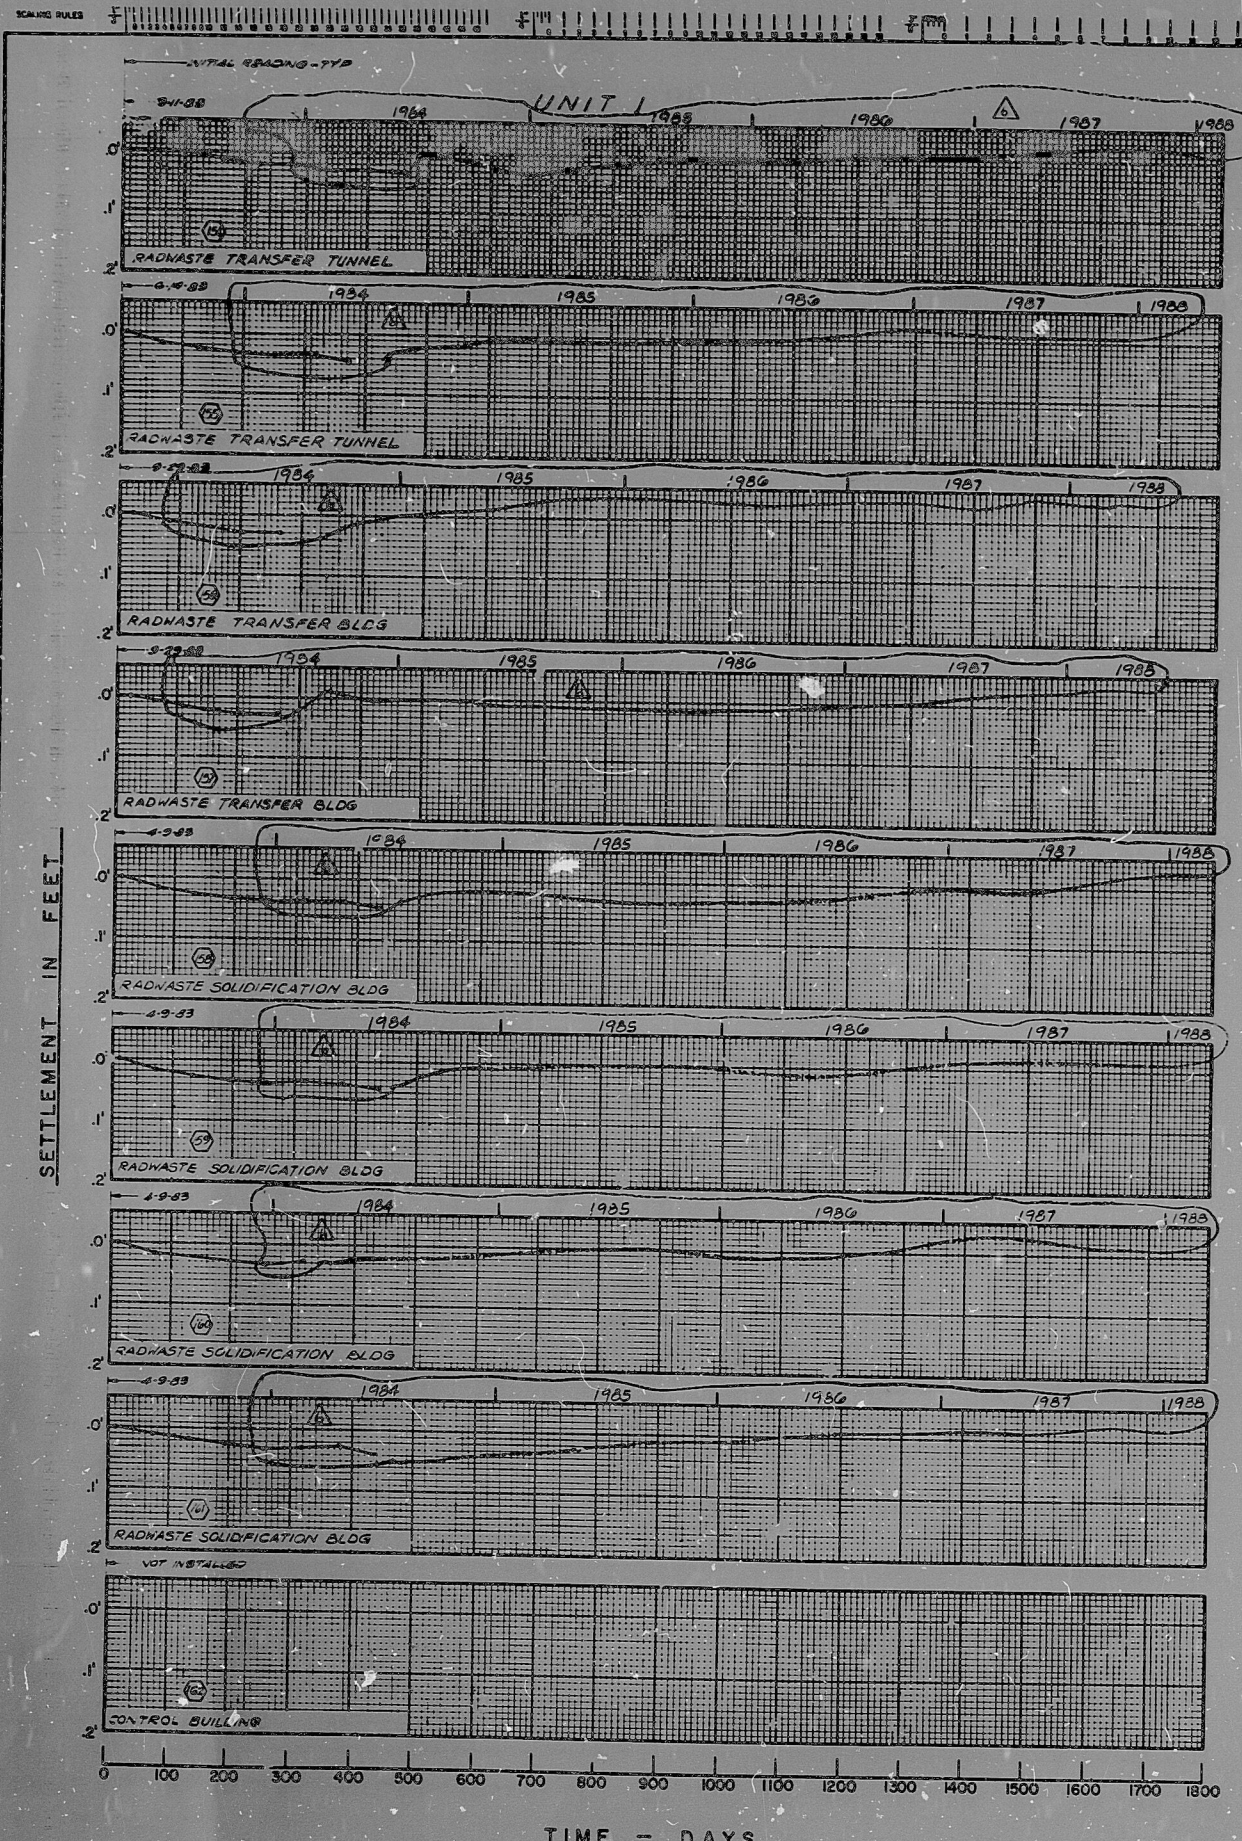

This drawing and the design it contains are the property of BECHTEL. They are hereby loaned and as the borrower's express agreement that they will not be reproduced, copied, loaned, exhibited, or used in any manner in the future without written permission by the lender to the borrower.

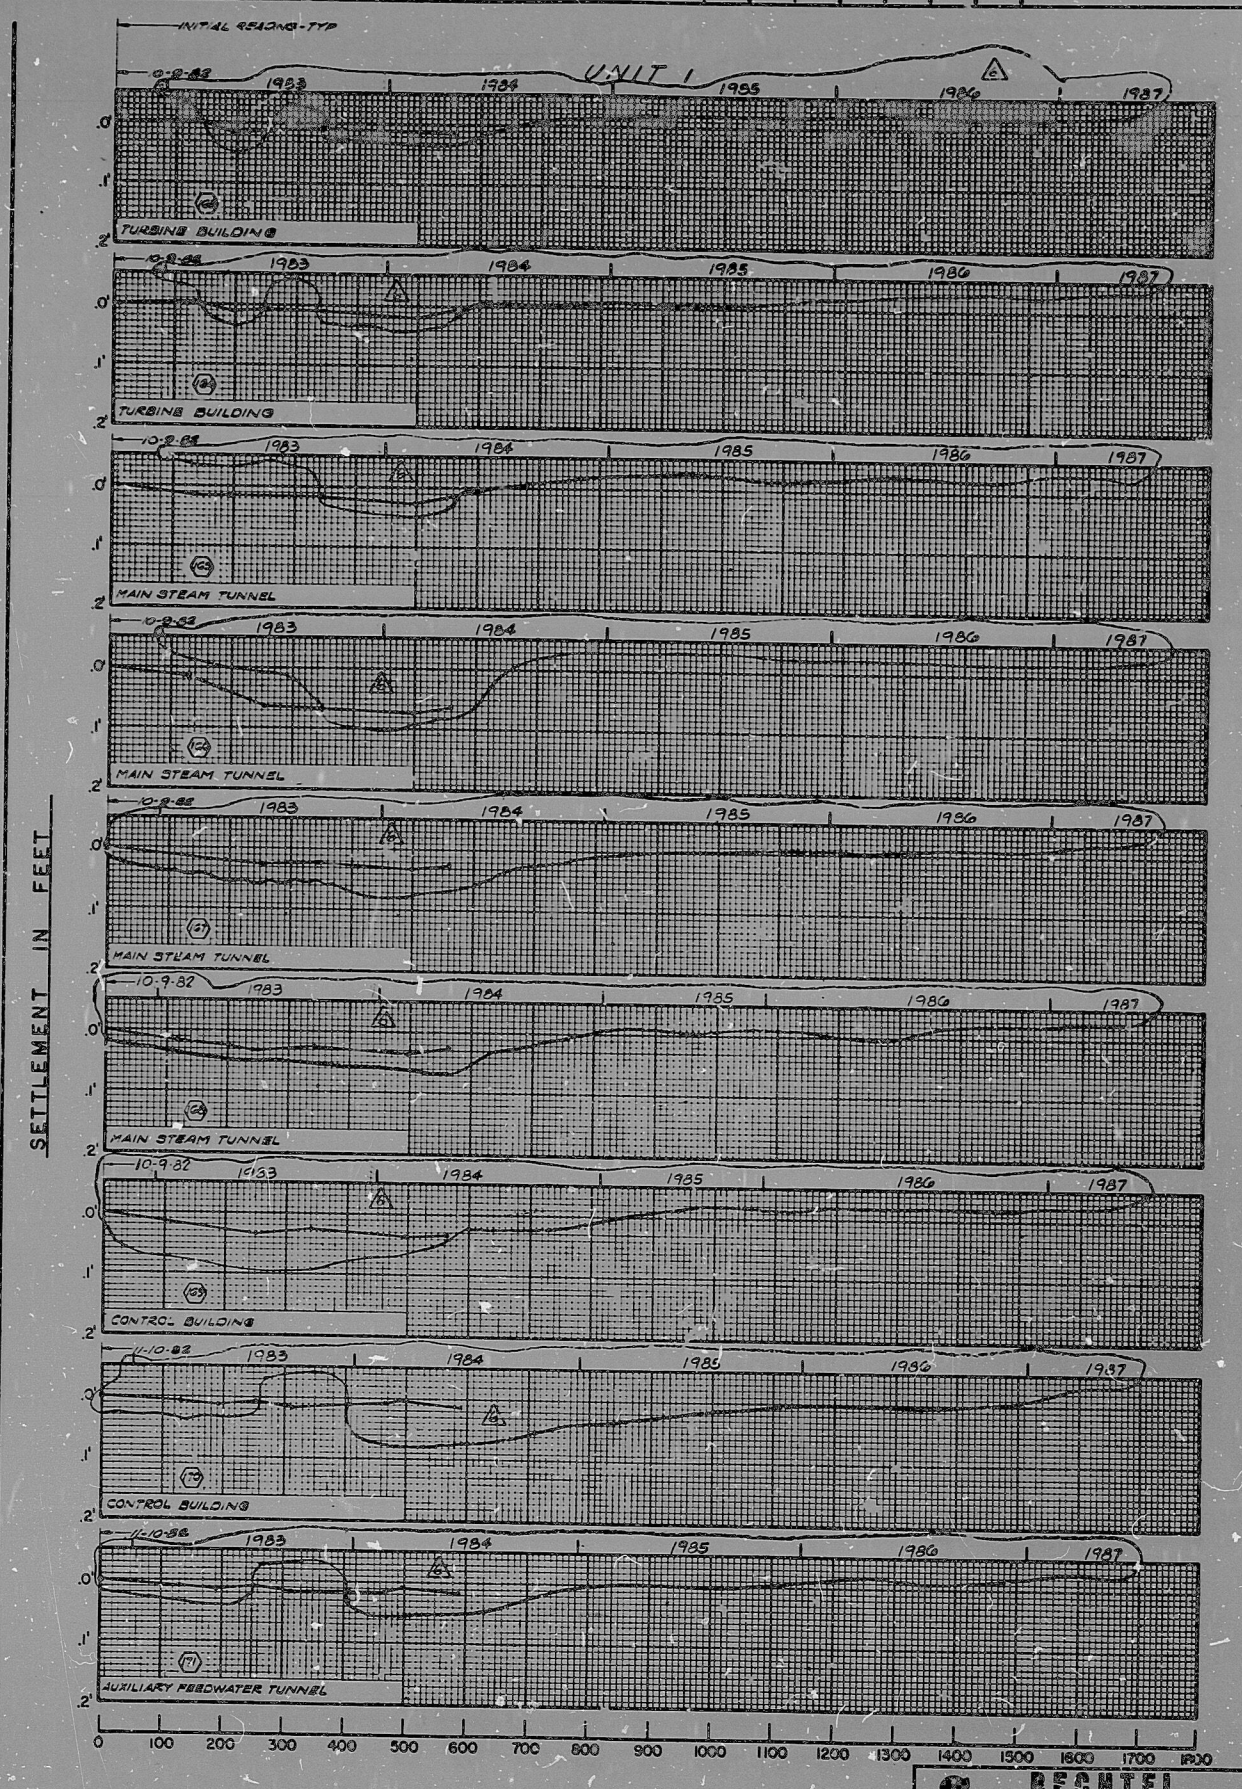

TI
APERTURE
CARD

REVISIONS	DATE	DR.	CHK.	SUPV.	EGS	CHK.	P.E.	DATE	NO.
1									
2									
3									
4									
5									
6									
7									

REVISIONS	DATE	DR.	CHK.	SUPV.	EGS	CHK.	P.E.	DATE	NO.
1									
2									
3									
4									
5									
6									
7									

BECHTEL LOS ANGELES	
GEORGIA POWER COMPANY ALVIN W. VOGTLE NUCLEAR PLANT	
SETTLEMENT OBSERVATION RECORDS GRAPHIC SHEET 8	
SCALE: NONE	DRAWING NO.
JOB NO. 8510	AX2055013
DATE	NO.

8410250098

PDR RIDS

8410250098

