
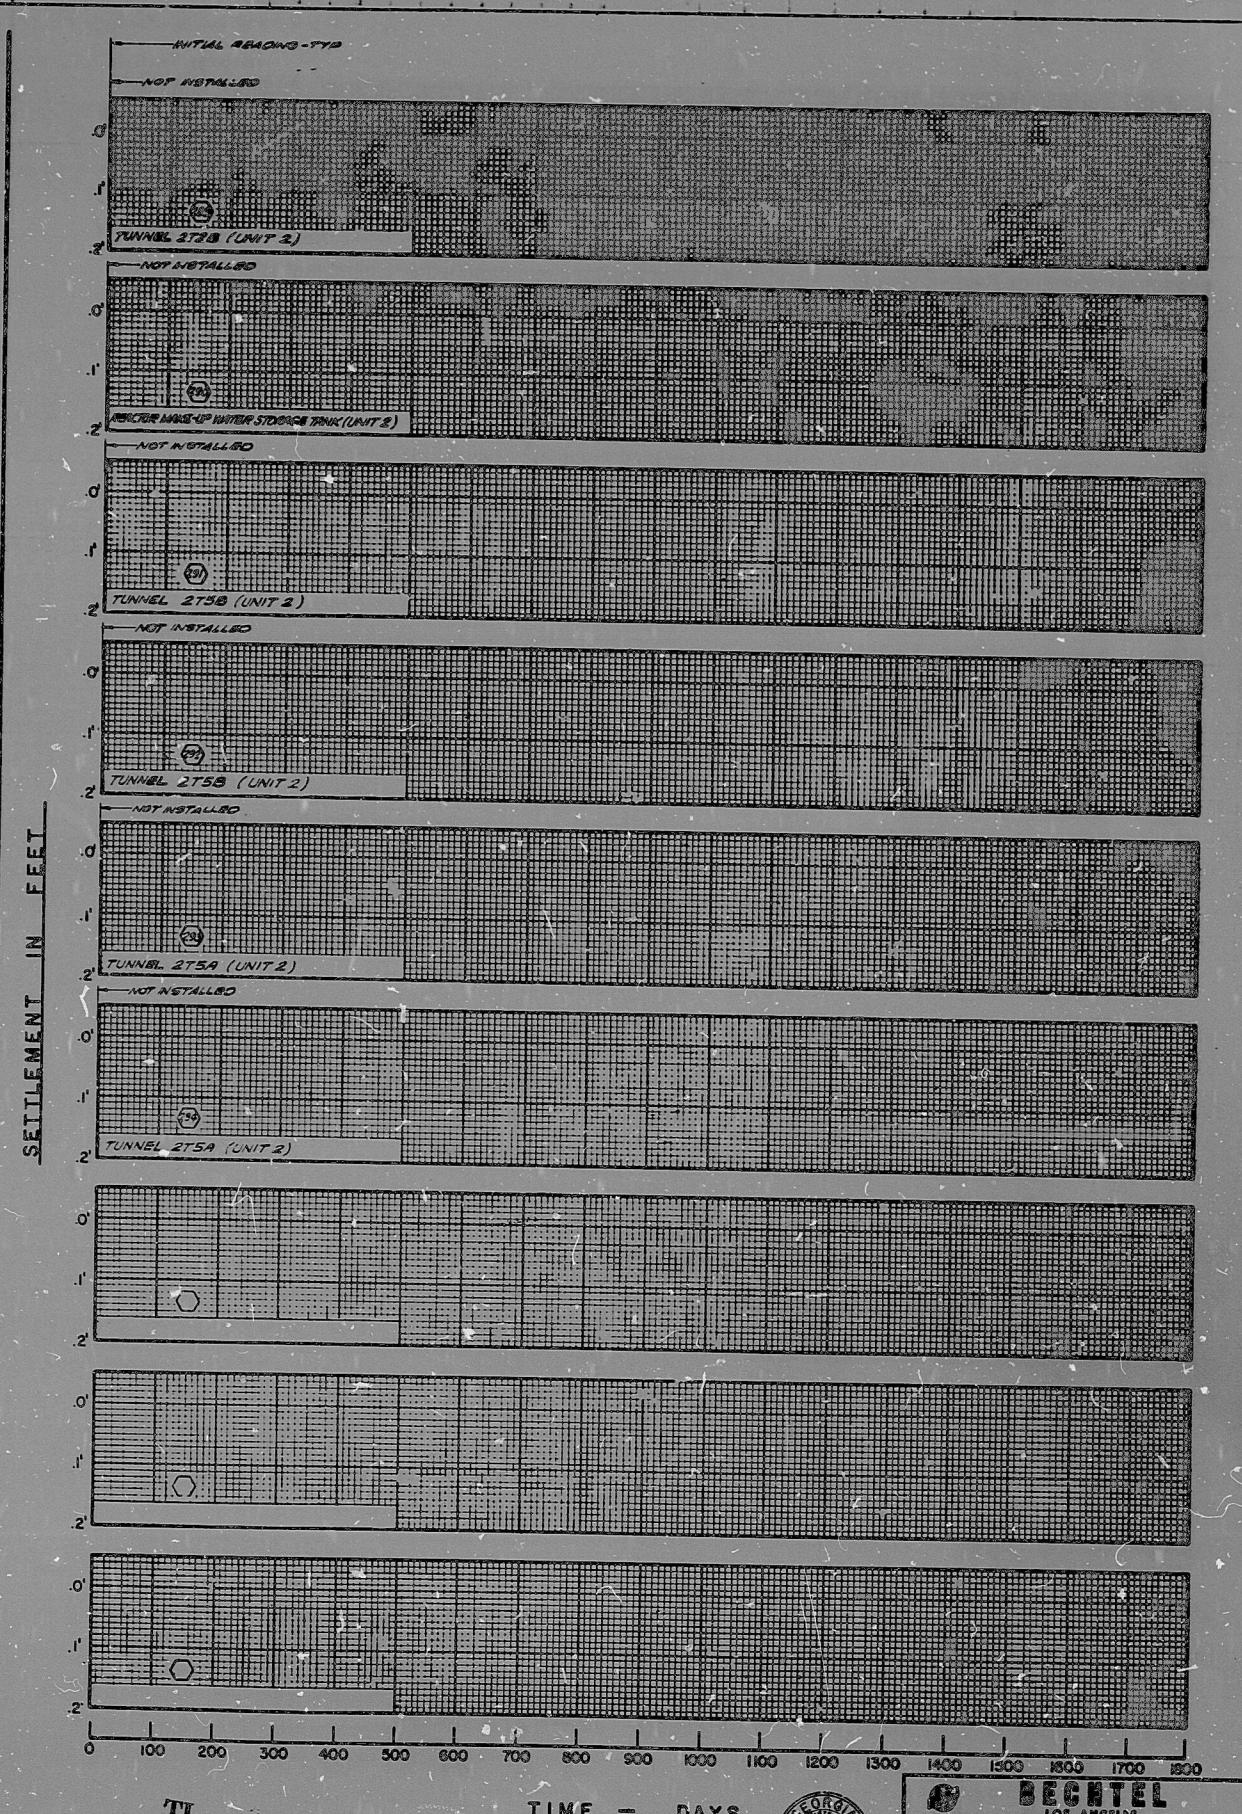



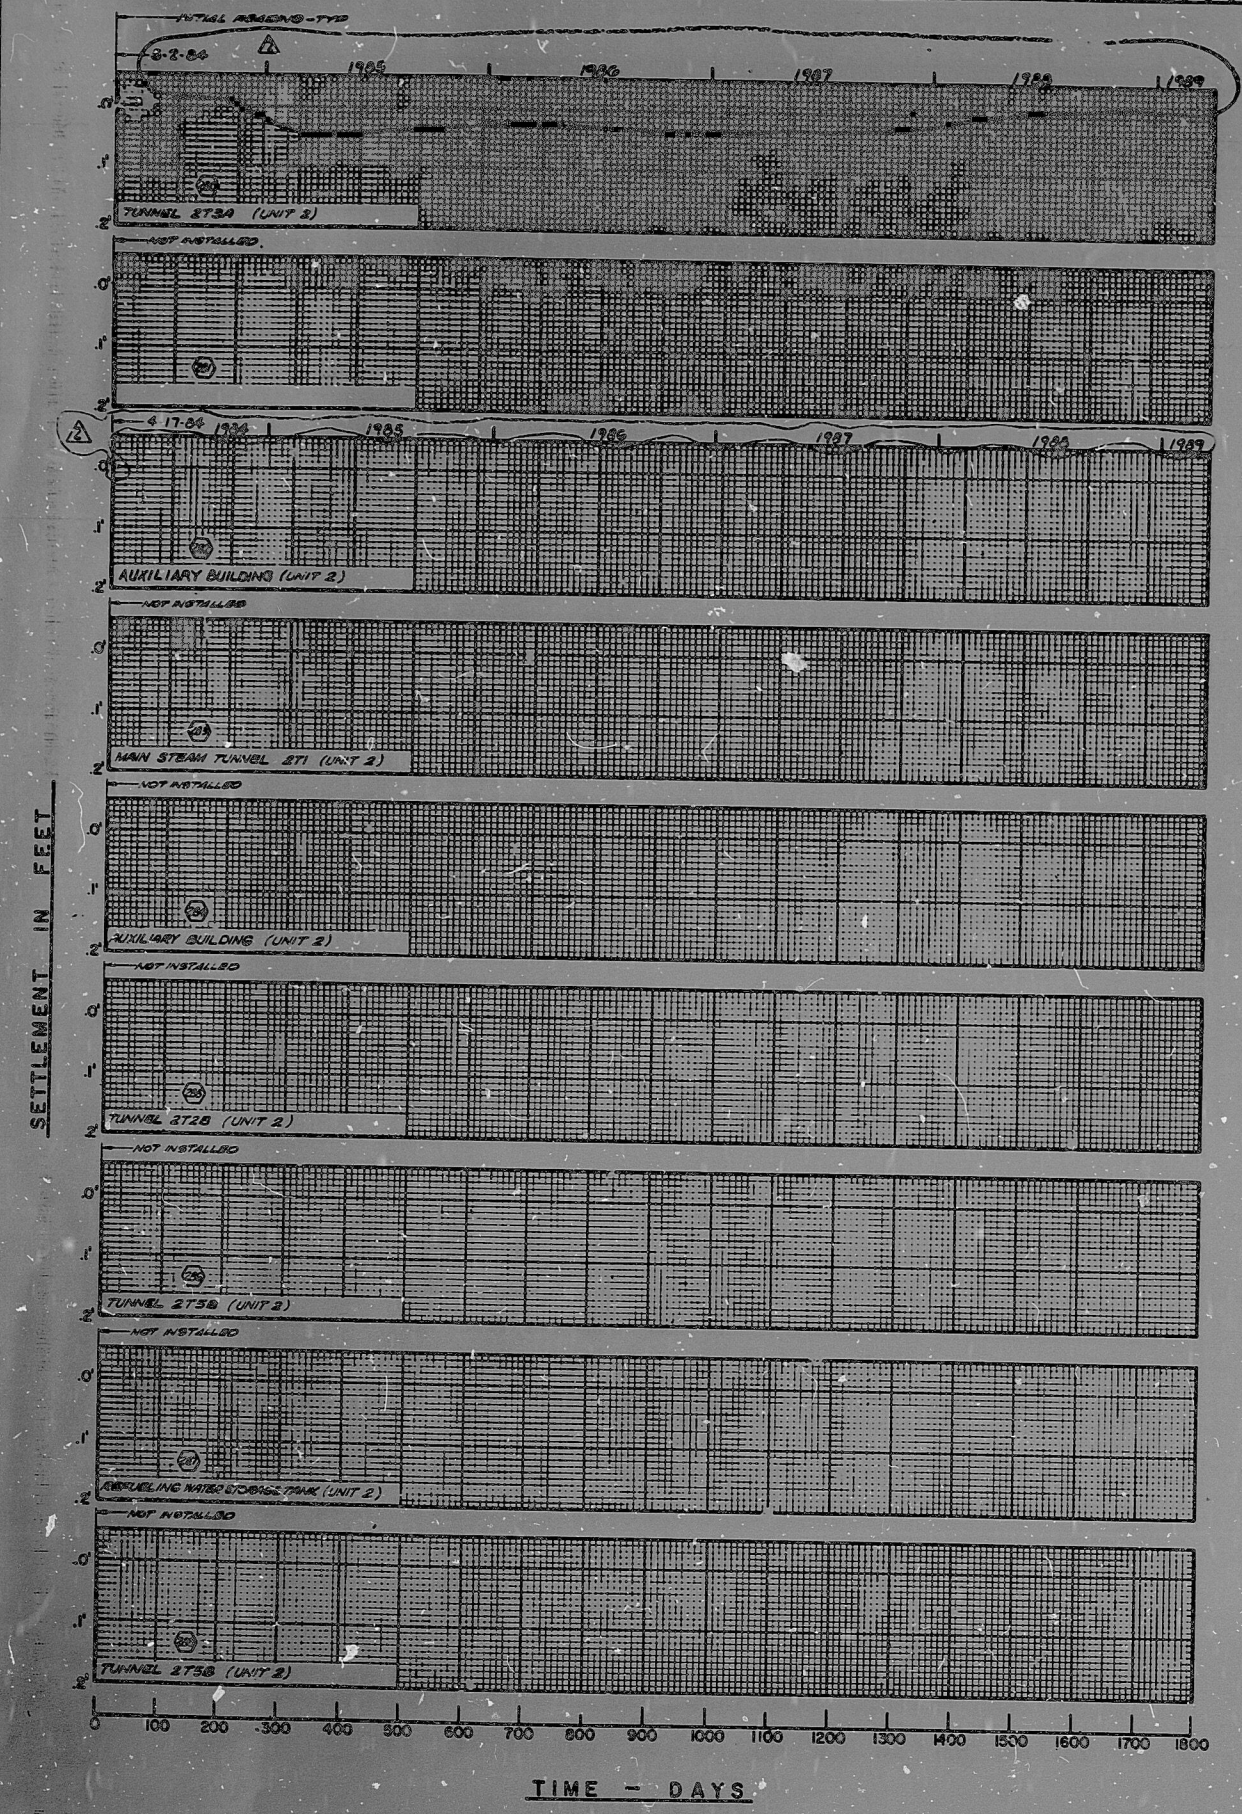

NO.	REVISIONS	DATE	BY	CHK	SUPV	EGS	CHIEF	P.A.	D.A.E.	RE.
1										
2										
3										
4										
5										
6										
7										

NO.	REVISIONS	DATE	BY	CHK	SUPV	EGS	CHIEF	P.A.	D.A.E.	RE.
1										
2										
3										
4										
5										
6										
7										

TI
APERTURE
CARD

TIME - DAYS



BECHTEL
 LOS ANGELES
 GEORGIA POWER COMPANY
 ALVIN W. VOGTLE NUCLEAR PLANT
 SETTLEMENT OBSERVATION PAGES
 ENVPIS SHEET 12

SCALE, NONE	DRAWING NO.	REV.
JOB NO. 1840	A4205400	2

8410250138

PDR RIDS

8410250138'

