

INFORMATION
THIS DOCUMENT IS
SUBJECT TO REVISION
WITHOUT NOTIFICATION
TO THE USER OF THIS
COPY


BLOCK	CONTACT	POSITION (35104)			USE
		CLOSE	AUTO	OPEN	
A	NC(1)	X			CONT
	NO(2)			X	CONT
B	NC(5)	X			SP
	NC(4)			X	SP

SUPPL. CTMT PURGE SUPPLY
INSIDE CTMT ISOL. V.V.C.

CONTACT	VALVE POSITION		USE
	CLOSE	OPEN	
1			THIS DWG.
2			SP
3			THIS DWG.
4			THIS DWG.
5			THIS DWG.
6			SP
7			THIS DWG.
8			THIS DWG.
9			SP
10			SP
11			SP
12			SP
13			SP
14			SP
15			THIS DWG.
16			THIS DWG.
17	OPENS ON MECH. OVERLOAD ON CLOSING		THIS DWG.
18	OPENS ON MECH. OVERLOAD ON OPENING		THIS DWG.

- REFERENCE DRAWINGS
- 0-E-0105 ELECTRICAL WIRING STANDARDS AND SYMBOLS
 - 1-2-3472 SH2-R.C. BLDG HVAC SUPPLEMENTARY CTMT PURGE ISOLATION VALVE LOGIC DIAGRAM CONTROL WIRING DIAGRAM
 - 1-E-1271 R.C. BLDG HVAC SUPPLEMENTARY CTMT PURGE SUPPLY-INSIDE CTMT ISOL V.V.C.

- LEGEND
- ▲ ISOLATION RELAY CABINET
 - IRR-034 - ESF MONITORING TRAIN C CAB
 - K833 - CONTACTS ACTUATE ON CTMT VENT ISOL. SIGNAL
 - IRR-006 - SOLID STATE PROTECTION TRAIN C ACTUATION CAB.
 - 27 - LOSS OF CONT. PHR. RELAY.
 - 49X - MTR. THERMAL O.L'S AUX. RELAY.
 - 33X - VALVE POSITION. RELAY.
 - MECH. EQUIP. NO. 2V41THA002
 - 480V-MCC-EICI-COMPT-G1

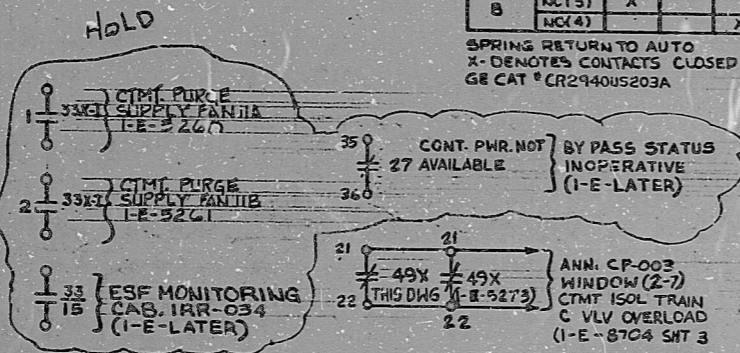

TERA APERTURE CARD

POOR ORIGINAL

DATE	DESCRIPTION	BY	CHK	APP	DATE	DESCRIPTION	BY	CHK	APP	DATE
	REV. AS NOTED & ISSUED FOR USE	T.I.								
	ISSUED FOR REVIEW (COMMENT)	REK								

Brown & Root Inc.
ENGINEERS-CONSTRUCTORS
HOUSTON, TEXAS


NUCLEAR SAFETY RELATED CLASS IE

PKG:020 SUFF:100 ACT:581

DRAWING TITLE: ELECTRICAL
ELEMENTARY DIAGRAM
SUPPL. CTMT PURGE SUPPLY INSIDE CTMT ISOL. V.V. C

CONTRACT NO. SCALE: CR-0241 NONE
DRAWING NO. 4V-14
1-E-5271-B

BROWN & ROOT INC.
MICROFILM SERVICES

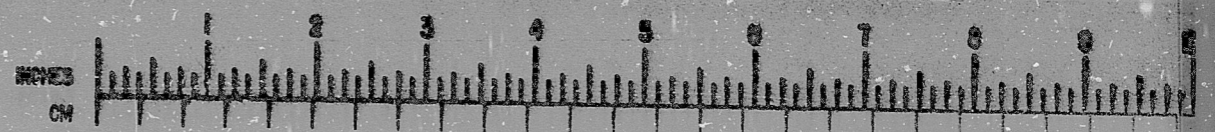

11
8.5"
11"
17"

RIDS

8112100490

