



PLAN
FLOOR ELEVATION 145'-0"

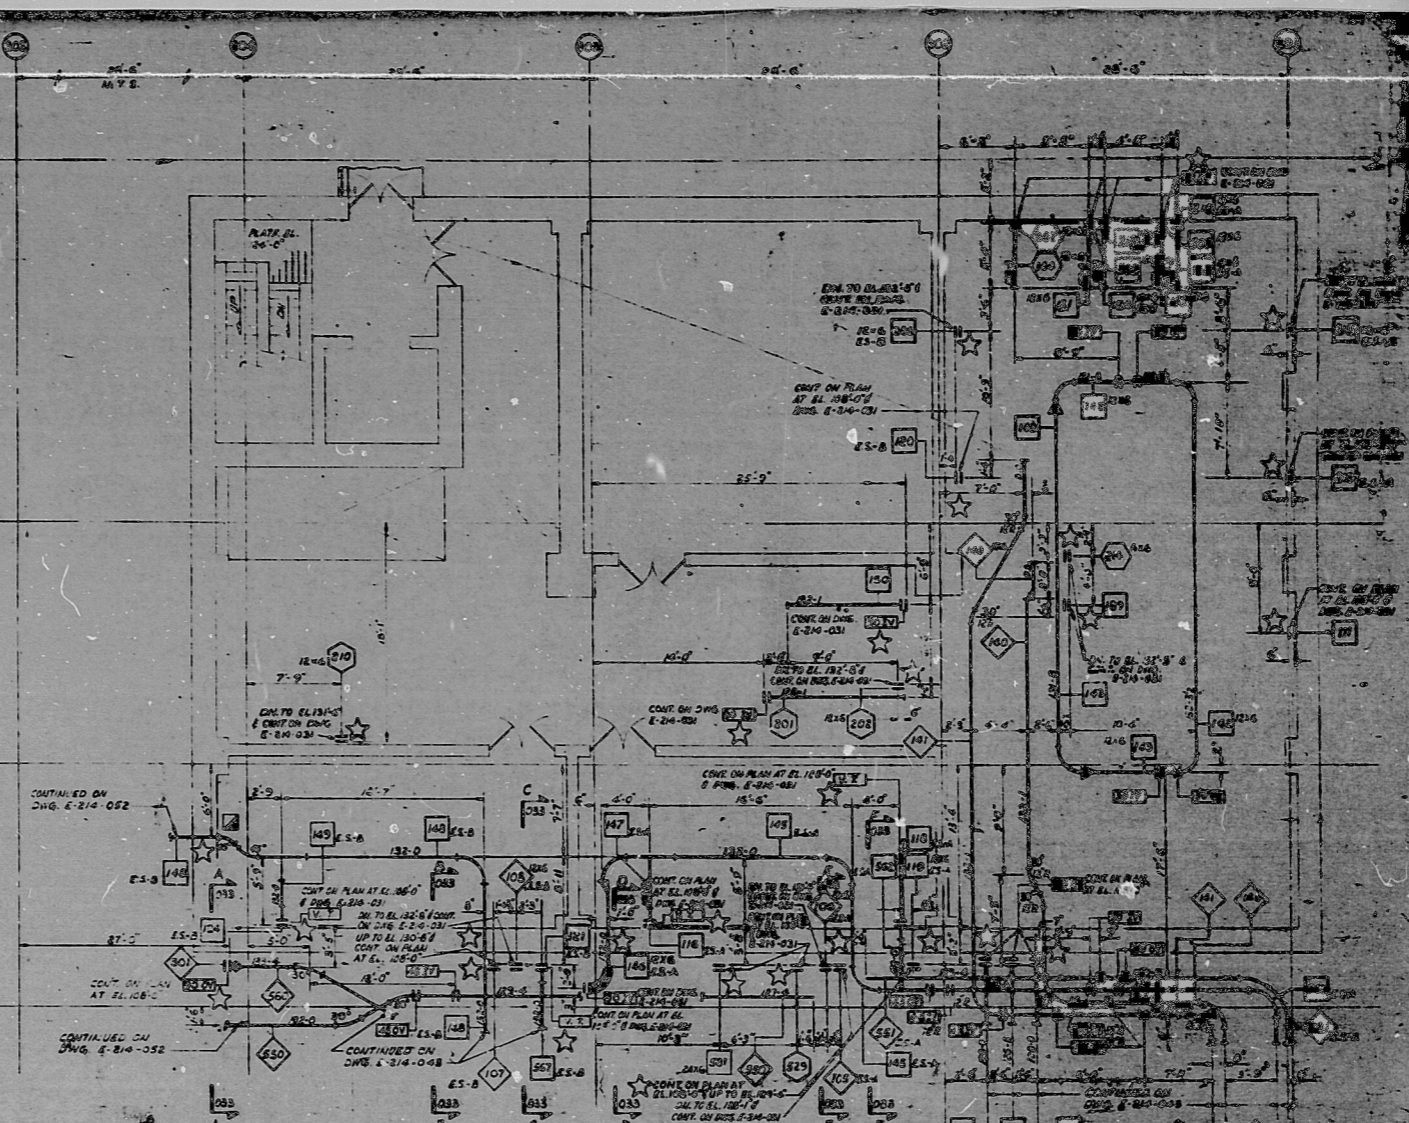

PLAN
FLOOR ELEVATION 124'-0"

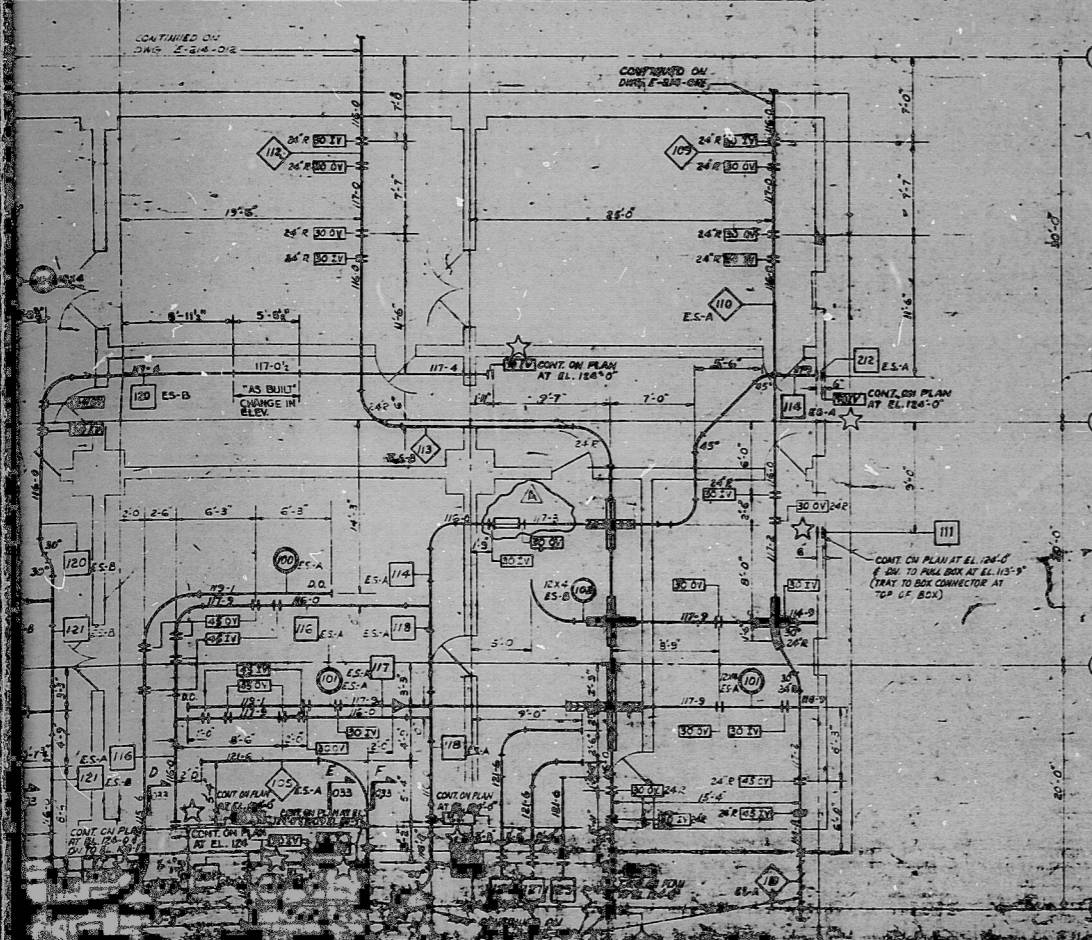

PARTIAL PLAN
FLOOR ELEVATION 164'-0"

NOTE: WALLS AT ELEVATION 106'-0" ARE FIRE BARRIER WALLS AND TRAYS PASSING THROUGH THEM, REQUIRE FIRE STOPS.
 FOR PRESSURE BARRIER IN THIS AREA REFER TO DRAWING E-214-011. FUTURE REVISION TO THIS DRAWING WILL REQUIRE REPLACEMENT OF PRESSURE BARRIER AS SET FORTH IN THE AFORESAID DRAWING.

CONSTRUCTION	
1	AS SHOWN
2	AS SHOWN
CF

7912130516

