


22"
17"
11"
5.8"
8.5"
11"
17"
22"

J-10-SHT. 10

REVISIONS
NO. 1 - 11/27/71
NO. 2 - 12/1/71
NO. 3 - 12/1/71
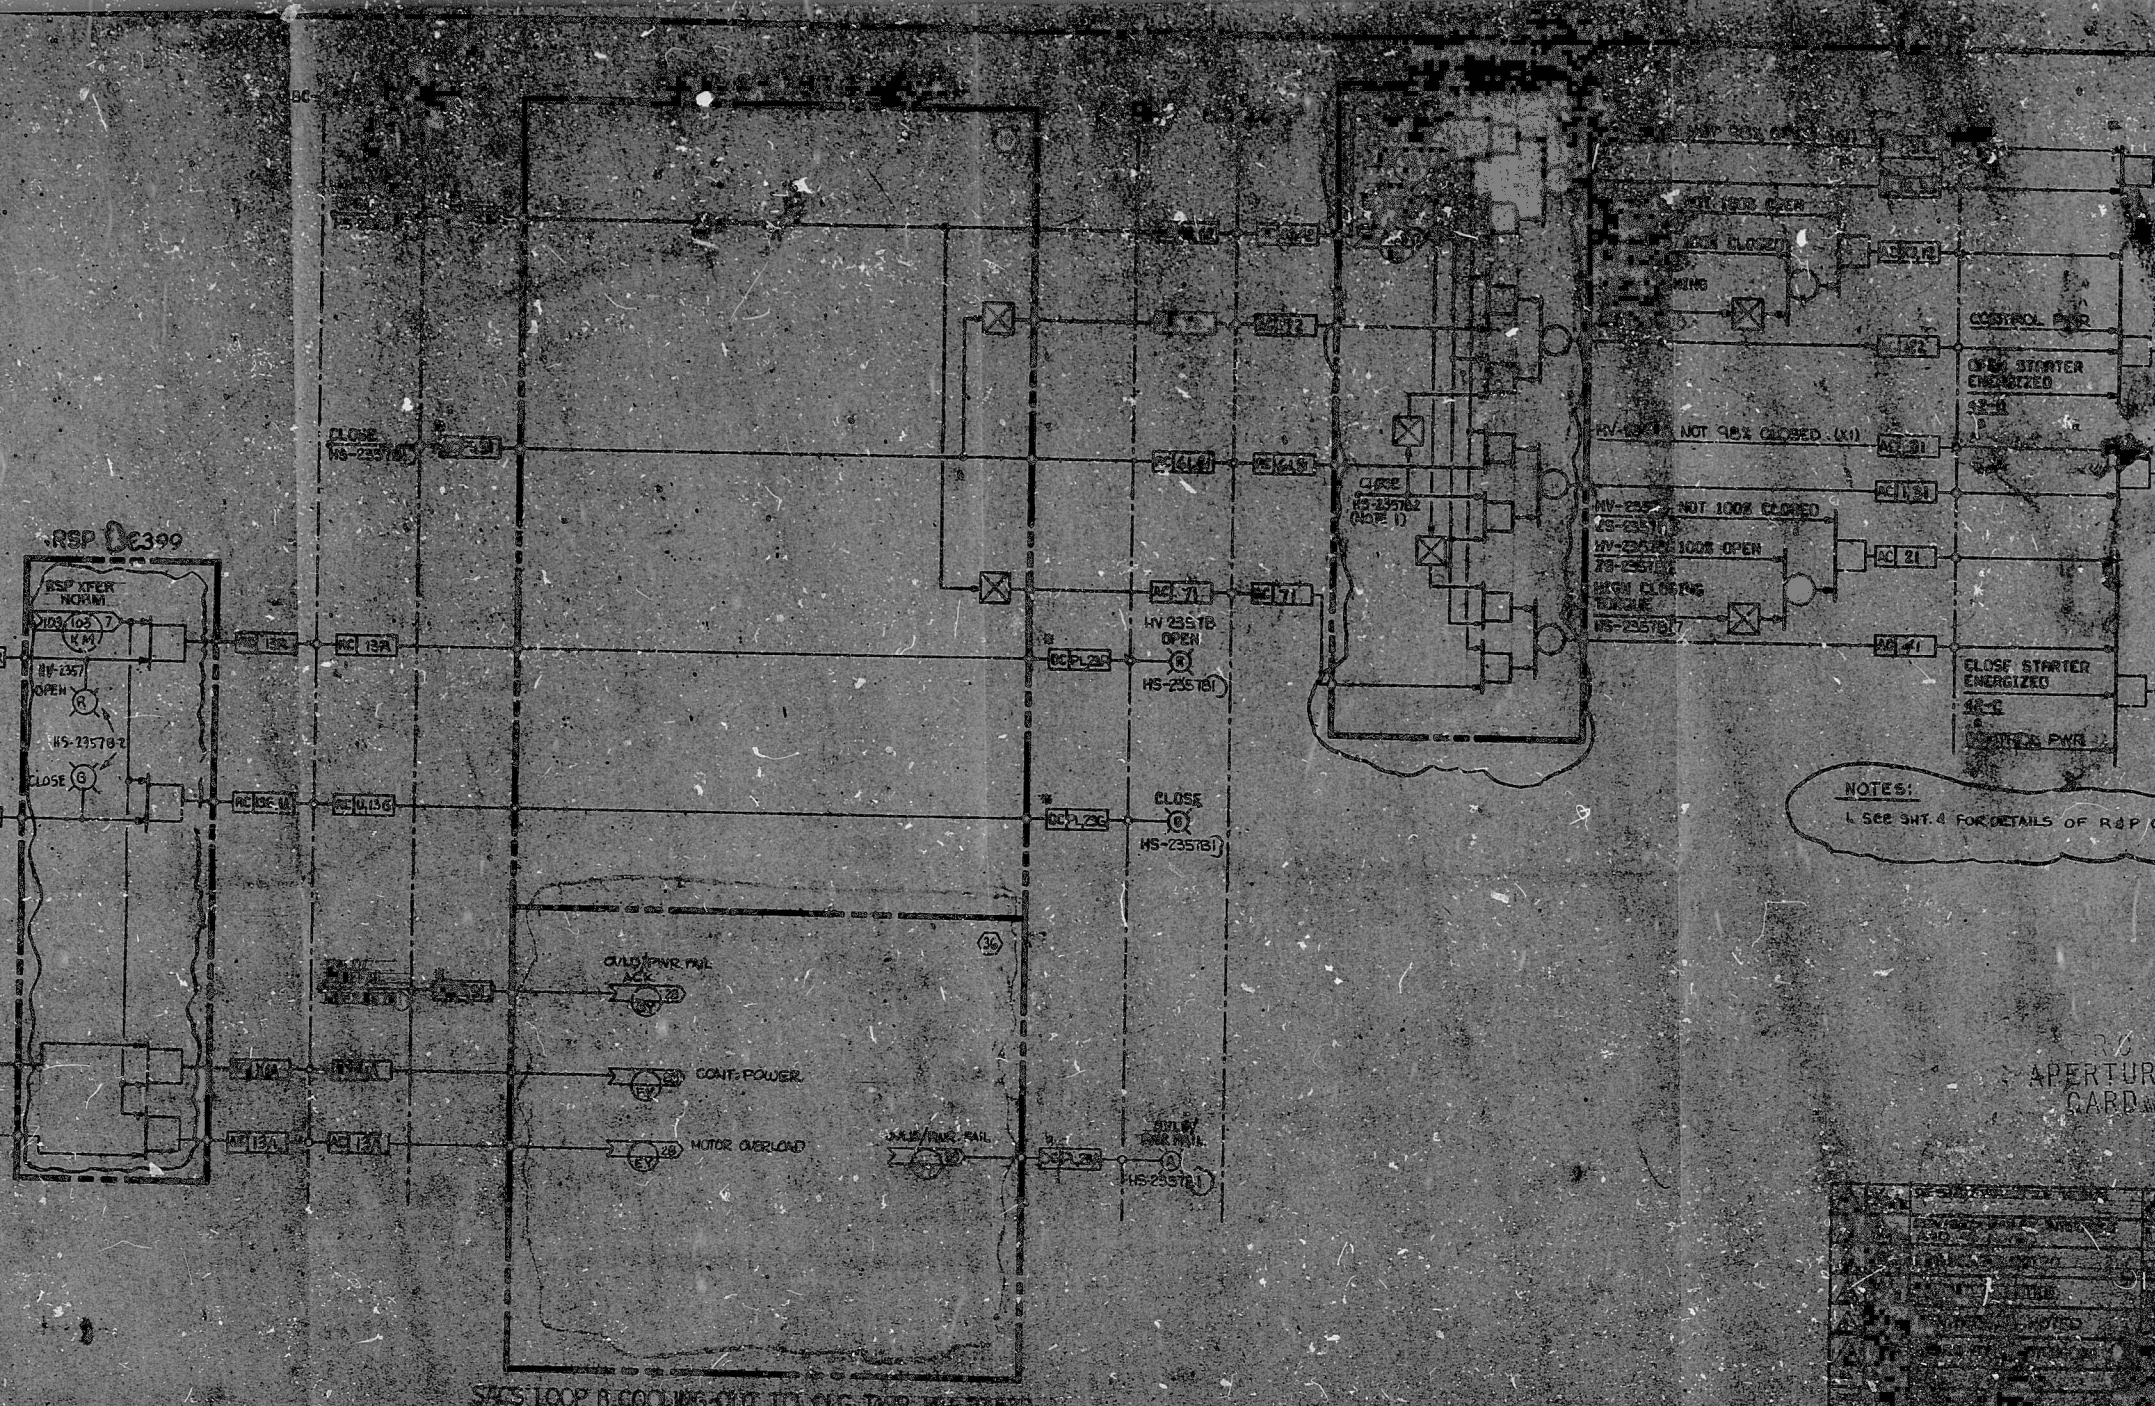

NOTES:
1. SEE SHT. 4 FOR DETAILS OF RSP CONTROL SWITCH.

22"
17"
11"
5.8"
8.5"
11"
17"
22"

RIDS

8307250713

