


This drawing and the design it covers are the property of BECHTEL. They are hereby loaned and on the borrower's express agreement that they will not be reproduced, copied, loaned, exhibited, or used except in the limited way and private use permitted by any written consent given by the lender to the borrower.

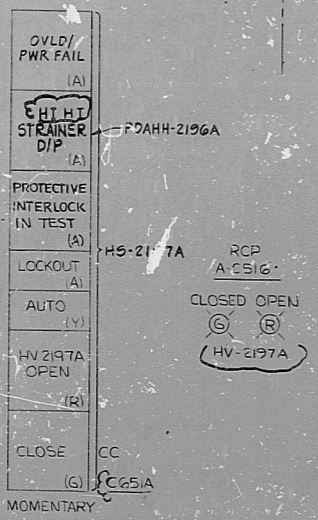

CROSS REFERENCE TABLE

SERVICE	SSWS PUMP	STRAINER NO. BACKWASH V	HAND SW.	DIFF PRESS SW.	T-MER	CC	LOGIC CAB.	TC	RCP	MCC	CLASS I/E CHANNEL	CIRCUIT NO.	POSITION SW. (NOTE 2 SHT. II)	TORQUE SW. (NOTE 2 SHT. II)	
LOOP/A STRAINER BACKWASH	AP502	AF509	HV-2197A	HS-2197A	XPD5H-2196A XPD5H-2197A XPD5L-2197A	KY-2197A	C651	AC652	AC657	AC516	B553	A	20	Z5-2197A	WS-2197A
	CF502	CF509	HV-2197C	HS-2197C	XPD5H-2196C XPD5H-2197C XPD5L-2197C	KY-2197C	C651	CC652	CC657	AC516	B573	C	22	Z5-2197C	WS-2197C

ALARM TEST DEVICE IN TEST POSITION	COMP I/O CAB	PROTECTIVE INTERLOCK IN TEST	COMP. ID. NO.	STRAINER HAND HI DIFF. PRESS	CIRCUIT NO. FOR OPEN ARROWS
PDSHL-2197A	OZ-LTR	D3858	D3857		35
PDSHL-2197C		D3860	D3859		37

NOTES:  
 1. CONTACTS OPEN ON HI DIFF PRESS.  
 2. 120 VAC FROM STRAINER STARTER.

P.R.C. APERTURE CARD

NO.	DATE	REVISIONS	BY	CHKD	DESIGN	SUPV	ENGR	PROJ	APPV

**BECHTEL**  
SAN FRANCISCO

PUBLIC SERVICE ELECTRIC AND GAS COMPANY  
HOPE CREEK GENERATING STATION

LOGIC DIAGRAM  
STATION SERVICE WATER SYSTEM  
STRAINERS AF509 & CF509 MAIN BACKWASH VLV'S

JOB No.	DRAWING No.	REV.
10855	J-10-0 SHT. 18	6 Q

S/U-EA

**RIDS**

8307250729

