


INSERVICE INSPECTION		REV. 14
ISO. NO.: MCFI ICA19		BUILDING: REACTOR ZN R6
DUKE PIPING CLASS: ASME SECT III CL B		
SYSTEM SYMBOL: AUX FEEDWATER		
PIPING SPEC: CA-14 PS-900.2		
DRAWING NO.: MC-1403-01.20-00401		
PROJECT MCGUIRE		
NUCLEAR SAFETY RELATED		
REV. NO.	DATE	DESCRIPTION
5	12/27/77	CHANGED CONFIGURATION & DELETED WELDS CNF 706, VN. 12152
4	12/27/77	ADDED ROLLING OFFSET AND WELDS 805-808 RE TO RELOCATE SUB ICAF-306
3	12/27/77	CHANGE CONFIRMED WELDS 855-857 RELATED SLEEVES 805-808, 809, 810,1000
1		ADDED NOTE 4
0		REL FOR CONSTRUCTION

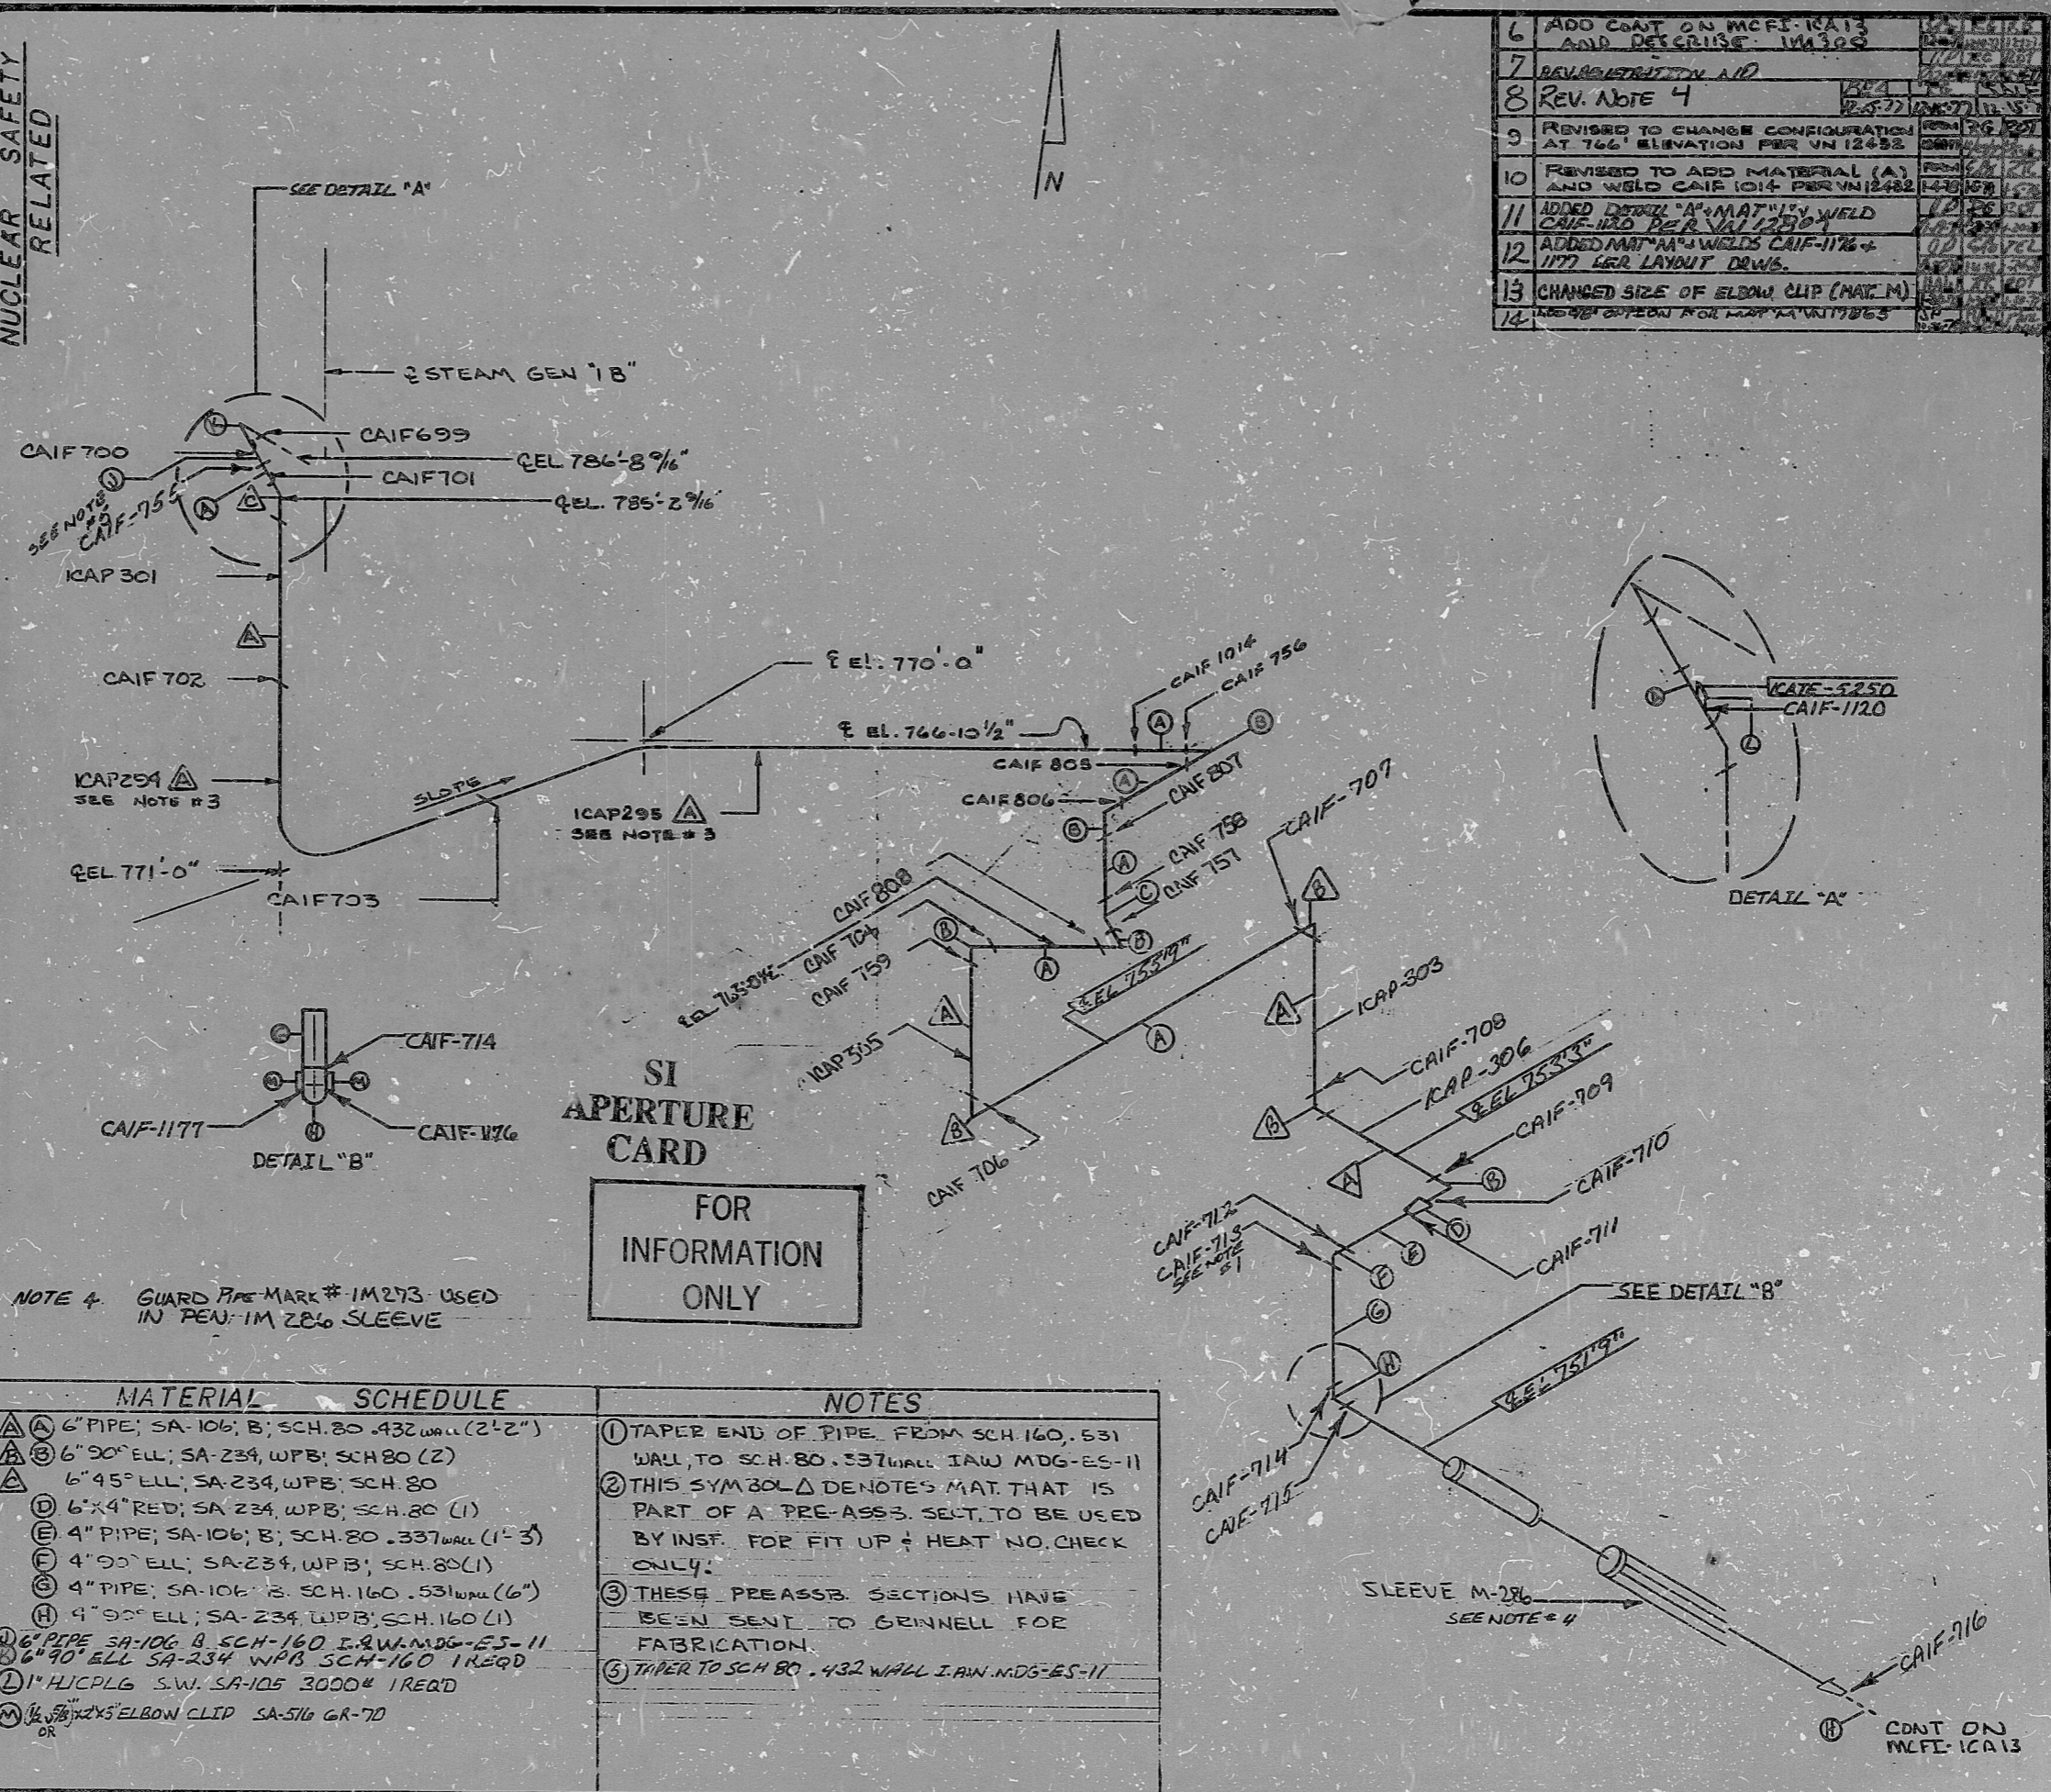

6	ADD COAT ON MCFI-ICA13 AND DESCRIBE IM 309
7	REVISIONS AND
8	REV. NOTE 4
9	REVISED TO CHANGE CONFIGURATION AT 766' ELEVATION PER VN 12452
10	REVISED TO ADD MATERIAL (A) AND WELD CAIF 1014 PER VN 12482
11	ADDED DETAIL 'A' MATERIAL WELD CAIF-1120 PER VN 12504
12	ADDED MATERIAL WELDS CAIF-1176 + 1177 PER LAYOUT DWS.
13	CHANGED SIZE OF ELBOW CLIP (MAT. M)
14	REVISION FOR MAT. M 117865

NOTE 4. GUARD PIPE MARK # IM 273. USED IN PEN. IM 286 SLEEVE

MATERIAL	SCHEDULE	NOTES
(A) 6" PIPE; SA-106; B; SCH. 80 .432 WALL (2'-2")		(1) TAPER END OF PIPE FROM SCH 160, 531 WALL TO SCH 80 .537 WALL IAW MDG-ES-11
(B) 6" 90° ELL; SA-234, WPB; SCH 80 (2)		(2) THIS SYMBOL Δ DENOTES MAT. THAT IS PART OF A PRE-ASSB. SECT. TO BE USED BY INST. FOR FIT UP & HEAT NO. CHECK ONLY.
(C) 6" 45° ELL; SA-234, WPB; SCH. 80		(3) THESE PRE-ASSB. SECTIONS HAVE BEEN SENT TO GRINNELL FOR FABRICATION.
(D) 6" x 4" RED; SA-234, WPB; SCH. 80 (1)		(4) TAPER TO SCH 80 .432 WALL IAW MDG-ES-11
(E) 4" PIPE; SA-106; B; SCH. 80 .337 WALL (1'-3")		
(F) 4" 90° ELL; SA-234, WPB; SCH. 80 (1)		
(G) 4" PIPE; SA-106; B; SCH. 160 .531 WALL (6")		
(H) 4" 90° ELL; SA-234, WPB; SCH. 160 (1)		
(I) 6" PIPE SA-106; B; SCH. 160 IAW MDG-ES-11		
(J) 6" 90° ELL SA-234 WPB; SCH. 160 1REQD		
(K) 1" HICPLG S.W. SA-105 30004 1REQD		
(L) 1/2" x 1/2" x 2" ELBOW CLIP SA-516 GR-7D		

DURCAN-PARNELL, INC., CHARLOTTE 1976

8903220453

PDR RIDS

