


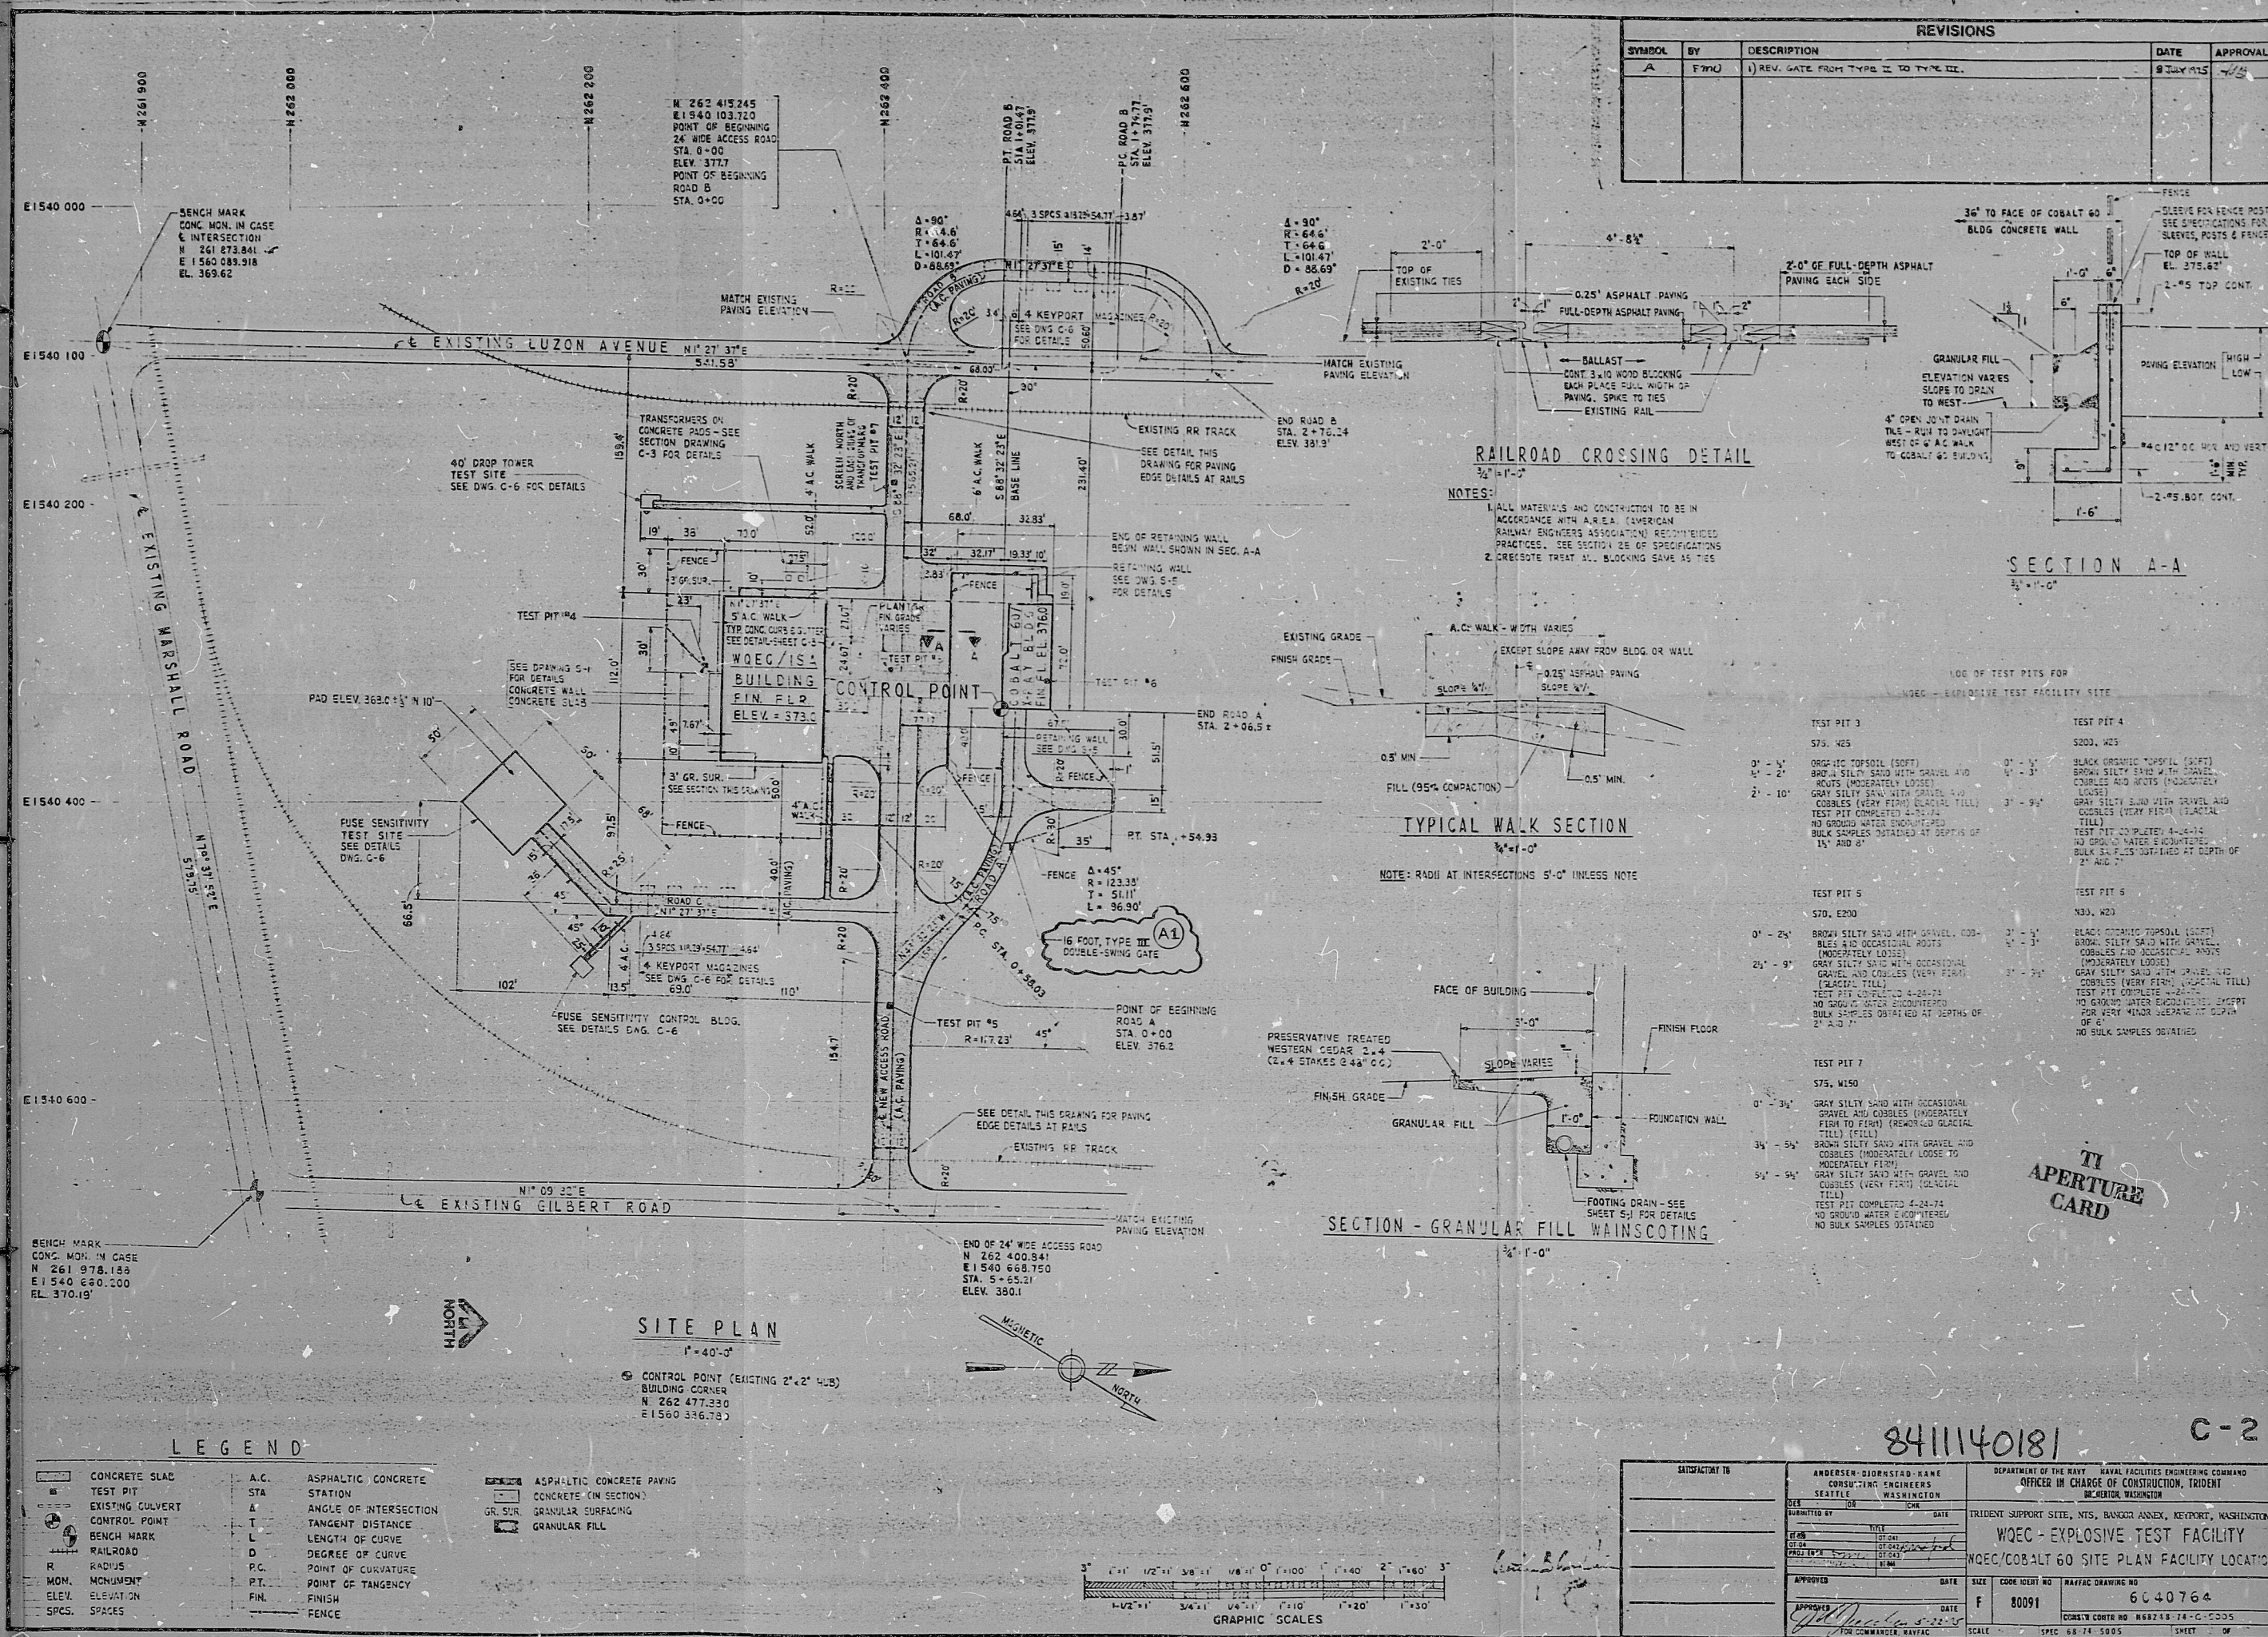

PDR RIDS

8411140181

