


INFORMATION  
THIS DOCUMENT IS  
SUBJECT TO REVISION  
WITHOUT NOTIFICATION  
TO THE USER OF THIS  
COPY

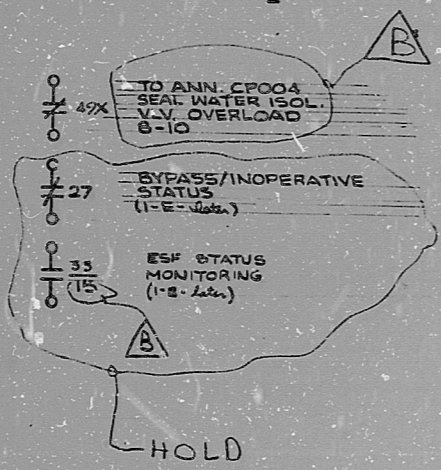

CS-MD (4566)

BLOCK	CONTACT	POSITION	USE
A	NC(1)	X	SP
	NO(2)	X	CONT
B	NC(3)	X	CONT
	NO(4)	X	CONT

SPRING RETURN TO AUTO  
X DENOTES CONTACT CLOSED  
(S.E. CAT # LR2940US203E)



33 - CV033A

CONTACT	VALVE POSITION		USE
	CLOSE	OPEN	
1			THIS DWG
2			SPARE
3			THIS DWG
4			THIS DWG
5			THIS DWG
6			THIS DWG
7			THIS DWG
8			SPARE
9			SPARE
10			SPARE
11			SPARE
12			SPARE
13			SPARE
14			SPARE
15			THIS DWG
16			SPARE
17	OPENS ON MECH. OVERLOAD ON CLOSING		THIS DWG
18	OPENS ON MECH. OVERLOAD ON OPENING		THIS DWG

TERA APERTURE CARD

REFERENCE DRAWINGS

- 0-E-0105 - ELECT. WIRING STANDARDS (SYMBOLS)
- 1-E-3662-SH-T - SEAL WATER INJECTION ISOL. VALVE LOGIC DIAGRAM
- 1-E-4565 - CONTROL WIRING DIAGRAM SEAL WATER INJECTION ISOL. VALVE XCV033A
- (W) 27IC333, SH 377 - SEAL WATER INJ. ISOLATION V.V.

LEGEND

- IRR-04 - SOLID STATE PROTECTION ACTUATION CABINET TRAIN 'B' CONTACT CLOSING ON CONTAINMENT ISOLATION
- IRR-05 - SAFEGUARDS TRAIN 'B' TEST CABINET CONTACTS CHANGE WHEN TEST SWITCH IS IN TEST MODE
- 27 - CONTROL PWR NOT AVAILABLE

480V MCC EIB2 COMPT. HI MECH. EQUIP. NO. 2711TCV033A

**NUCLEAR SAFETY RELATED CLASS I E**

PKG: 034 | SUPP: 102 | ACT: 581

DATE	DESCRIPTION	BY	CHK	ENG	APP	DATE	DESCRIPTION	BY	CHK	ENG	APP	DATE
	ISSUED FOR USE	DB	AM									
	ISSUED FOR REVIEW/COMMENT	VW	CS									

**Brown & Root Inc.**  
ENGINEERS CONSTRUCTORS  
HOUSTON, TEXAS


**SOUTH TEXAS PROJECT**

ELECTRICAL  
ELEMENTARY DIAGRAM  
SEAL WATER INJECTION  
ISOLATION VALVE XCV033A  
1-E-4565-B

CONTRACT NO. SCALE  
CR-0241 NONE

DRAWING NO. 4-R-17  
1-E-4565-B

INFORMATION | PRELIMINARY | REVIEW | USE | CONSTRUCTION

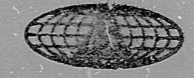

**BROWN & ROOT INC.**  
MICROFILM SERVICES

WEDNESDAY, AUG. 29, 1979



MICROFILMED MAR 15 1978

RIDS

8112180229

