


INFORMATION
THIS DOCUMENT IS
SUBJECT TO REVISION
WITHOUT NOTIFICATION
TO THE USER OF THIS
COPY

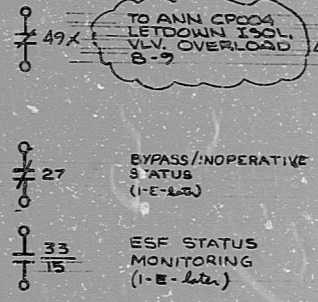

CS-MB (4532)

BLOCK	CONTACT	POSITION	USE
		CLOSE	AUTO
		OPEN	
A	NC(1)	X	SP
	NO(2)	X	CONT
B	NC(3)	X	CONT
	NO(4)	X	CONT

SPRING RETURN TO AUTO
X-DENOTES CONTACT CLOSED
G.E. CAT # LR2940US203E



33-XCV023

CONTACT	VALVE POSITION	USE
	CLOSE	
	OPEN	
1		THIS DWG
2		SPARE
3		THIS DWG
4		THIS DWG
5		THIS DWG
6		SPARE
7		THIS DWG
8		SPARE
9		SPARE
10		SPARE
11		SPARE
12		SPARE
13		SPARE
14		SPARE
15		THIS DWG
16		SPARE
17	OPENS ON MECH. OVERLOAD ON CLOSING	THIS DWG
18	OPENS ON MECH. OVERLOAD ON OPENING	THIS DWG

- REFERENCE DRAWINGS
- 0-E-0105 - ELECT. WIRING STANDARDS (SYMBOLS)
 - 1-E-3662-SH.4 - LETDOWN ISOLATION VALVE LOGIC DIAGRAM
 - 1-E-6562 - CONTROL WIRING DIAGRAM CVCS LETDOWN ISOLATION VALVE XCV023
 - 27C333-5H.370 - LETDOWN ISOLATION VALVE

- LEGEND
- IRROG - SOLID STATE PROTECTION TRAINER CABINET
 - 27 - CONTROL PWR NOT AVAILABLE

- NOTES
- CONTACT CLOSING ON CONTAINMENT ISOL. PHASE 'A' SIGNAL
 - 450V MCC ELEC. COMPT. (B3) MECH. EQUIP. NO. 2711XCV023

TERA APERTURE CARD

NUCLEAR SAFETY RELATED CLASS I E

PKG: 034 SUFF: 102 ACT: 581

DRAWING TITLE	CONTRACT NO. SCALE
ELECTRICAL	CR-0241 NONE
ELEMENTARY DIAGRAM	DRAWING NO. 4-R-17
CVCS LETDOWN ISOLATION VALVE XCV023	1-E-4562-B

DATE	DESCRIPTION	BY	CHK	PROJ	ENG	DES	DATE	DESCRIPTION	BY	CHK	PROJ	ENG	DES	DATE
	ISSUED FOR USE													
	ISSUED FOR REVIEW & COMMENT													

Brown & Root Inc.
ENGINEERS-CONSTRUCTORS
HOUSTON, TEXAS

SOUTH TEXAS PROJECT

BROWN & ROOT INC. MICROFILM SERVICES

WEDNESDAY, AUG. 29, 1979



INFORMATION PRELIMINARY REVIEW USE CONSTRUCTION

MICROFILMED MAR 18 1978

RIDS

8112180236

