


INFORMATION
THIS DOCUMENT IS
SUBJECT TO REVISION
WITHOUT NOTIFICATION
TO THE USER OF THIS
COPY

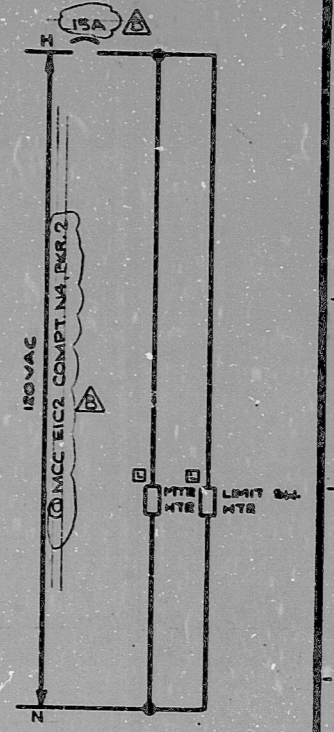

TO ANN CPO04
VCT TSOA VLV.
OVERLOAD
1-5

CS-MB (4549)

BLOCK	CONTACT	POSITION			USE
		CLOSE	AUTO	OPEN	
A	NO (1)		X	X	SP
	NO (2)	X			CONT
D	NC (5)	X	X		CONT
	NO (4)			X	CONT

SPRING RETURN TO AUTO
X-DENOTES CONTACT CLOSED
G.E. CAT# CR2940US203E

33-LCV112B

CONTACT	VALVE POSITION		USE
	CLOSE	OPEN	
1			THIS DNG
2			SPARE
3			THIS DNG
4			THIS DNG
5			THIS DNG
6			SPARE
7			THIS DNG
8			SPARE
9			SPARE
10			SPARE
11			SPARE
12			SPARE
13			SPARE
14			SPARE
15			SPARE
16			SPARE
17			OPENS ON MECH. OVERLOAD ON CLOSING THIS DNG
18			OPENS ON MECH. OVERLOAD ON OPENING THIS DNG

- REFERENCE DRAWINGS
- 0-E-0103 - ELECT. WIRING STANDARDS & SYMBOLS
 - 1-E-2662-SH-9 - VCT OUTLET ISOLATION VALVE CONTROL WIRING DIAGRAM
 - 1-E-6556 - LOGIC DIAGRAM VCT OUTLET ISOLATION VALVE LCV 112B
 - 271C333 - VOLUME CONTROL TANK OUTLET ISOLATION VALVE

- NOTES
- 1 - K854 CONTACT CLOSING ON SAFETY INJECTION
 - 2 - K942 CONTACT CLOSING ON VOLUME CONTROL TANK LOW-LOW LEVEL
- LEGEND
- IRROG - SOLID STATE PROTECTION ACTUATION TRAIN 'C' CABINET

TERA
APERTURE
CARD

ISSUED FOR USE	DATE	BY	DESCRIPTION	BY	DATE	DESCRIPTION	BY	DATE	DESCRIPTION
ISSUED FOR REVIEW/COMMENT	JAN 68	CS							
DESCRIPTION	BY	CHK	DATE	DATE	DATE	DATE	DATE	DATE	DATE

Brown & Root Inc.
ENGINEERS CONSTRUCTORS
HOUSTON, TEXAS

SOUTH TEXAS
PROJECT

NUCLEAR SAFETY RELATED
CLASS 1E


PKG: 034 SUFF: 102 ACT: 581

DRAWING TITLE	CONTRACT NO. SCALE
ELECTRICAL	CR-0241 NONE
ELEMENTARY DIAGRAM	DRAWING NO 4-R-17
VCT OUTLET ISOLATION VALVE LCV 112B	1-E-4556-B

INFORMATION PRELIMINARY REVIEW BLUE CONSTRUCTION

BROWN & ROOT INC.
MICROFILM SERVICES

WEDNESDAY, AUG. 29 1979

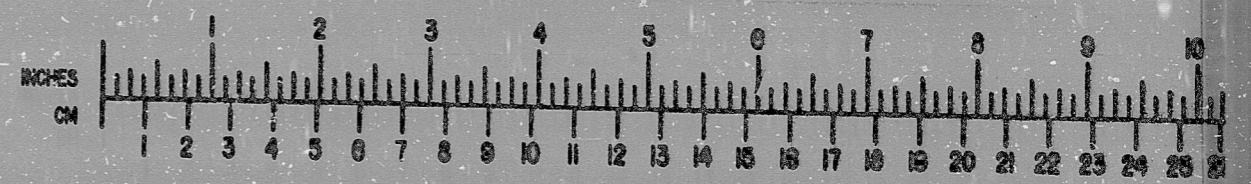

17"

RIDS

8112180241

