

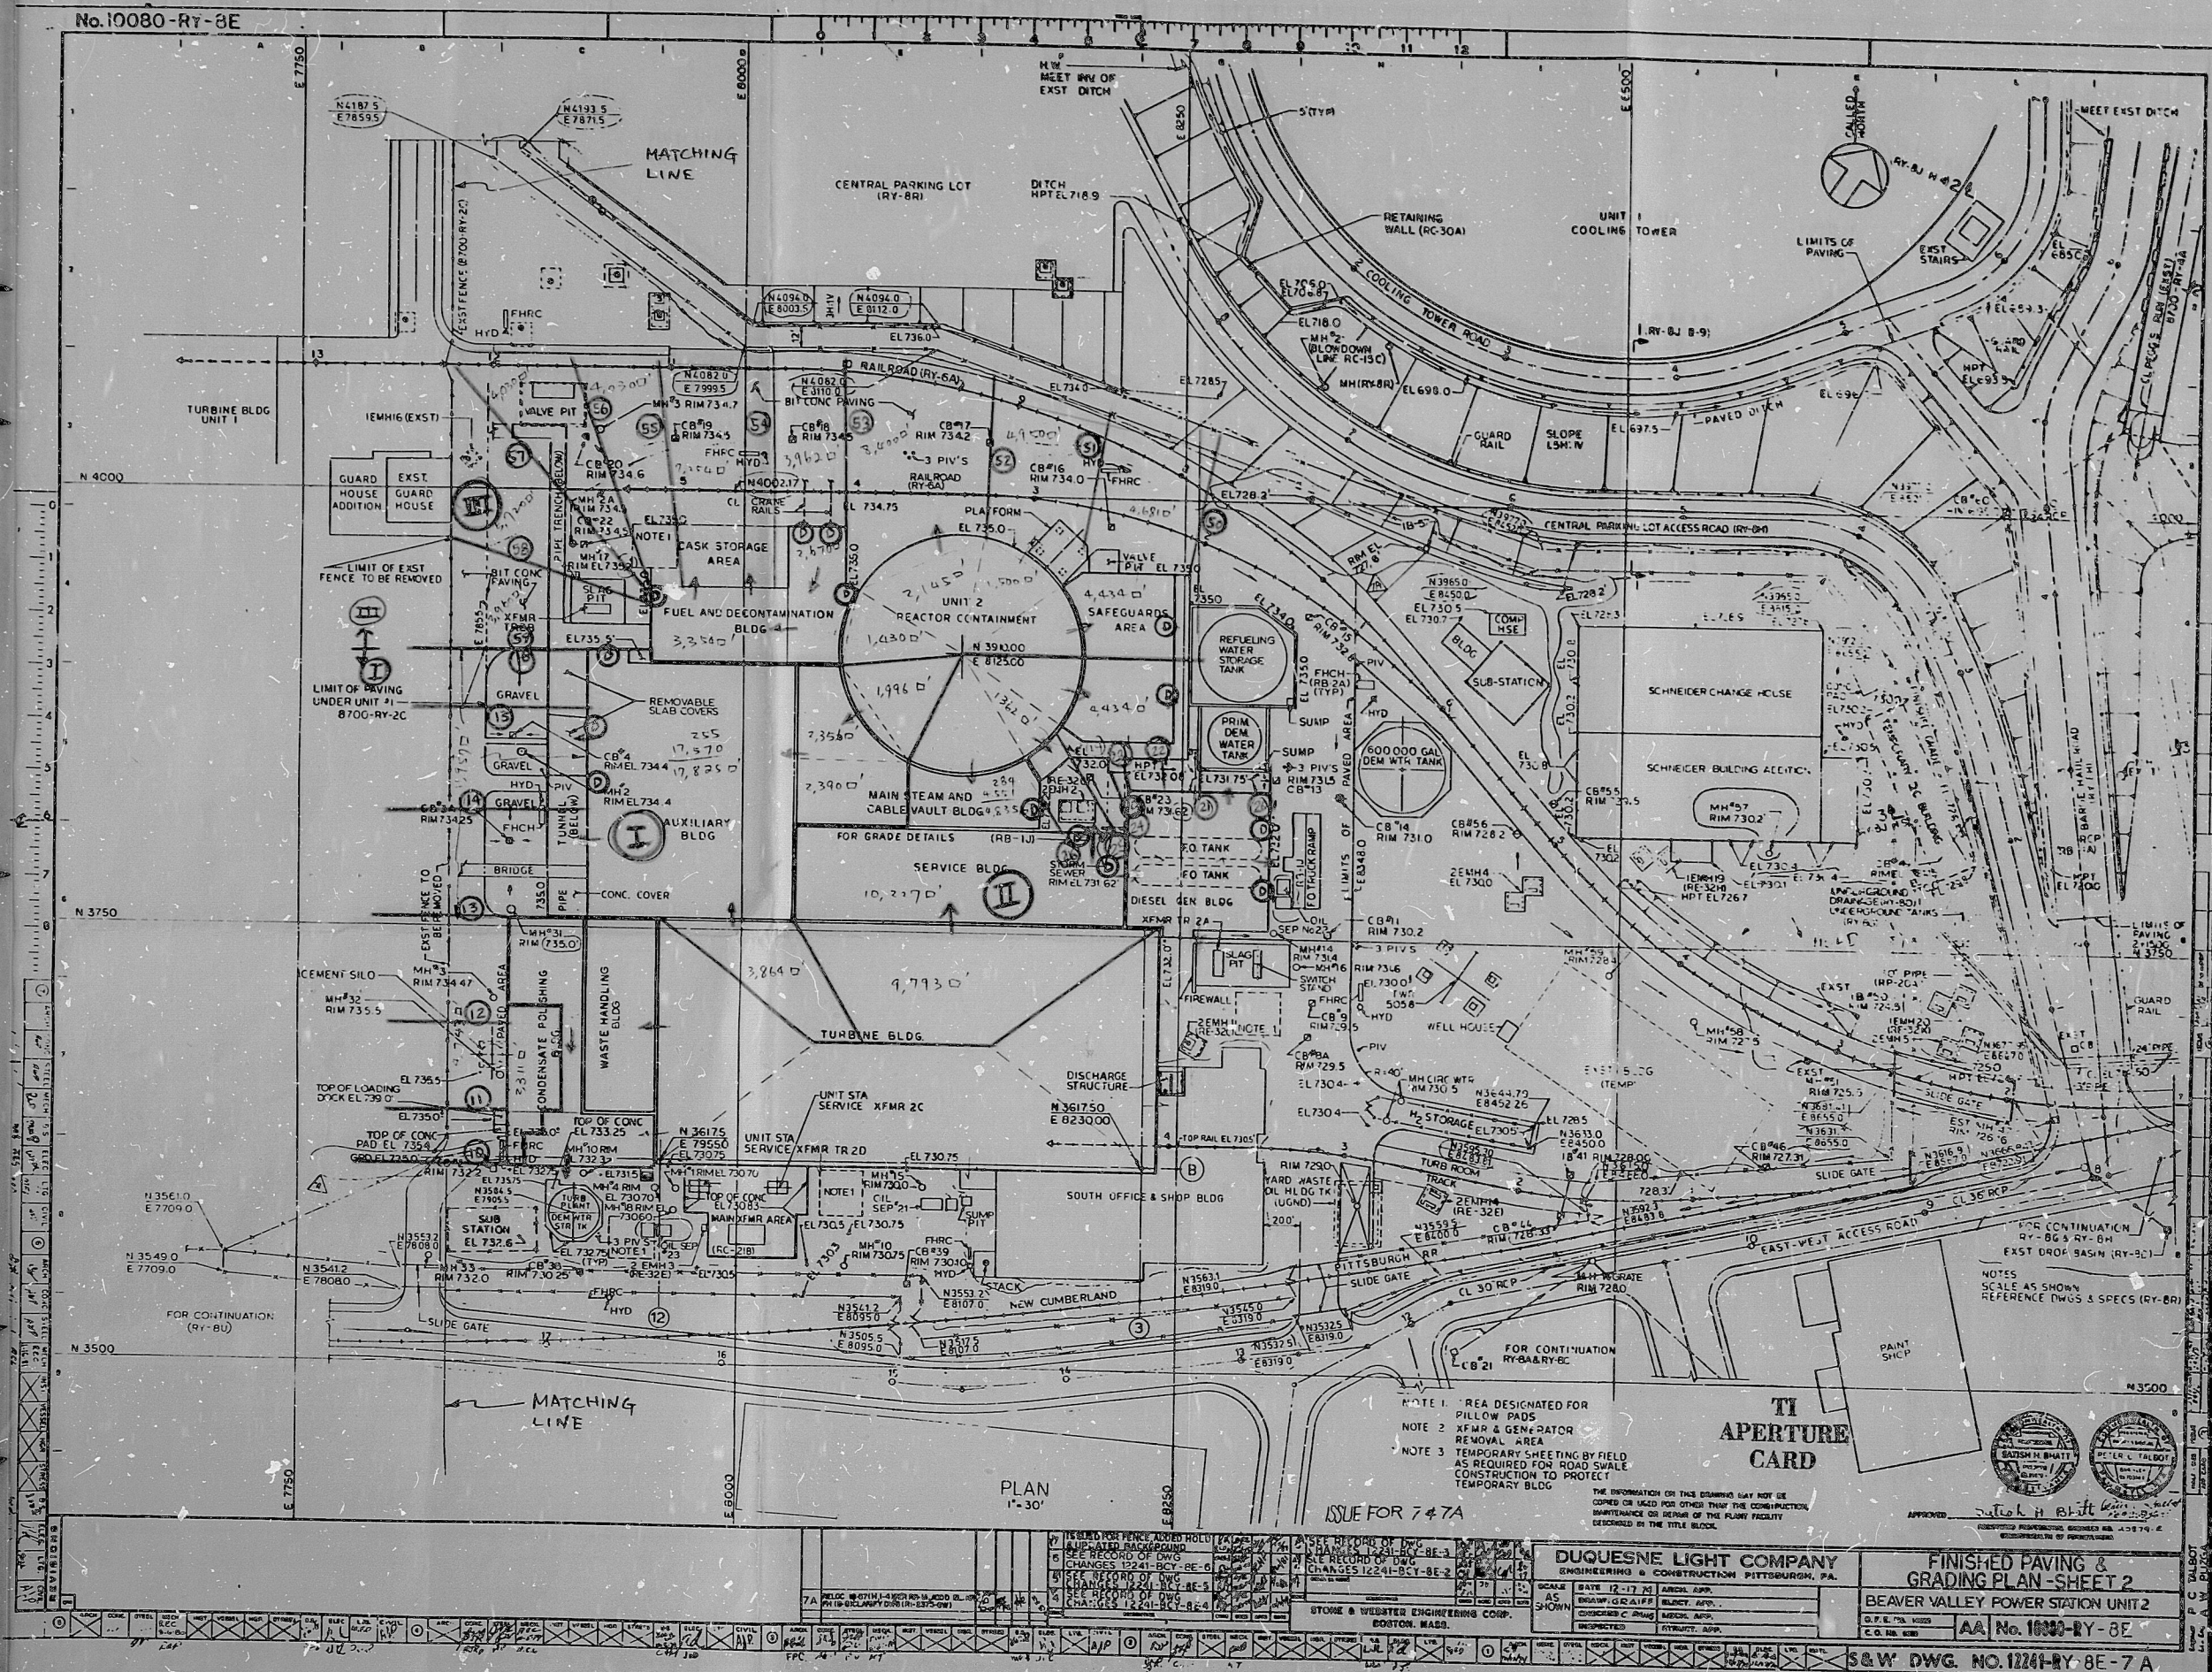


Figure 240.16-3

8411190332

PDR RIDS

841119D332

