

17"

17"

11"

11"

8.5"

8.5"

8.5"


8.5"

11"

11"

17"

17"

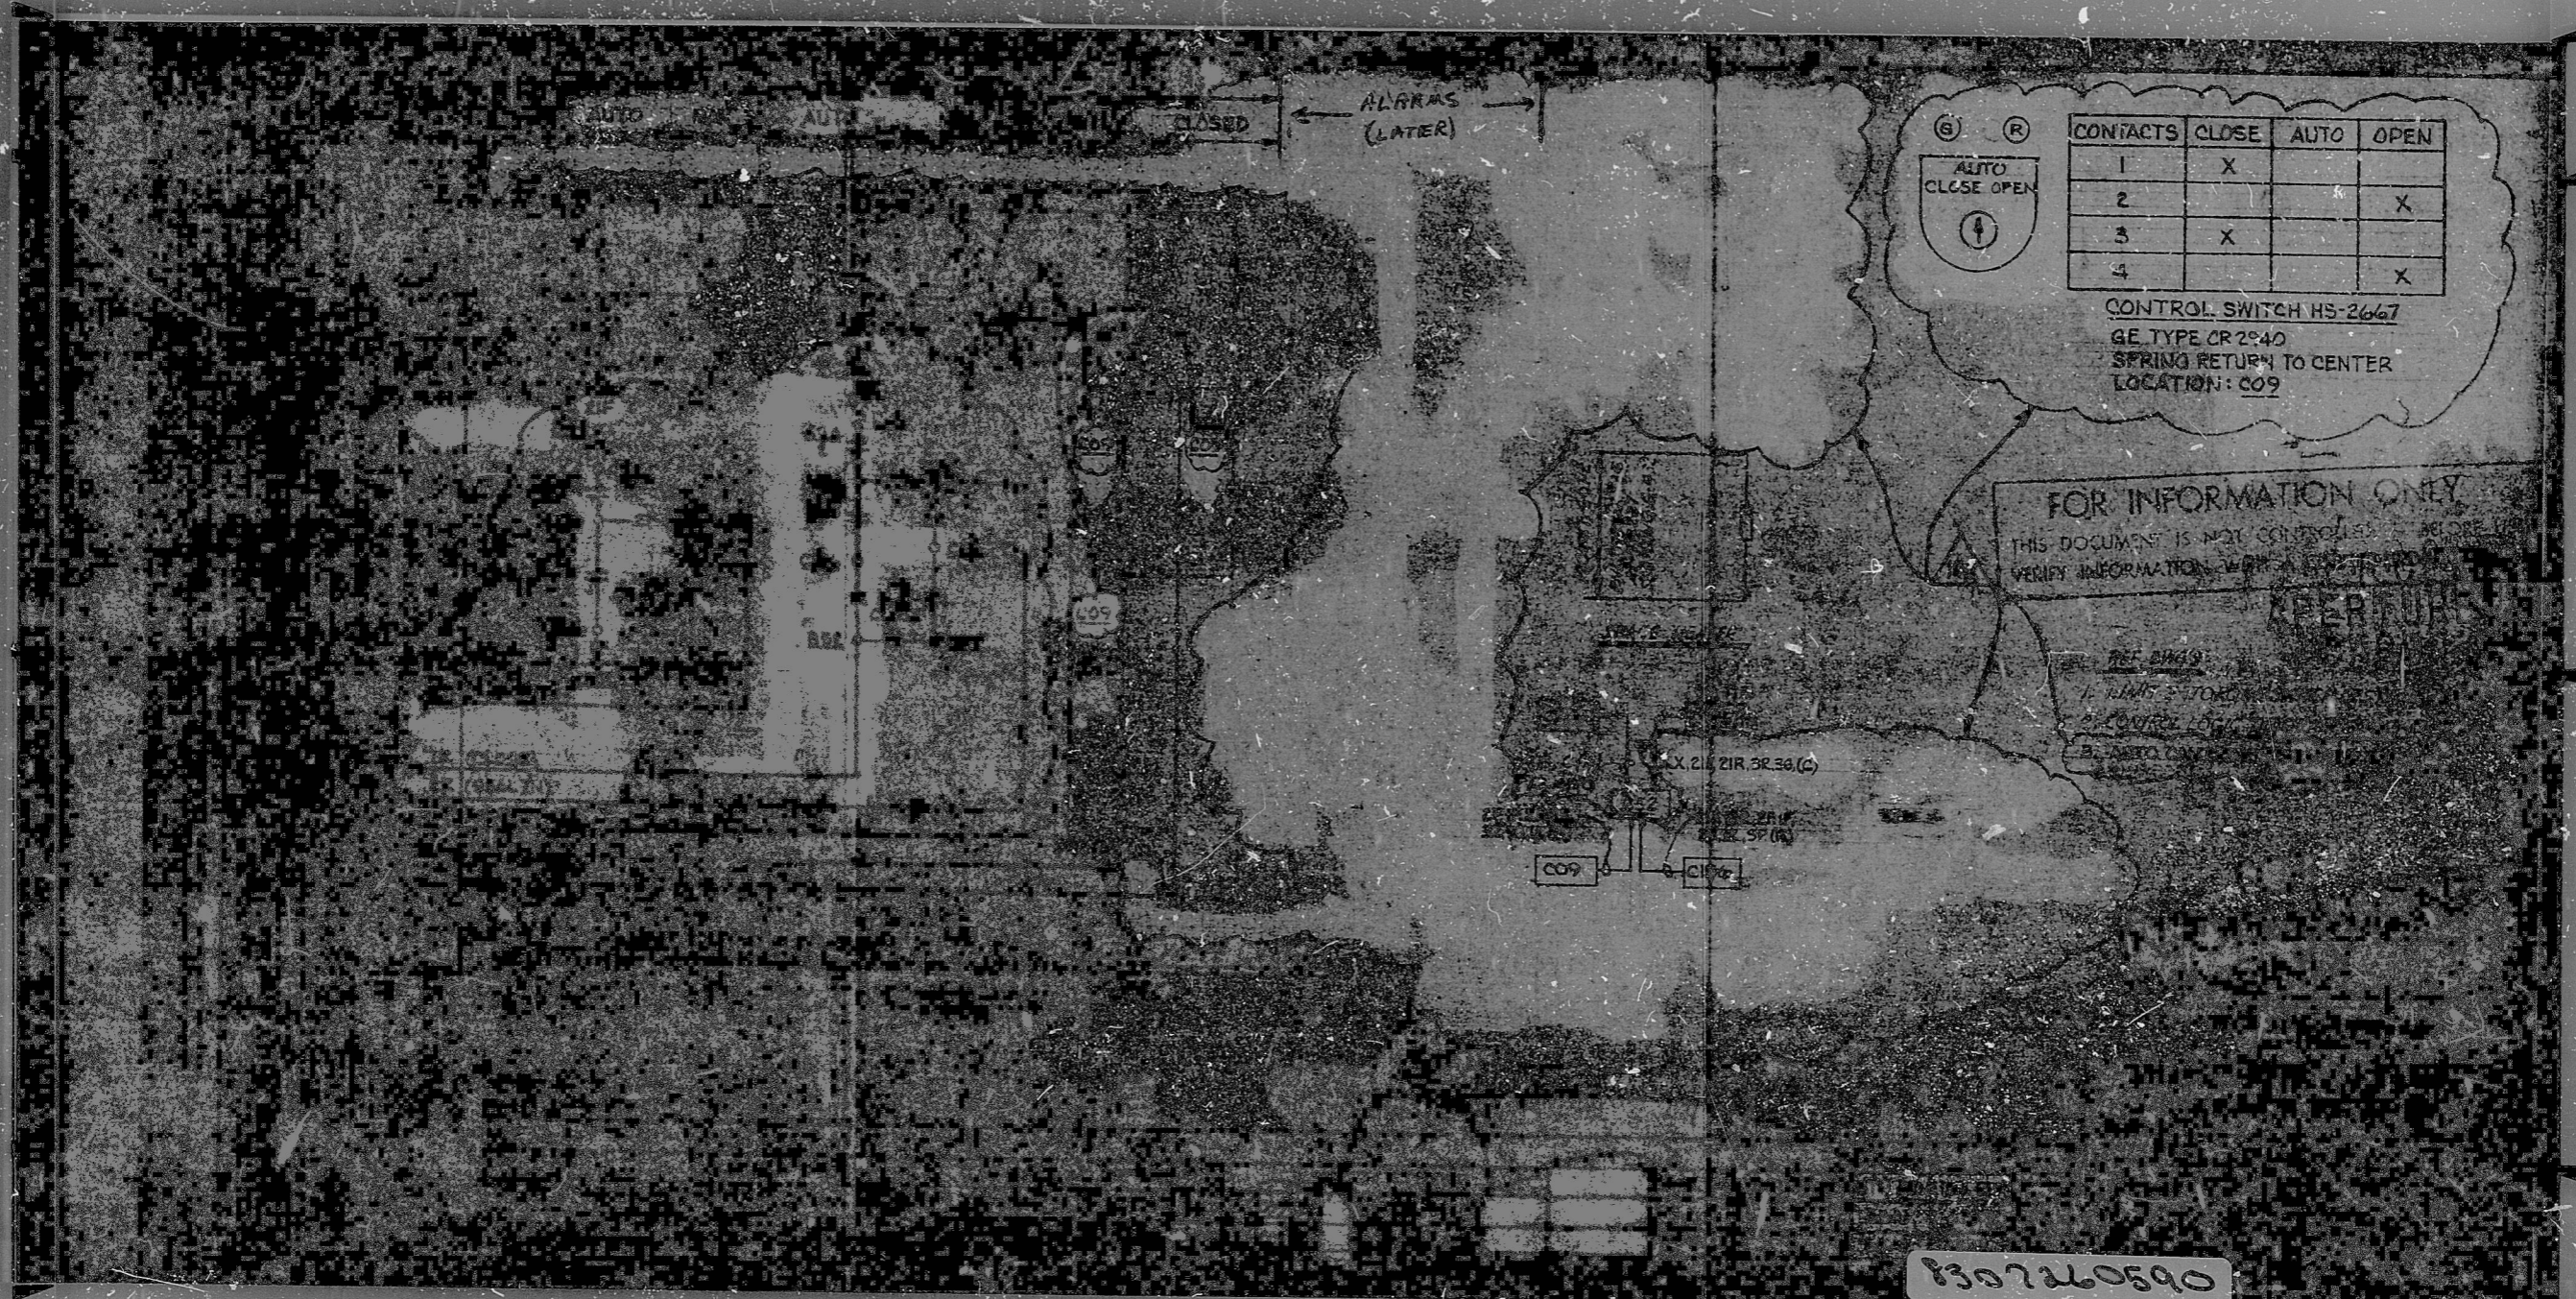



RWD

8307260590

