



REV. 24	BUILDING: DOG HOUSE 8	ISO. NO.: MCFI-15M9	DUKE PIPING CLASS: ASME SECT III: CLASS B
		SYSTEM SYMBOL: SM - MAIN STEAM	PIPING SPEC.: SM-01 PS 1500.5 & 6 CLEAN: LEVEL III
		DRAWING NO.: MC1419-73.20-00 & MC1676-1.2 EL. 750'-0"	
PROJECT: McQUIRE			
NO.	REVISION	DATE	DESCRIPTION
1	ADD DETAIL "A"	(SMIF 286)	
2	ADD WELDS SMIF 355 AND 356, REV POSITION OF CL CHANGE		
3	ADD WELDS SMIF 355 AND 356, REV POSITION OF CL CHANGE		
4	ADDED CONT. ON MCFI-15M9		
5	ADDED INST. NO. 15M9L5 5860		
6	ADDED CONT. ON MCFI-15M9		
7	ADDED WELDS SMIF 473		

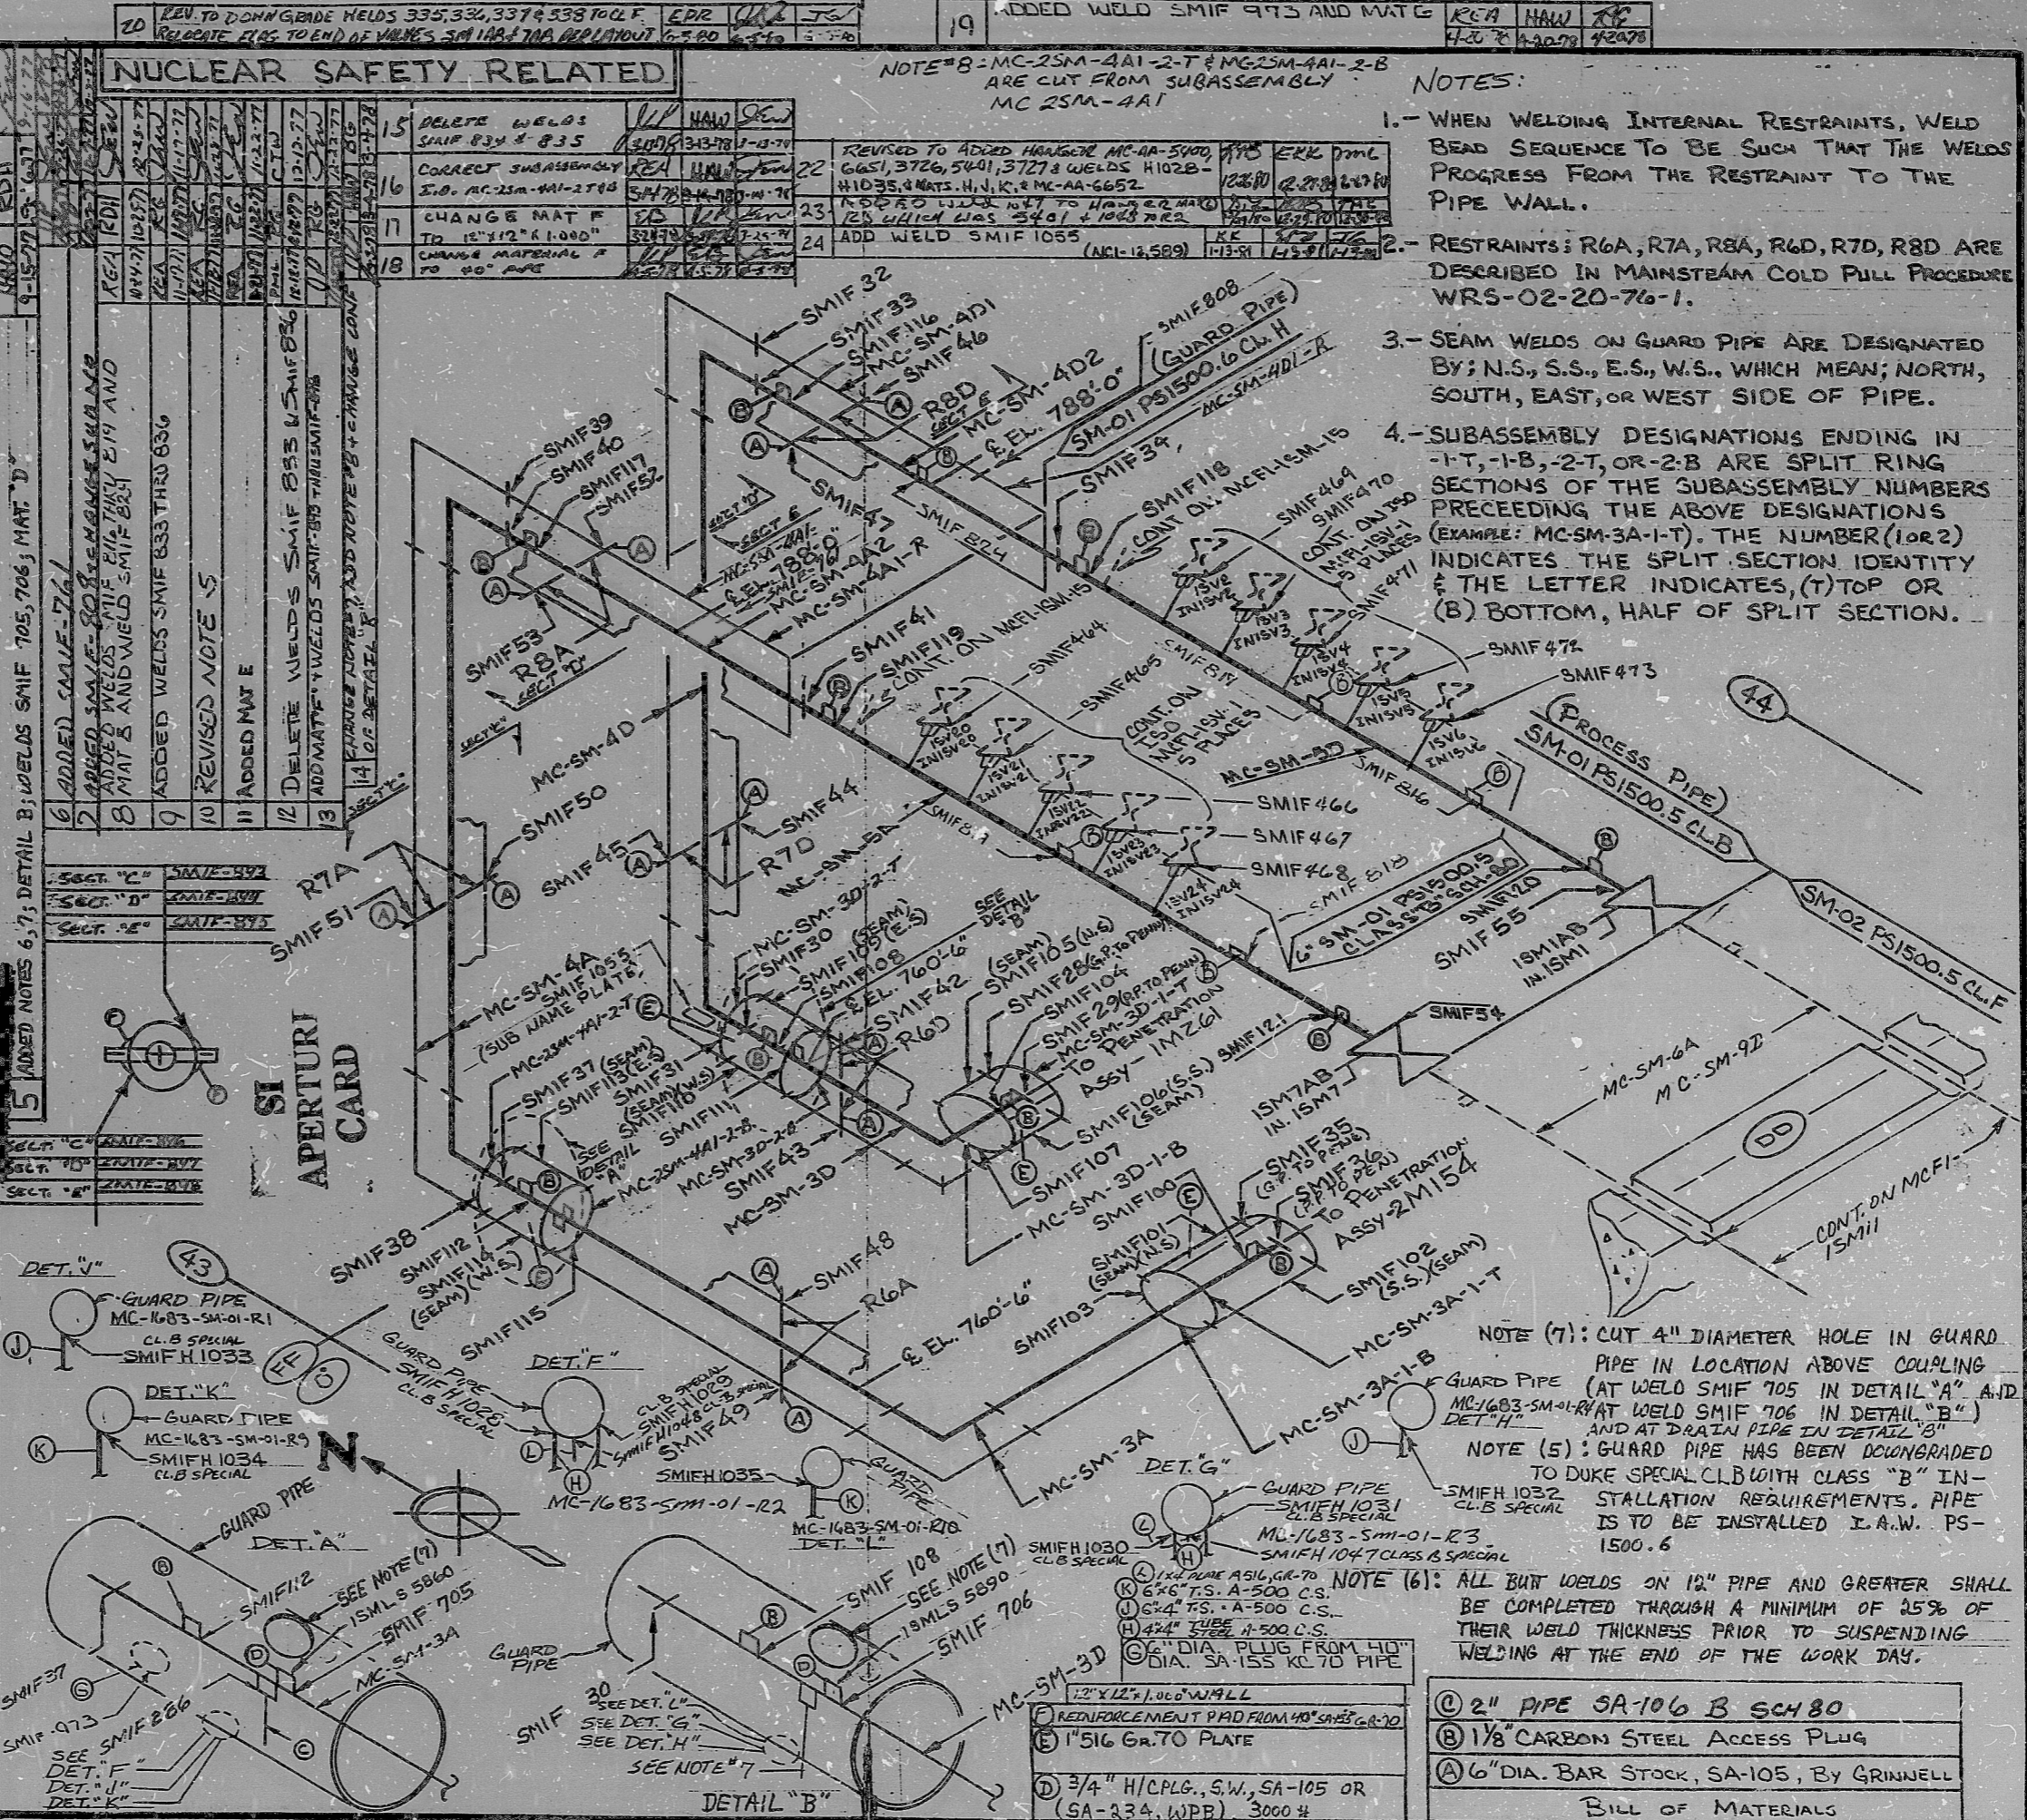

NOTE #8 - MC-25M-4A1-2-T & MC-25M-4A1-2-B ARE CUT FROM SUBASSEMBLY MC-25M-4A1


- NOTES:
1. WHEN WELDING INTERNAL RESTRAINTS, WELD BEAD SEQUENCE TO BE SUCH THAT THE WELDS PROGRESS FROM THE RESTRAINT TO THE PIPE WALL.
 2. RESTRAINTS: R6A, R7A, R8A, R6D, R7D, R8D ARE DESCRIBED IN MAINSTEAM COLD PULL PROCEDURE WRS-02-20-76-1.
 3. SEAM WELDS ON GUARD PIPE ARE DESIGNATED BY; N.S., S.S., E.S., W.S., WHICH MEAN; NORTH, SOUTH, EAST, OR WEST SIDE OF PIPE.
 4. SUBASSEMBLY DESIGNATIONS ENDING IN -1-T, -1-B, -2-T, OR -2-B ARE SPLIT RING SECTIONS OF THE SUBASSEMBLY NUMBERS PRECEEDING THE ABOVE DESIGNATIONS (EXAMPLE: MC-SM-3A-1-T). THE NUMBER (1 OR 2) INDICATES THE SPLIT SECTION IDENTITY & THE LETTER INDICATES, (T) TOP OR (B) BOTTOM, HALF OF SPLIT SECTION.

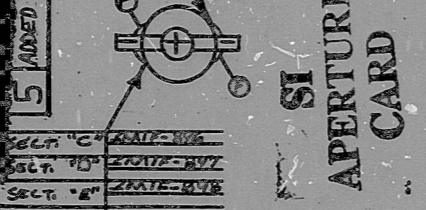

NOTE (7): CUT 4" DIAMETER HOLE IN GUARD PIPE IN LOCATION ABOVE COUPLING (AT WELD SMIF 705 IN DETAIL "A" AND MC1683-SM-01-R1 AT WELD SMIF 706 IN DETAIL "B") AND AT DRAIN PIPE IN DETAIL "C"

NOTE (5): GUARD PIPE HAS BEEN DOWNGRADED TO DUKE SPECIAL CL.B WITH CLASS "B" INSTALLATION REQUIREMENTS. PIPE IS TO BE INSTALLED I.A.W. PS-1500.6

NOTE (6): ALL BUT WELDS ON 12" PIPE AND GREATER SHALL BE COMPLETED THROUGH A MINIMUM OF 25% OF THEIR WELD THICKNESS PRIOR TO SUSPENDING WELDING AT THE END OF THE WORK DAY.

①	2" PIPE SA-106 B SCH 80
②	1 1/8" CARBON STEEL ACCESS PLUG
③	6" DIA. BAR STOCK, SA-105, BY GRINNELL

BILL OF MATERIALS

DUNCAN-PARNELL, INC., CHARLOTTE 778

8903280368

PDR RIDS

