




0-2091-3-1

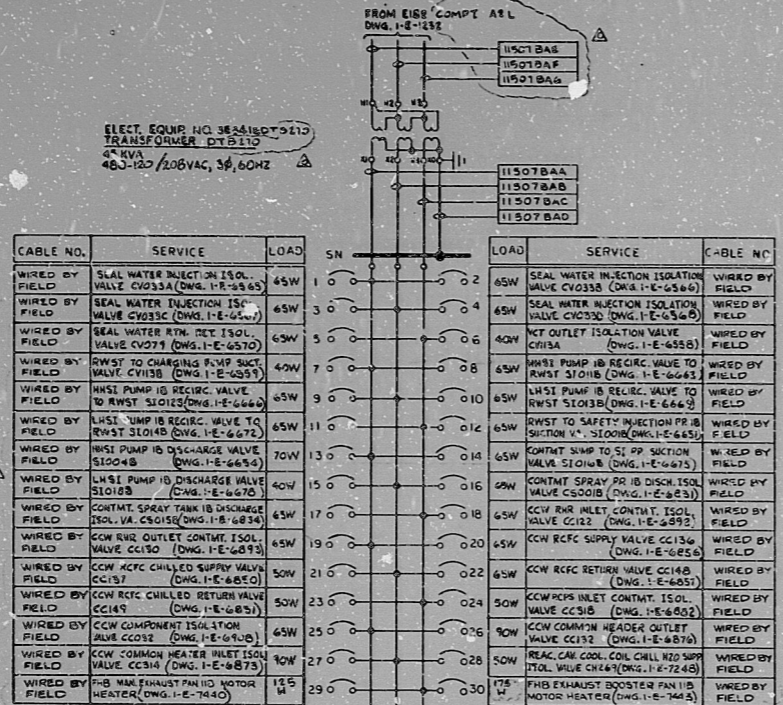

CABLE NO.	SERVICE	LOAD	SN	LOAD	SERVICE	CABLE NO.
WIRED BY FIELD	SEAL WATER INJECTION ISOL. VALVE CV033A (DWG. 1-E-6563)	45W	1 0	0 2	SEAL WATER INJECTION ISOLATION VALVE CV033B (DWG. 1-E-6564)	WIRED BY FIELD
WIRED BY FIELD	SEAL WATER INJECTION ISOL. VALVE CV033C (DWG. 1-E-6565)	45W	3 0	0 4	SEAL WATER INJECTION ISOLATION VALVE CV033D (DWG. 1-E-6566)	WIRED BY FIELD

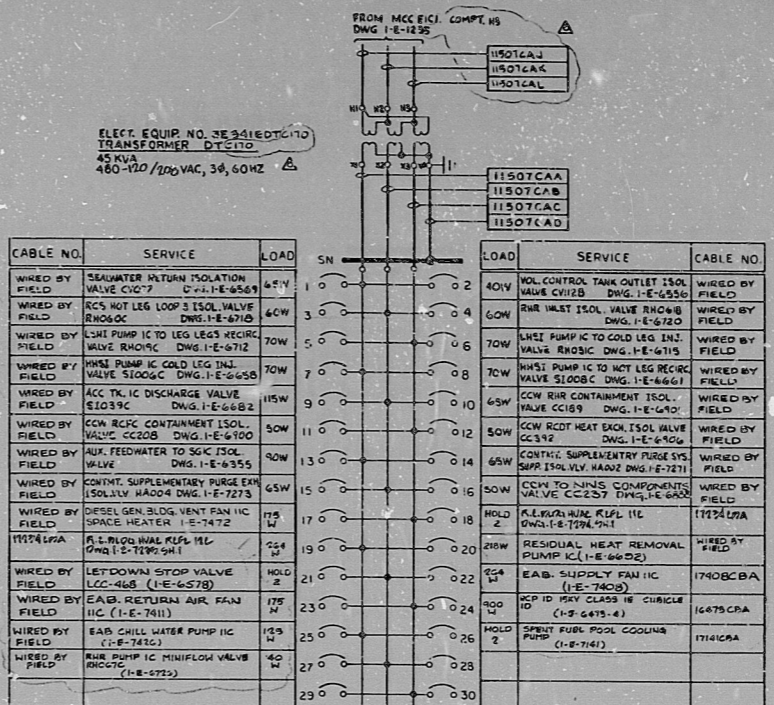

CABLE NO.	SERVICE	LOAD	SN	LOAD	SERVICE	CABLE NO.
WIRED BY FIELD	SEAWATER RETURN ISOLATION VALVE CV07 (DWG. 1-E-6569)	45W	1 0	0 2	WT1 PUMP IC TO HOT LEG RECIRC. VALVE S1008C (DWG. 1-E-6461)	WIRED BY FIELD
WIRED BY FIELD	RCS HOT LEG LOOP 3 ISOL. VALVE EN006C (DWG. 1-E-6749)	60W	3 0	0 4	WT1 PUMP IC TO HOT LEG RECIRC. VALVE S1008D (DWG. 1-E-6462)	WIRED BY FIELD

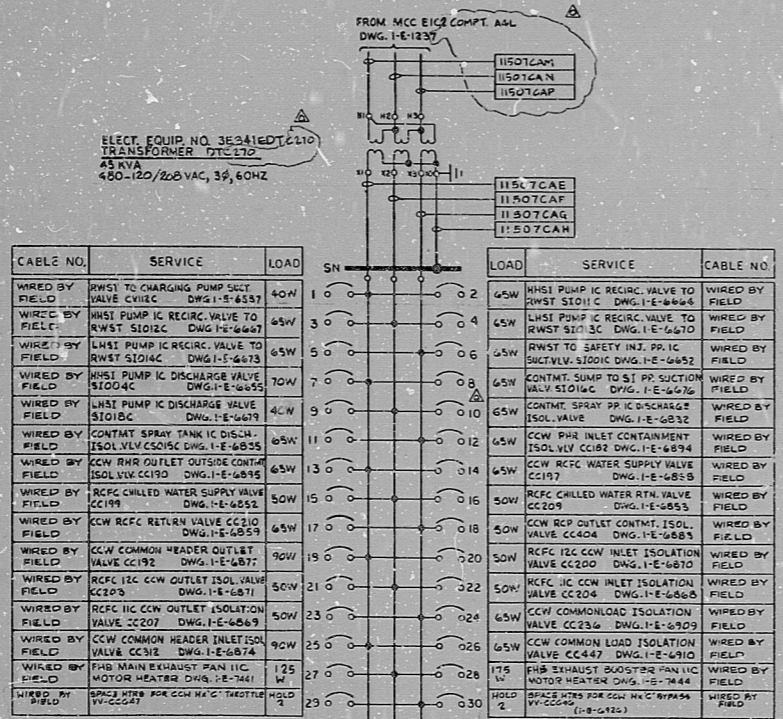

CABLE NO.	SERVICE	LOAD	SN	LOAD	SERVICE	CABLE NO.
WIRED BY FIELD	RWST TO CHARGING PUMP SUCT. VALVE CV103C (DWG. 1-E-6585)	40W	1 0	0 2	WT1 PUMP IC RECIRC. VALVE TO RWST S1011C (DWG. 1-E-6644)	WIRED BY FIELD

INFORMATION
THIS DOCUMENT IS
SUBJECT TO REVISION
WITHOUT NOTIFICATION
TO THE USER OF THIS
COPY

NOTES
1 ALL BREAKERS ARE 20 AMP UNLESS OTHERWISE NOTED.

REFERENCE DWGS
G-E-0105 WIRING STANDARDS & SYMBOLS

TERA APERTURE CARD

NUCLEAR SAFETY RELATED
CLASS I E

PKG:024 SUFF:102 ACT:581

REV.	DATE	DESCRIPTION	BY	CHKD	APP'D
0	02-27	REVISED FOR CONSTRUCTION	RM	HT	HT
1	10-30-79	ISSUED FOR USE	RLA	HT	HT

Brown & Root, Inc.
SOUTH TEXAS PROJECT
ELECTRICAL
PANELBOARD SCHEDULES
MCC SPACE HEATERS & MOTOR HEATERS
MCC-E1B2, E1C1, E1C2

CONTRACT NO. CR-0241 SCALE NONE
DRAWING NO. 4-E-51
1-E-1507-0

INFORMATION PRELIMINARY REVIEW USE CONSTRUCTION



BROWN & ROOT INC.
MICROFILM SERVICES

8.5"

11"

17"

8.5"

11"

17"

RIDS

8112210099

