

INSERVICE INSPECTION

ISO NO: MCFI-2ND5

DUKE PIPING CLASS: ASME SECTION III CLB


SYSTEM SYMBOL: RESIDUAL HEAT REMOVAL AID

PIPING SPEC: ND-03, PS. 401.2

DRAWING NO.: 2414-04.40-00; 2414-04.41-00

PROJECT: MCGUIRE

REV.	DATE	BY	CHKD.	APPR.	DATE

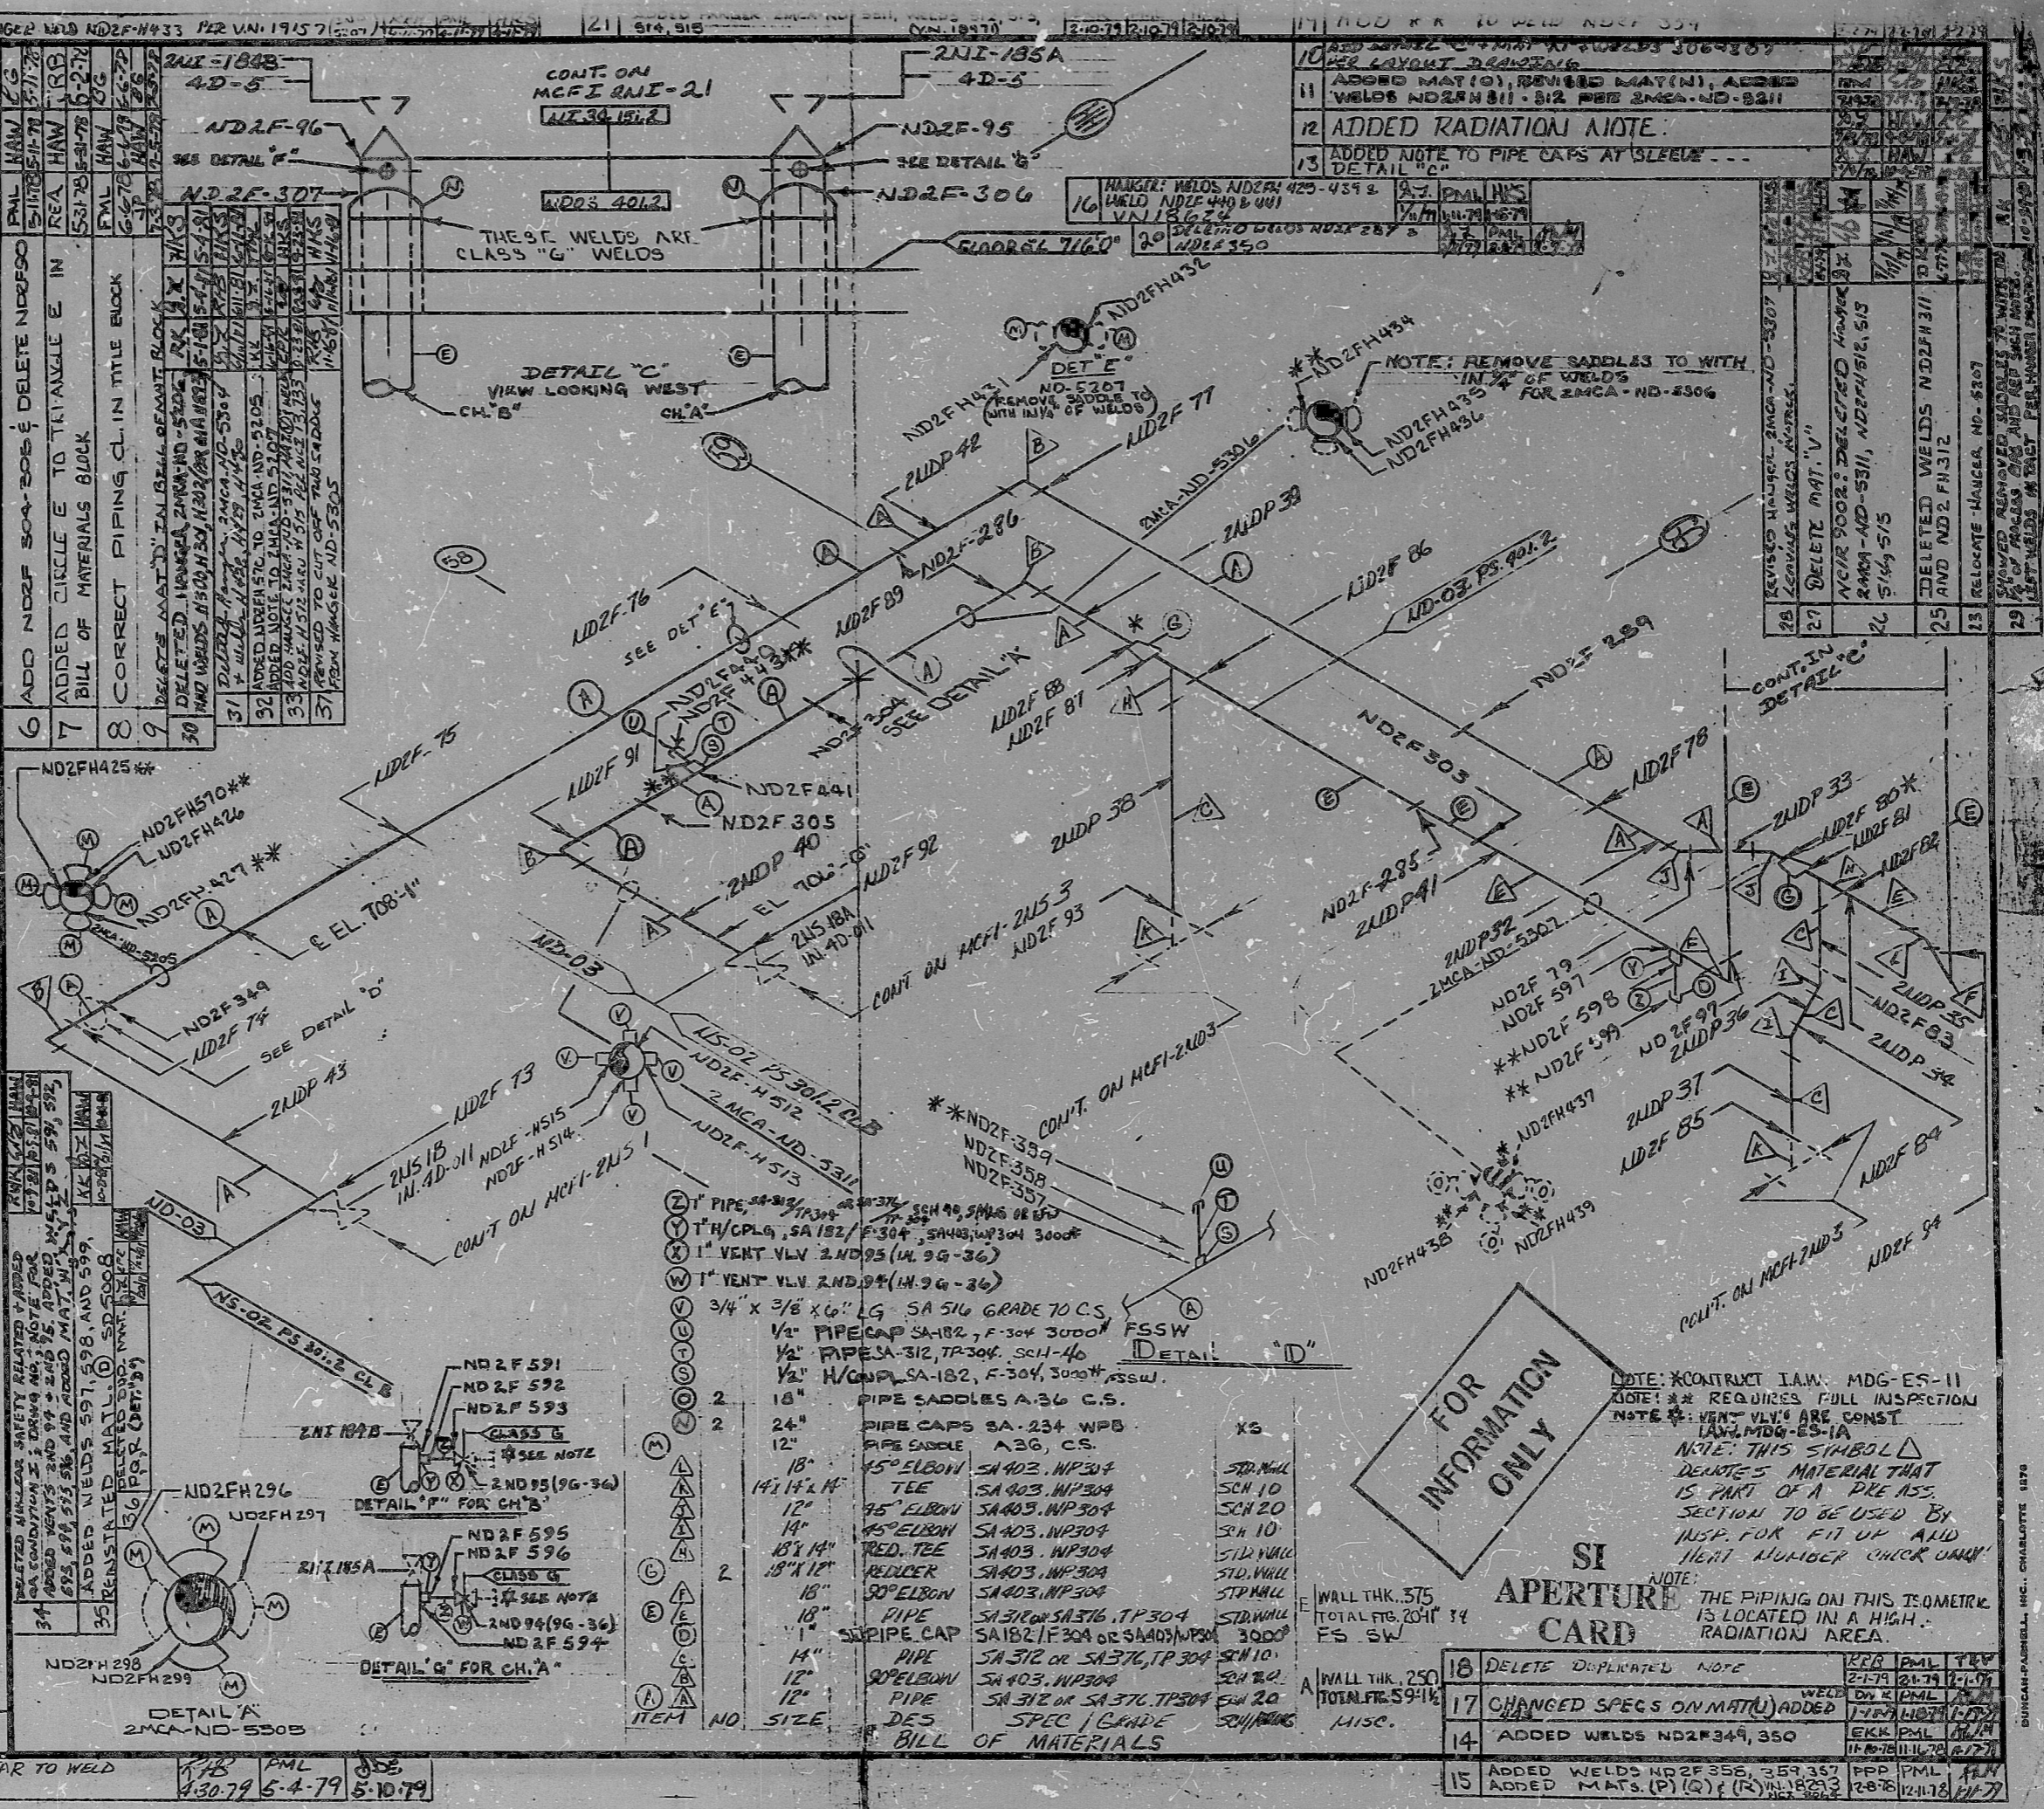

FOR INFORMATION ONLY

SI APERTURE CARD

NOTE: CONTRACT I.A.W. MDG-ES-11
 NOTE: ** REQUIRES FULL INSPECTION
 NOTE: ** VENT VLV'S ARE CONST
 I.A.W. MDG-ES-1A
 NOTE: THIS SYMBOL Δ
 DENOTES MATERIAL THAT
 IS PART OF A PRE ASS.
 SECTION TO BE USED BY
 INSP. FOR FIT UP AND
 HEAT NUMBER CHECK ONLY

THE PIPING ON THIS ISOMETRIC
 IS LOCATED IN A HIGH-
 RADIATION AREA.

18	DELETED DUPLICATED NOTE	KFR	PML	TRV
17	CHANGED SPECS ON MAT'L ADDED	WEL	ON E	PML
14	ADDED WELDS NDZF 349, 350	EKK	PML	H/A

NO.	REVISION	DATE	BY	CHKD.	APPR.
0					

REV.	DATE	BY	CHKD.	APPR.	DATE
6					
7					
8					
9					
10					
11					
12					
13					
16					
20					
28					
27					
26					
25					
23					
22					
PDR RIDS

8903290355

