

NOTES

1. AMBER LIGHT INDICATES ON-LOAD CONDITION IN SAFETY RELATED MOV'S
2. FOR DETAILS OF FOOT PRINTS, TO BE FOR SCALE REFER TO DRAWING 480V ESF MCC E1C2

REFERENCE DWGS

1-E-1212	ONE LINE DIAGRAM 480V ESF
0-E-0105	480V ESF MCC E1C2
84-7500-07	WIRING STANDARD AND SYMBOLS
MA5500-07	ITEM BILL OF MATERIALS (SPEC FOR MCC E1C2)
	SEE NAMEPLATE SCHEDULE FOR MCC E1C2

NUCLEAR SAFETY RELATED CLASS 1E

PKS-011 SUFF: 102 ACT: 591

INFORMATION
THIS DOCUMENT IS
SUBJECT TO REVISION
WITHOUT NOTIFICATION
TO THE USER OF THIS
COPY

TERA
APERTURE
CARD


REV	DATE	DESCRIPTION	BY	CHK	APP	REV	DATE	DESCRIPTION	BY	CHK	APP

Brown & Root Inc.
Houston, Texas

SOUTH TEXAS PROJECT
ELECTRICAL
ONE LINE DIAGRAM
480V ESF MCC E1C2
UNIT NO. 1

CONTRACT NO. CR-0241
SCALE NONE
DRAWING NO. 4-E-51
1-E-1237-D

INFORMATION PRELIMINARY REVIEW USE CONSTRUCTION

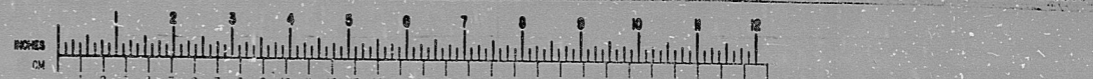

BROWN & ROOT INC.
MICROFILM SERVICES

RIDS

81/2210/29

