

22

17

11

8.5

8.5

17

22

22

17

11


8.5

8.5

17

17

22

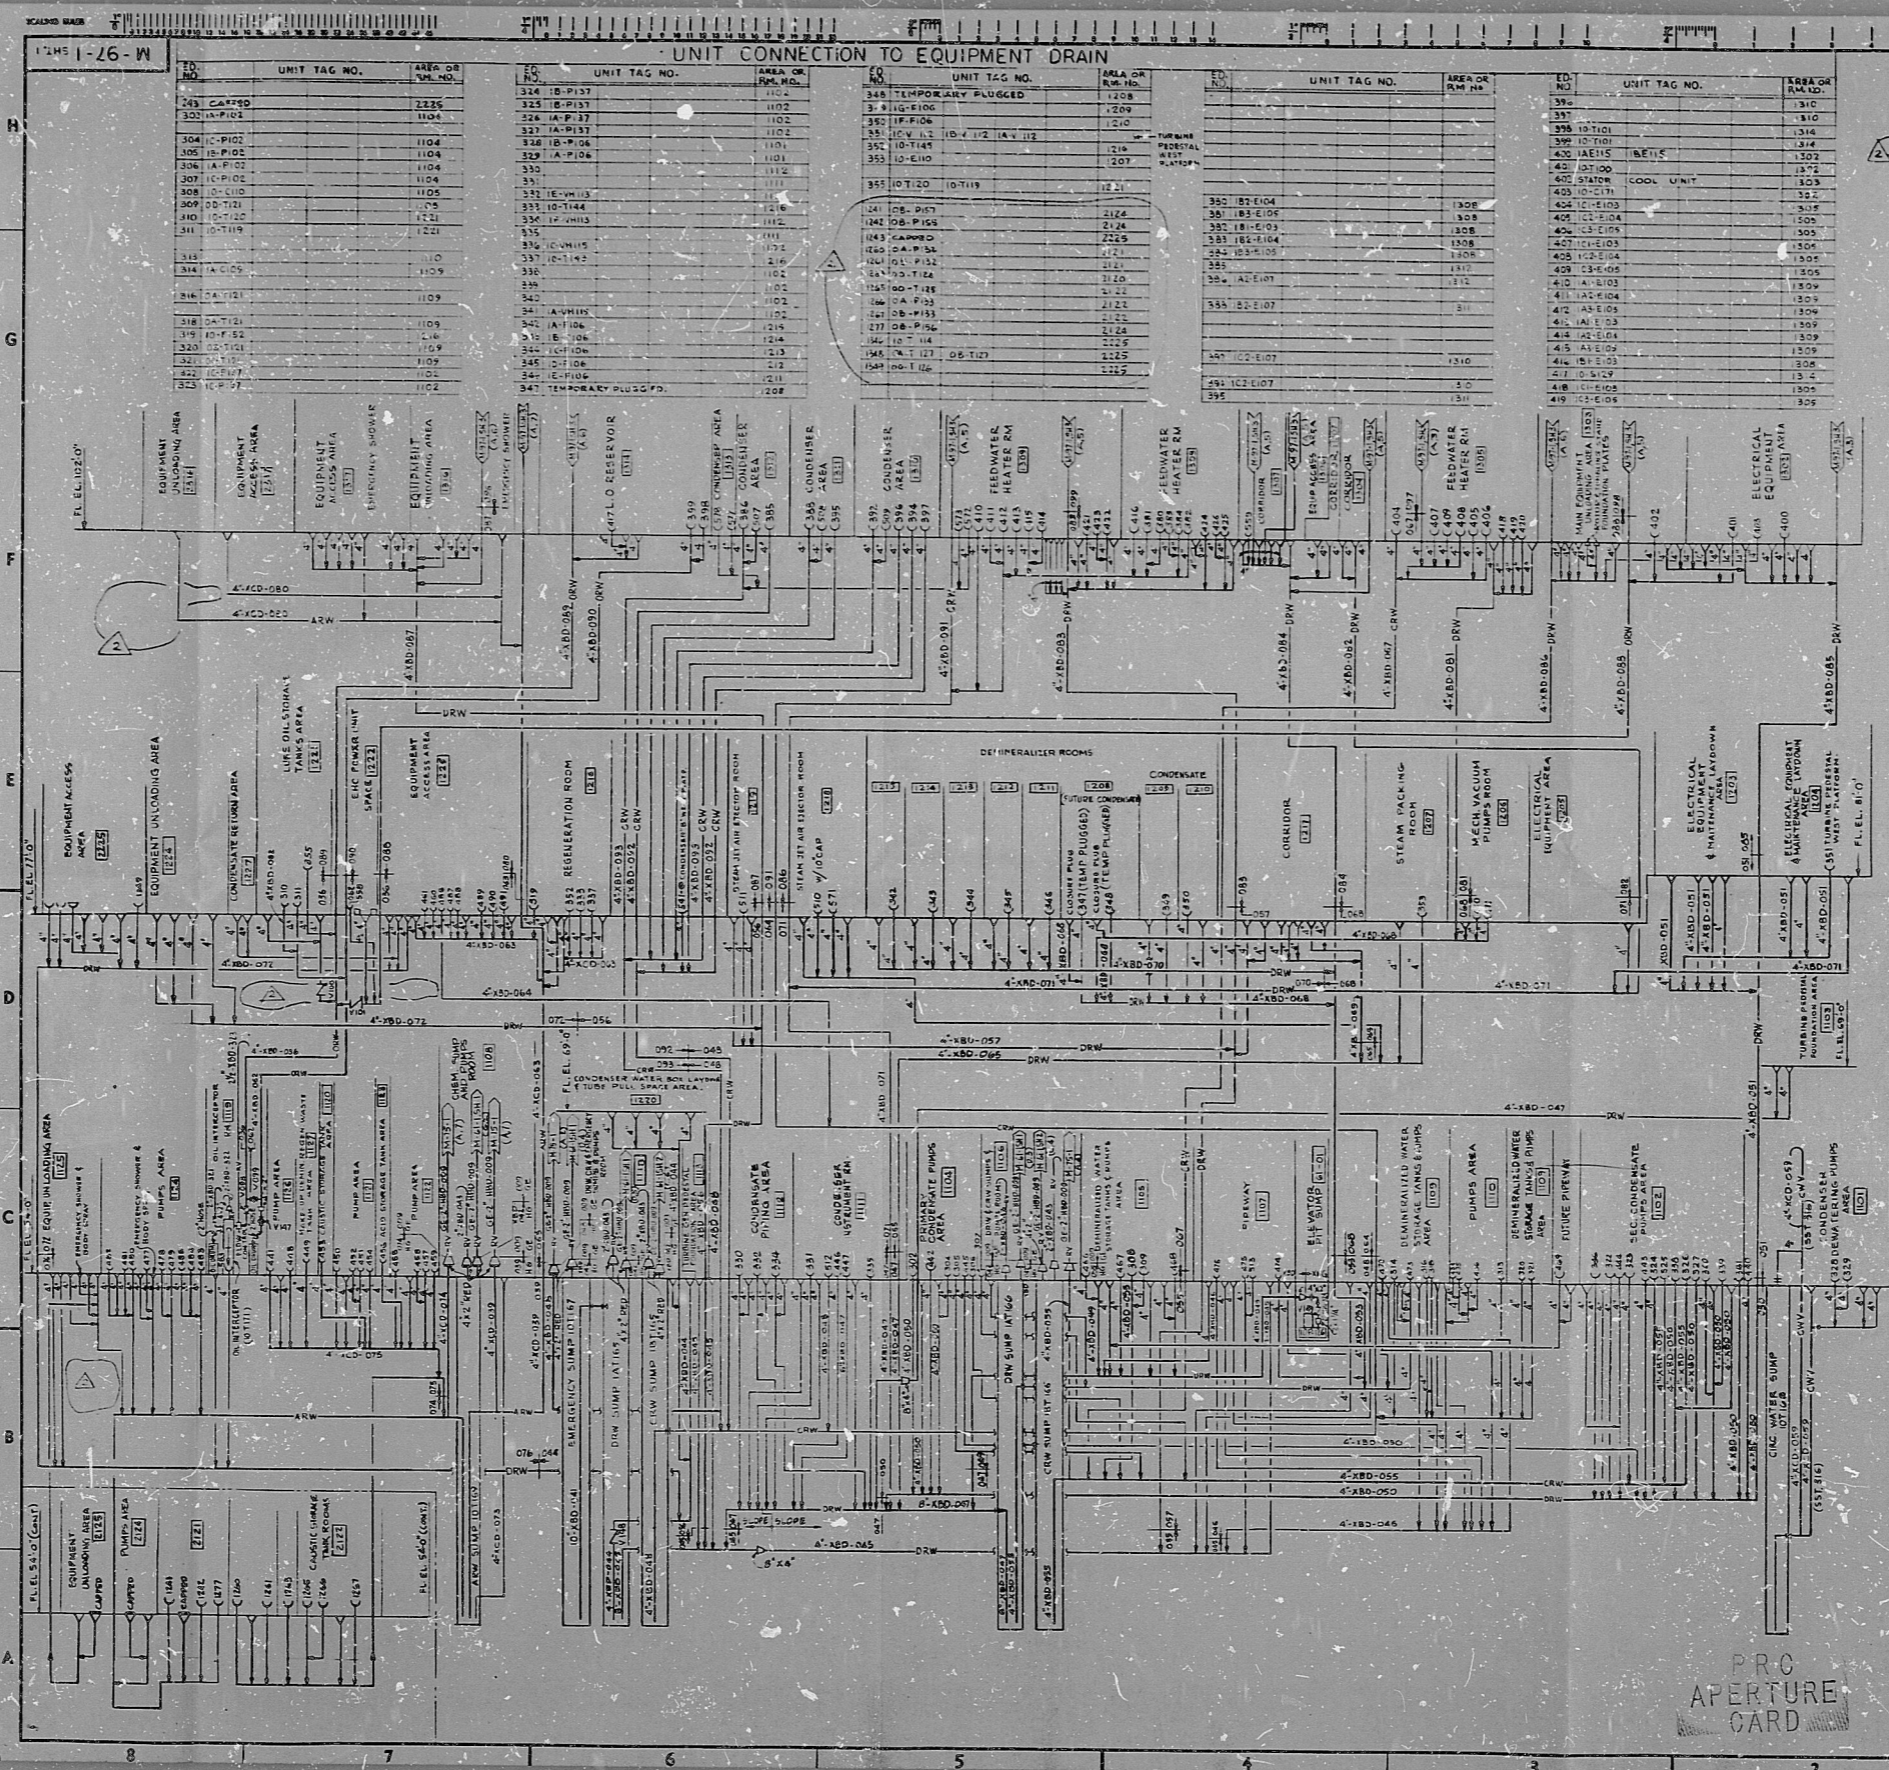

This drawing and its design is based on the project of BECHTEL. They are hereby licensed and as the licensee's copyright agreement that they are not to be reproduced, copied, modified, published, or used except in the manner and extent authorized by any written consent given by the licensor to the licensee.

SYSTEM HG	
REF	REFERENCE DRAWINGS
1	PEID TURBINE BUILDING AC PUMP DIAGRAM
2	PEID TURBINE BUILDING AC PUMP DIAGRAM
3	PEID TURBINE BUILDING AC PUMP DIAGRAM

NOTE:
1 THIS P&ID CONTAINS SYSTEMS OR PORTIONS OF SYSTEMS
HG - BUILDING & EQUIPMENT DRAIN
GE - TURBINE BUILDING HVAC

UNIT CONNECTION TO EQUIPMENT DRAIN	

BECHTEL
PUBLIC SERVICE ELECTRIC AND GAS COMPANY
NOPE CREEK GENERATING STATION

PEID
BUILDING & EQUIPMENT DRAINS
TURBINE BUILDING FL. 54.5 TO 102.0'

10855 M-97-10855-2

PRO
APERTURE
CARD

RIDS

8307270213

