


SCALES: 1/8" = 1'-0" (VERTICAL), 1/4" = 1'-0" (HORIZONTAL)

UNIT TAG NUMBERS				UNIT CONNECTION TO EQUIPMENT DRAIN			
ED. NO.	UNIT TAG NUMBERS	AREA OR ROOM NO.	ED. NO.	UNIT TAG NUMBERS	AREA OR ROOM NO.	ED. NO.	UNIT TAG NUMBERS
437	141F-108	1401	438	141F-108	1401	439	141F-108

This drawing and the design it contains are the property of BECHTEL. They are hereby loaned and all the borrower's express agreement that they are not to be reproduced, copied, loaned, sold, or otherwise disposed of in any manner whatsoever without the express written consent of BECHTEL.

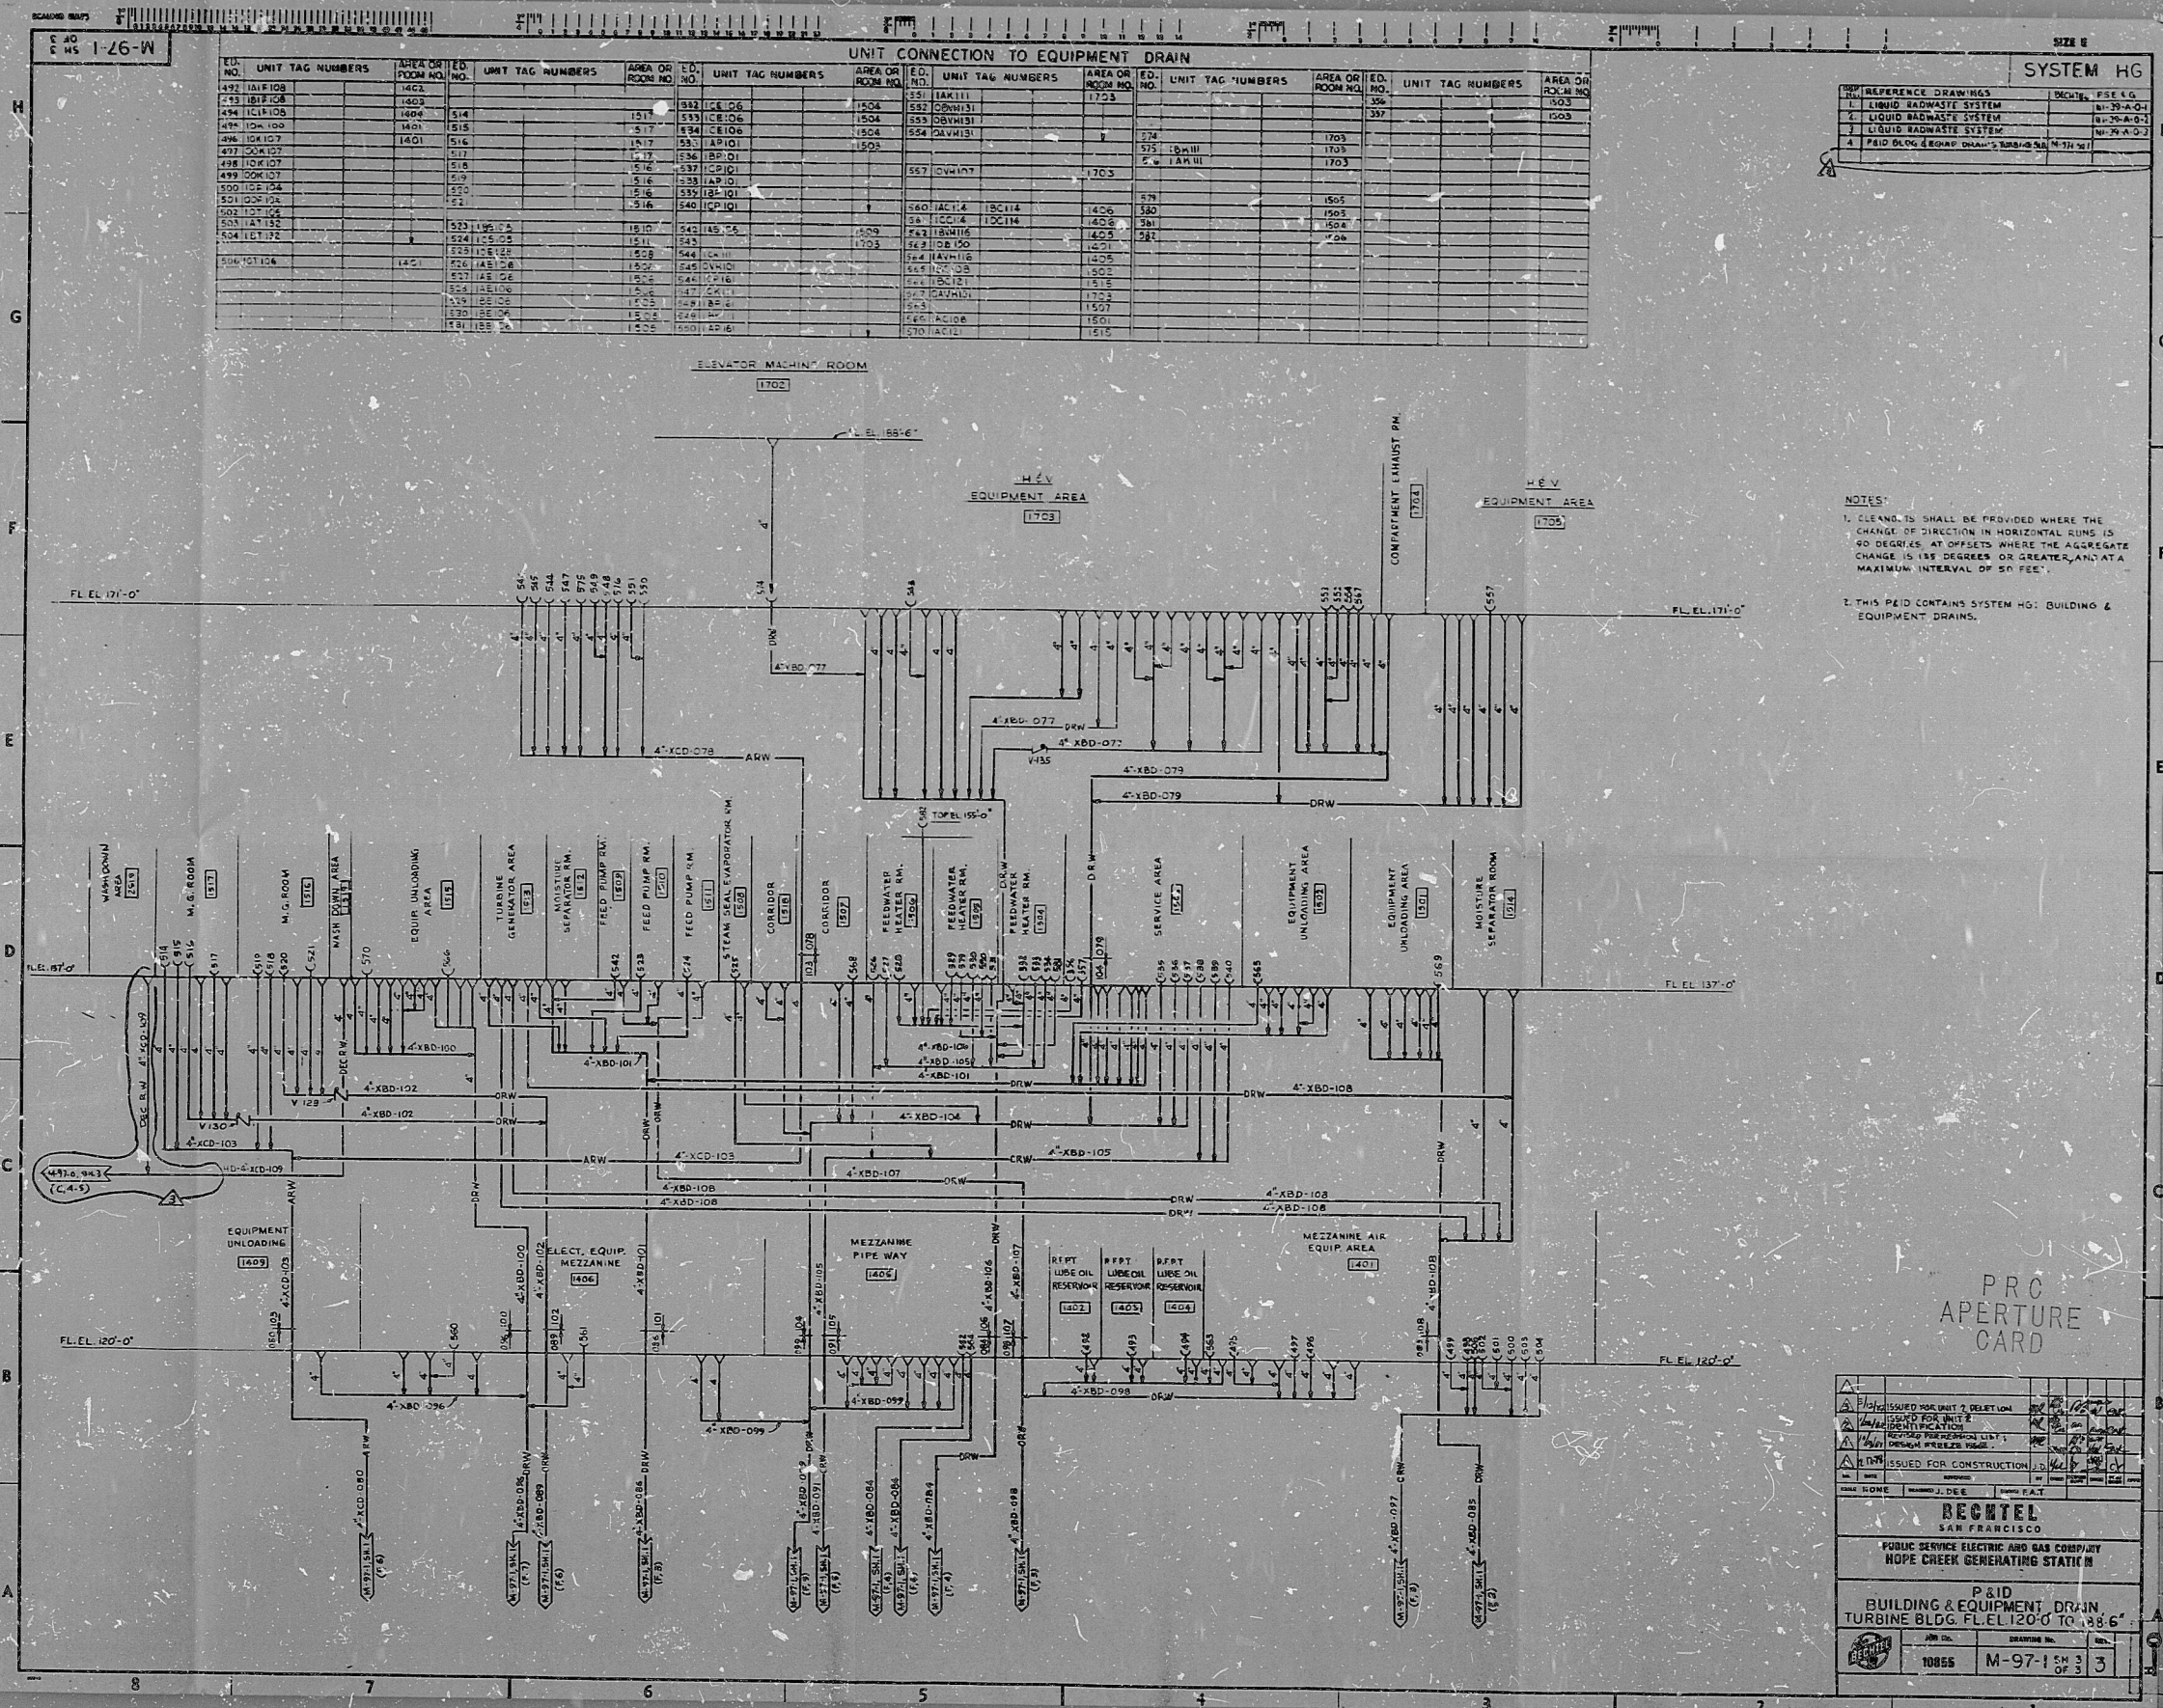

SYSTEM HG	
1	LIQUID WASTEWATER SYSTEM
2	LIQUID WASTEWATER SYSTEM
3	LIQUID WASTEWATER SYSTEM
4	FEED DRAIN (EQUIP. DRAIN) SYSTEM

- NOTES:
1. CLEAN-UP SHALL BE PROVIDED WHERE THE CHANGE OF DIRECTION IN HORIZONTAL LINES IS 90 DEGREES. AT OFFSETS WHERE THE AGGREGATE CHANGE IS 180 DEGREES OR GREATER, AND AT A MAXIMUM INTERVAL OF 50 FEET.
 2. THIS P&ID CONTAINS SYSTEM HG: BUILDING & EQUIPMENT DRAINS.

PRO APERTURE CARD

ISSUED FOR UNIT	

RIDS

8307270219

