


INSERVICE INSPECTION

REV. 18
 BUILDING: REACTOR R-23
 ISO NO: MCFI-2NI-17
 DUKE PIPING CLASS: ASME SECT. III CL.A/B
 SYSTEM SYMBOL: SAFETY INJECTION
 PIPING SPEC: NE-MFS-01.2 NE-175-250.11 NE-225-250.1.2
 DRAWING NO: MC-2414-09.21-00.01 22-00.01
 PROJECT: MCGUIRE

NO.	Q.A. CONDITION	I	REVISION	DATE	BY	CHKD.	APPR.
1	REL FDR CONST. PER V.N. (8592)		5	11/17/83	RR	RR	RR
2	CHANGED MAT. TO SA-312						
3	ADD MATERIAL "C" TO CORRECT MATERIAL I.D. (W/26.2)						
4	CHANGE SPEC. FOR MAT. "D"						

NOTE ONE:
 THIS SYMBOL DENOTES MATERIALS THAT ARE PARTS OF PRE-ASSEMBLED SECTIONS. THEY ARE TO BE USED BY INSPECTOR FOR FIT-UP AND HEAT NUMBER CHECK.
 * DENOTES FLUSH WELDS IAW. CP. 891

NO.	DESCRIPTION	DATE	BY	CHKD.	APPR.
6	ADDED WELD N12F685	11/17/83	RR	RR	RR
7	ADDED WELD N12F749	11/17/83	RR	RR	RR
8	ADD ISO CONT.	11/17/83	RR	RR	RR
9	ADD WELDS 2NI163, 2NI164, 2NI165, 2NI999, 2NI1000				

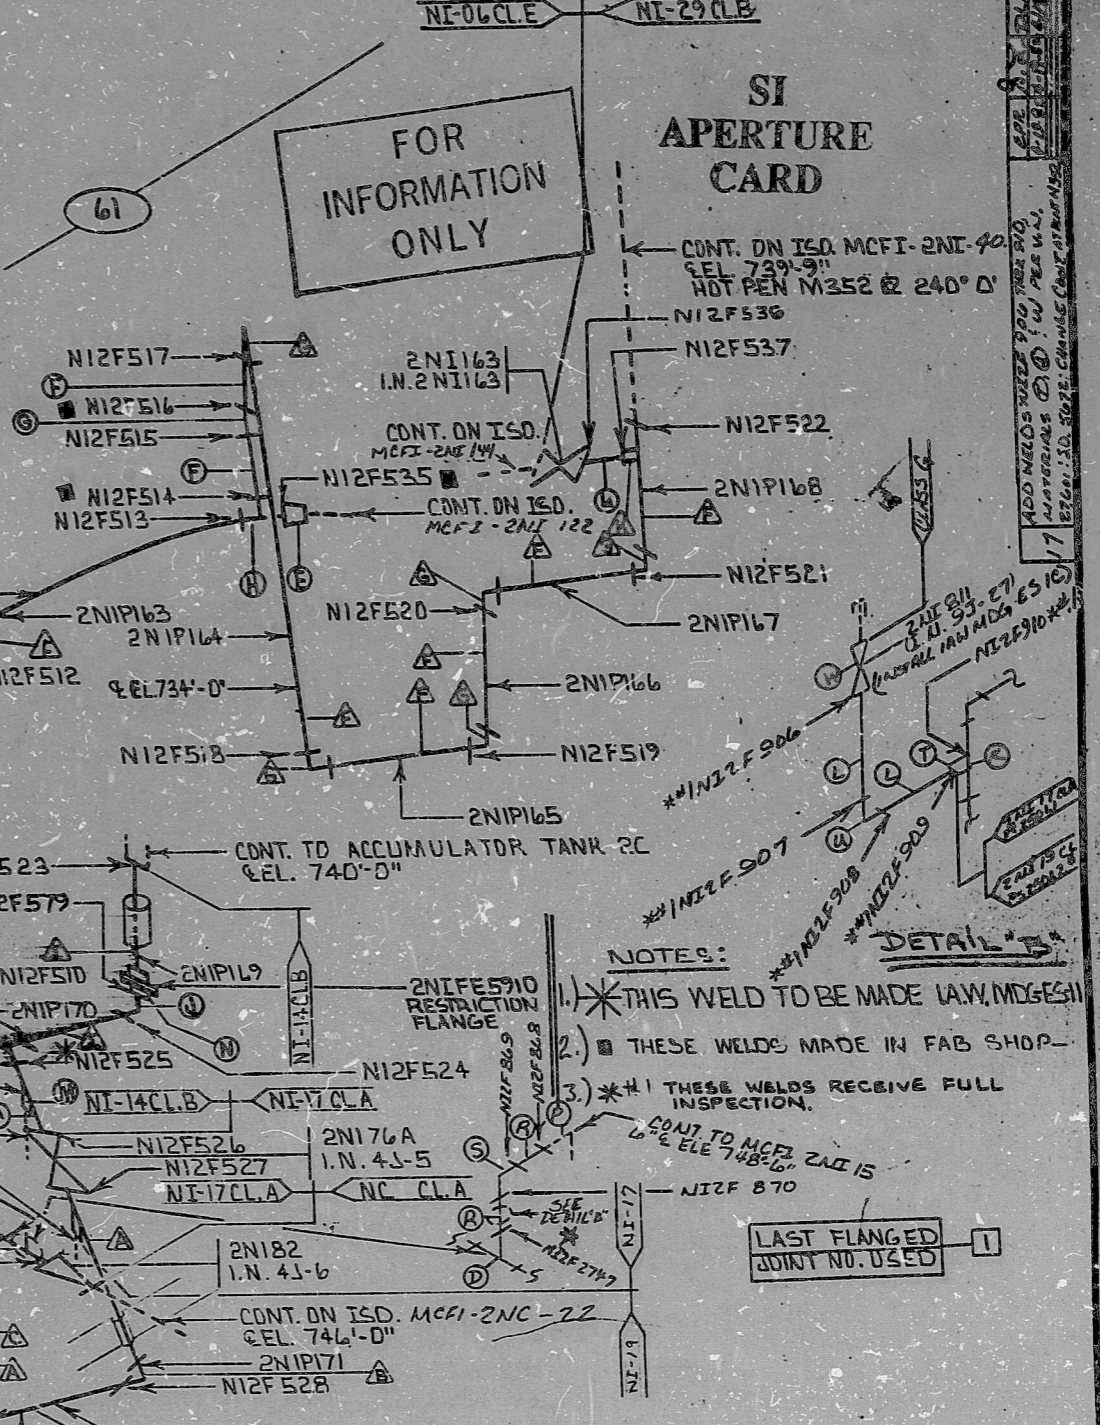

SEE REVERSE

PDR RIDS

