


J-11-0 SHT. 9

TC BC657 CC C-651

LOGIC CABINET BC652

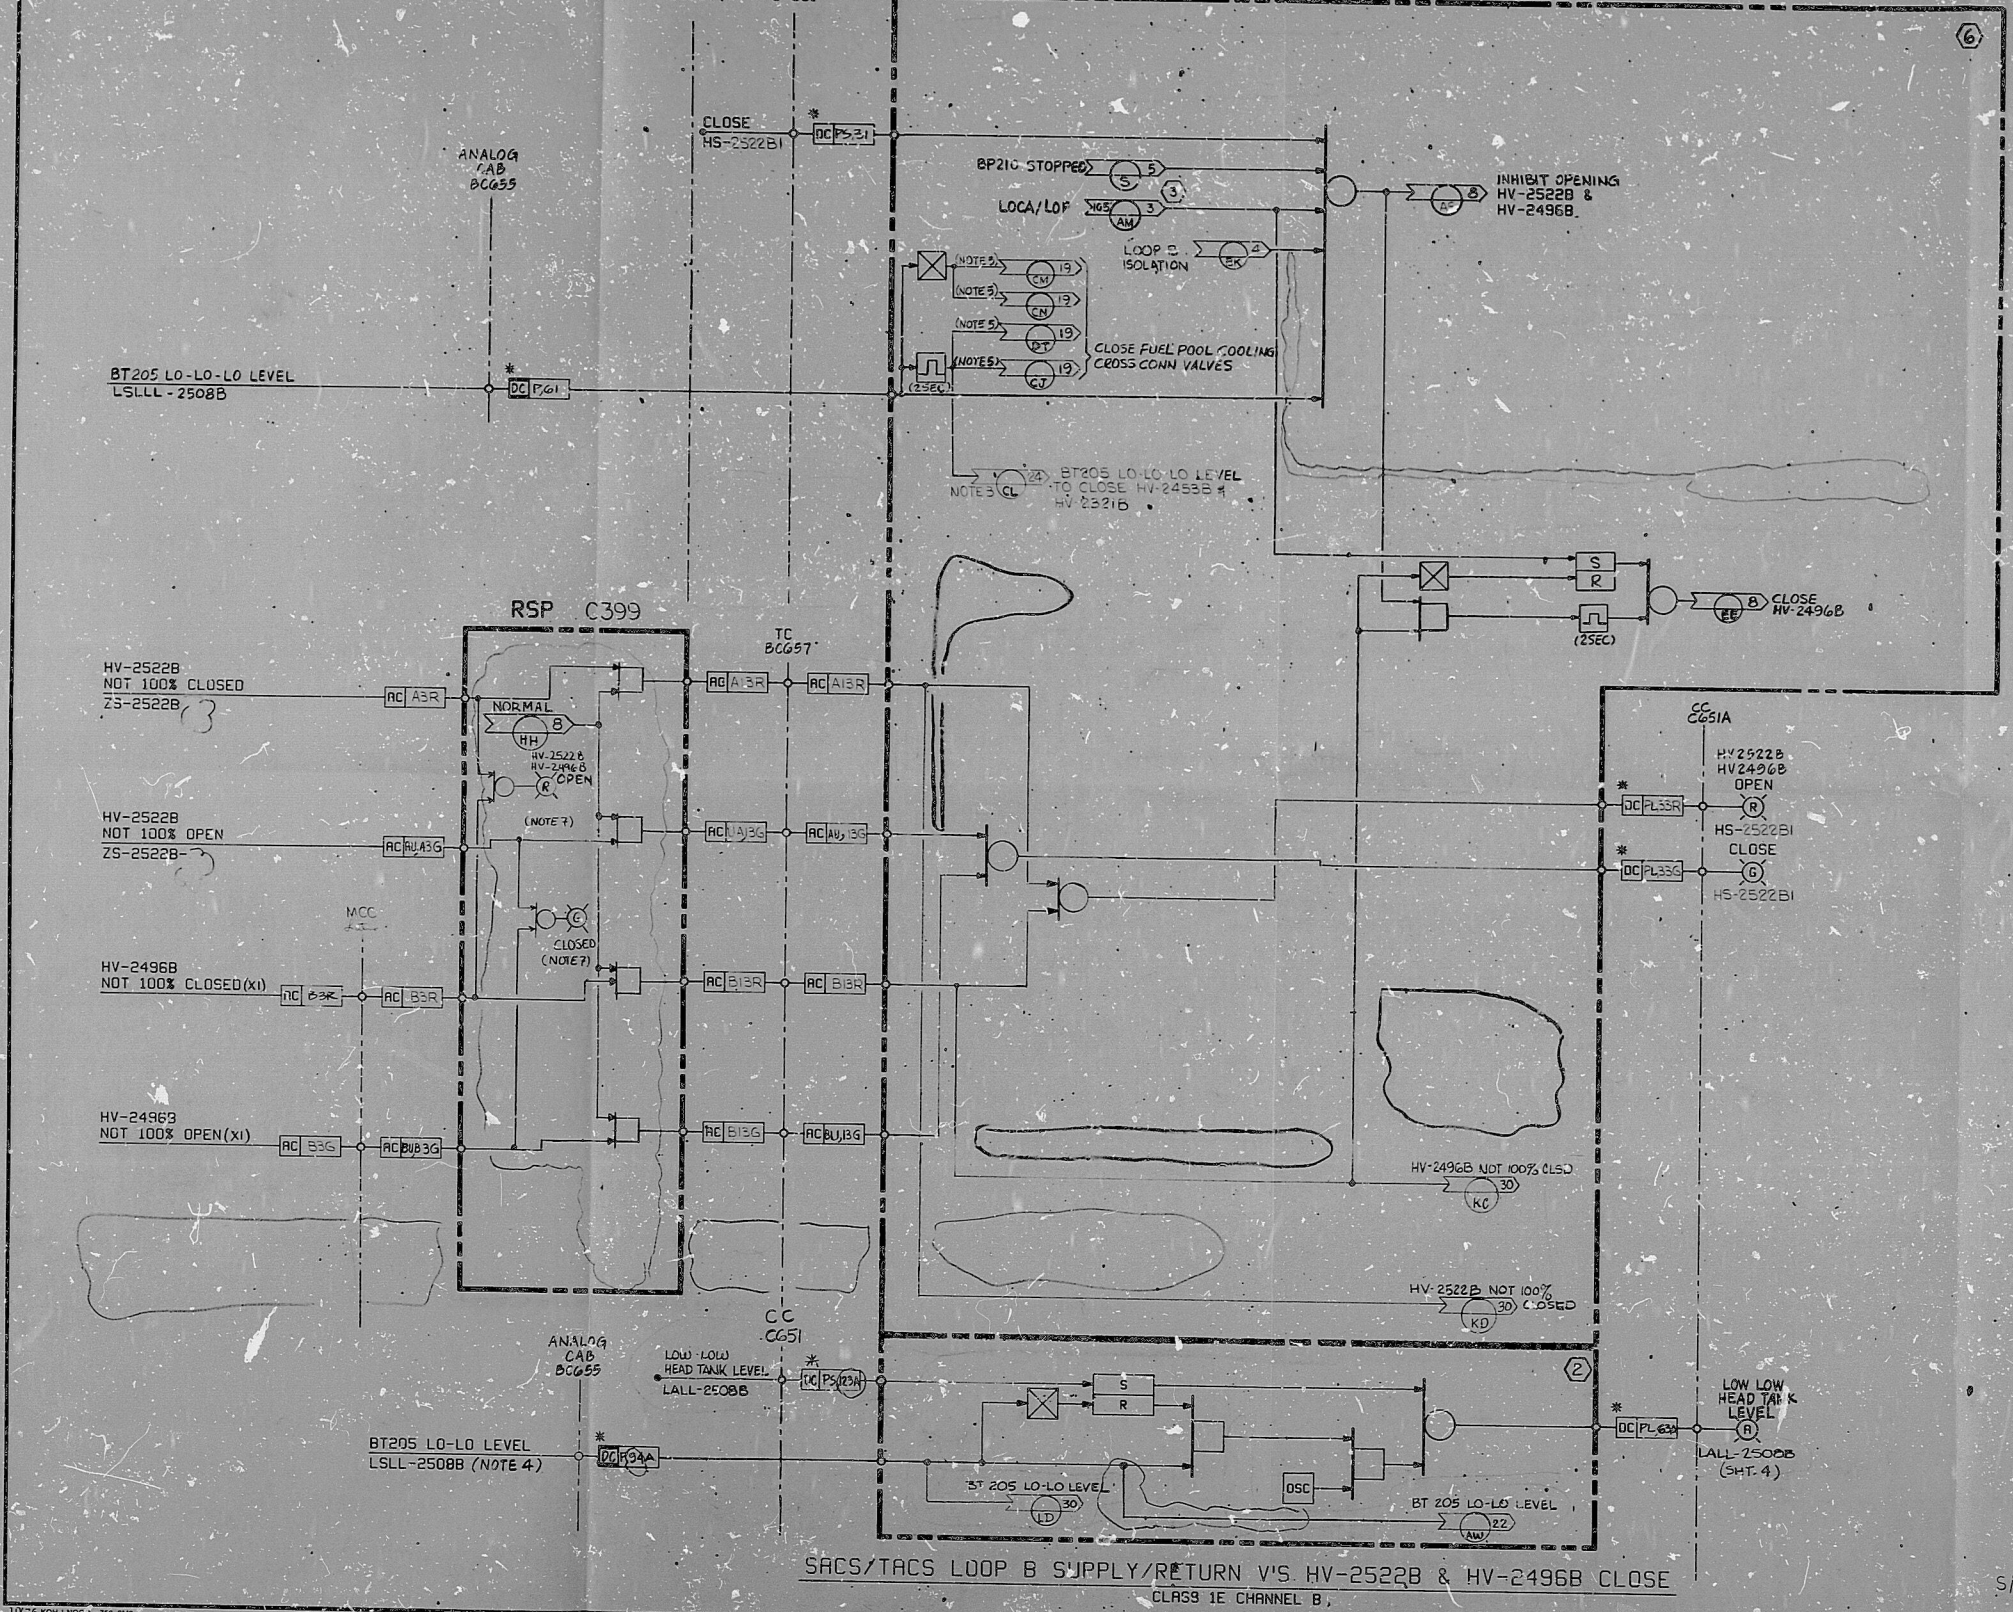

- NOTES:**
1. FOR HV-2522B & HV-2496B OPENING CONTROL SEE SHT. 8 OF THIS DWG.
  2. FOR HAND SW. LAYOUT SEE SHT. 8 OF THIS DWG.
  3. ARROW CL IS APPLICABLE TO HV-2522B & HV-2496B ONLY.
  4. CONTACT OPENS ON CONDITION STATED.
  5. APPLICABLE ONLY TO HV-2522B/HV-2496B.
  6. FOR CROSS REFERENCE TABLE, SEE SHT. 8.
  7. SEE SHT. 8 FOR PICTORIAL OF SWITCH & LIGHTS.

PRO APERTURE CARD

NO.	DATE	REVISIONS	BY	CHKD	DESIGN	ENGR	PROJ	APPR
1	3/16/77	DESIGN/FREEZE ISSUE	SF	DD	DP	GR		
2	7/17/77	REVISED RAILBY INTERFERENCE AS NOTED						
3	11/17/77	INC. DCN'S #1 & #3 INC. I-105-0, DCN #3	DR	LA	CH	GR		
4	1/5/79	REVISED AS NOTED						
5	3/16/77	ISSUED FOR CONSTRUCTION						

SCALE	DESIGNED	CHKD	ENGR	PROJ	APPR
NONE	I.J.L.		RCG		

**BECHTEL**  
SAN FRANCISCO

PUBLIC SERVICE ELECTRIC AND GAS COMPANY  
HOPE CREEK GENERATING STATION

LOGIC DIAGRAM  
SAFETY AUXILIARIES COOLING  
SACS/TACS LOOP B SUPPLY/RETURN V/S CLOSE

JOB No.	DRAWING No.	REV.
10855	J-11-0 SHT. 9	4

This drawing and the design it covers are the property of BECHTEL. They are hereby loaned and on the borrower's express agreement that they will not be reproduced, copied, loaned, exhibited, nor used except in the limited way and private use permitted by any written consent given by the lender to the borrower.

22"  
17"  
11"  
8.5"  
9.5"  
11"  
17"  
22"

22"  
17"  
11"  
8.5"  
11"  
17"  
22"

S/U-EG



RIDS

8307270367

