


This drawing and the design it covers are the property of BECHTEL. They are hereby loaned and on the borrower's express agreement that they will not be reproduced, copied, loaned, exhibited, nor used except in the limited way and under the conditions permitted by the lender to the borrower.

- NOTES:**
1. SEE SHIT 4 FOR PICTORIAL OF SWITCHES & LIGHTS
 2. SEE SHIT 8 FOR PICTORIAL OF LIGHTS.

PRC APERTURE CARD

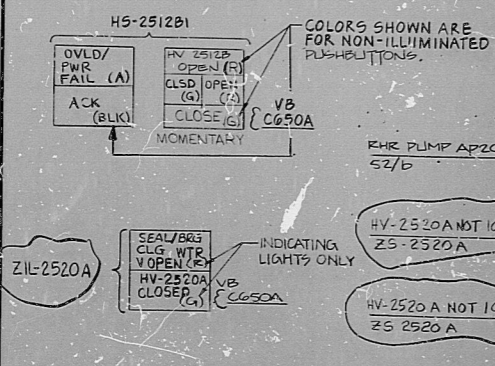

CROSS REFERENCE TABLE

PUMP NO.	SWGR NO.	SOLENOID VLV	CLG WATER SUPPLY VLV	CLASS I/E CHANNEL	TC	CIRCUIT NO	SEAL/BRG VLV OPEN LIGHT
AP202	A 401	SV-2520A	HV-2520A	A	AC657	19	ZIL-2520A
CP202	A 403	SV-2520C	HV-2520C	C	CC657	21	ZIL-2520C
DP202	A 404	SV-2520D	HV-2520D	D	DC657	22	ZIL-2520D

NO.	DATE	REVISIONS	BY	CHKD	DESIGN	APPV

BECHTEL
SAN FRANCISCO

PUBLIC SERVICE ELECTRIC AND GAS COMPANY
HOPE CREEK GENERATING STATION

LOGIC DIAGRAM
SAFETY AUXILIARIES COOLING

RHR HX BE 205 OUTLET VALVE SEAL & BRG CLG WTR SUPPLY V

JOB No.	DRAWING No.	REV.
10855	J-11-0 SHT 16	4

S/U-EG

10776 NON-NORM-750 280

RIDS

8307270381

